

BOUNDARY DESCRIPTION



All of Lot 36, Green Hill Country Estates Phase No. 2, Weber County, Utah.

NARRATIVE

This survey was performed at the request of Taran Tolton for the purpose of identifying the boundary as it exist on the ground.
 Green Hill Country Estates Phase No. 2 was rotated to current Section Line bearings.
 Basis of Bearing is a line bearing S 89°05'17" E between the South 1/4 and the Southeast Corners of Section 9, T6N, R2E, SLB&M

SURVEYOR'S CERTIFICATE

I, Tyler D. Knight, do hereby certify that I am a professional land surveyor in the State of Utah and hold certificate no. 9008384-2201 as prescribed by the laws of this State. That I have made a survey of the property(s) shown hereon in accordance with UCA 17-23-17. That this plat was prepared from the field notes of this survey and from documents and records as noted hereon.

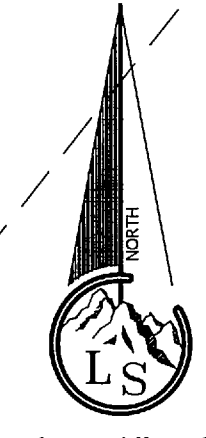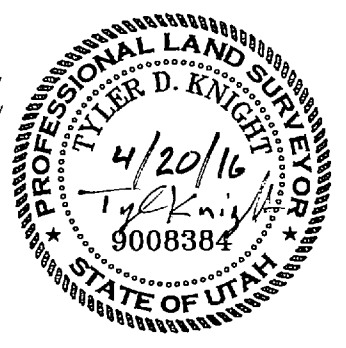

Scale ~ 1" = 30'

Legend

- x---x--- EXISTING FENCE
- EASEMENTS
- STREET CENTERLINE
- ◆ FND SECTION CORNER
- FND STREET MONUMENT
- FND CURB NAIL
- FND REBAR AND CAP
- SET #5x24" REBAR AND CAP STAMPED LANDMARK

RECEIVED
 JUL 11 2016
 BY: 5493

Landmark Surveying, Inc.
 A Complete Land Surveying Service
 www.LandmarkSurveyingUtah.com
 4646 South 3500 West - #A-3
 West Haven, UT 84401
 801-731-4075

CLIENT: Taran Tolton
 Lot 36, Green Hill Country Estates Phase No. 2

| | |
|--|-----------------|
| Parcel ID No 21-059-0004 NW 1/4 of Section 9, Township 6 North, Range 2 East, Salt Lake Base and Meridian. | DRAWN BY: TDK |
| Revisions: | CHECKED BY: TDK |
| | DATE: 4-11-16 |
| | FILE: 3610 |

Boundary & Topography Survey SHEET 1