


Record of Survey for McLEAN SUBDIVISION

PART OF THE SW 1/4 OF SECTION 16, TOWNSHIP 6 NORTH, RANGE 2 WEST, SALT LAKE BASE & MERIDIAN
UNINCORPORATED WEBER COUNTY, UTAH - Date of Survey: December 2015

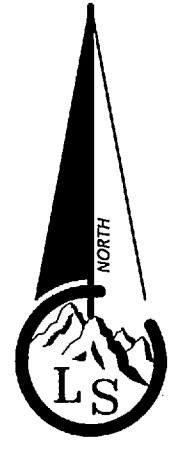

Scale ~ 1" = 40'
0 40 80

Legend

- - - - - EXISTING FENCE
- - - - - EASEMENTS
- - - - - STREET CENTERLINE
- ◆ FND SECTION CORNER
- SET MAG NAIL
- FND REBAR AND CAP
- SET #5x24" REBAR AND CAP STAMPED LANDMARK
- ▨ ROAD/STREET DEDICATION


NOTE:

1. Agriculture is the preferred use in the agricultural zones. Agricultural operations as specified in the Land Use Code for a particular zone are permitted at any time including the operation of farm machinery and no allowed agricultural use shall be subject to restriction on the basis that it interferes with activities of future residents of this subdivision. [Amr. Ord. Sec. 106-1-8(c)(5)]
2. Lower Valley Coordinate system is NAD1927 U.S.ft expanded to ground using a combined factor of 1.002520877833. The initial coordinates are based on the published values of the Weber County Surveyor's Office.
3. Due to the topography and the location of this subdivision all owners will accept responsibility for any storm water runoff from the road adjacent to this property until curb and gutter is installed.
4. Perc Test Pit 1: 0-25" sandy loam, granular structure; 25-64" sandy clay loam, massive structure. Soil is moist up to 25 inches Observed ground water @ 64"

NARRATIVE

1. The purpose of the survey is to create a one lot plot as shown hereon.
2. The basis of bearing is as described in the description.
3. The boundaries of the subdivision are based on the location that the owner desired which leaves a 50 foot area on the north between the house to the north and the new lines of this subdivision for access to the farm and possible development at a future time.
4. The south boundary is identified as the center line of the Hooper Canal as recorded in Plat book 71 page 27 of the county records. This easement does not show a width on the plat, however, the easement being shown to be 50 feet from the south line is wide enough to accommodate the canal and the field drainage ditch that is in use on the south of the property.
5. The east boundary is the east boundary of Government Lot 20. This boundary has been retraced from the recorded Plat book 6 page 72. Section 16 was granted to the State of Utah as School Trust Land Section and this plat was done as a fence line survey of the occupied lands in 1898 by Washington Jenkins and recorded Nov. 20, 1899. It was produced so that the State could issue title to the lands as occupied.
6. The plat has been rotated and translated to match as best possible the existing fence evidences relating to the lot locations for this area of the section. It was found that no single location for the plat will fit all of the occupation within this section, so each area of the section may require a separate rotation and translation.
7. Monumentation for the section and found rebar of prior surveys as shown and noted.
8. Documents used or reviewed in this survey are, but not limited to, the following:
 - 8.1. Ownership sheets and Abstracts from Weber County Recorder's electronic document access for Parcel no.'s; 15-046-0009, 15-046-0012, 15-046-0013, 15-046-0014, 15-046-0015.
 - 8.2. Recorder Ownership Plats; book 15 page 046, book 15 page 46-1, book 15 page 46-2.
 - 8.3. Deeds of record by Entry no; 921490, 946665, 946666, 946667, 951264, 969241, 974932, 1030086, 1204172, 1265846, 1265847, 1449136, 1481373, 1495275, 1495276, 1495277, 1554133, 2268996, 2268998, 2622257, 2622258.
 - 8.4. Record of Survey plats file numbers; 1195, 2348, 3577.
 - 8.5. Subdivision plats of record by Plat book-page; 6-72, 55-25, 58-80, 71-27, 71-28, 77-83.
 - 8.6. County Surveyor monument tie sheets for WC-11 (BM62120-1-5011), W1/4 Sec 16 (no. 1819 or No.136), S1/4 Sec 16 (no. 17-20), SW Sec 16 (no. 1719).

15-046-0013
Robert & Elaine McLean Living Trust, dated Aug. 27, 1996
Remainder Parcel
Not approved for Development

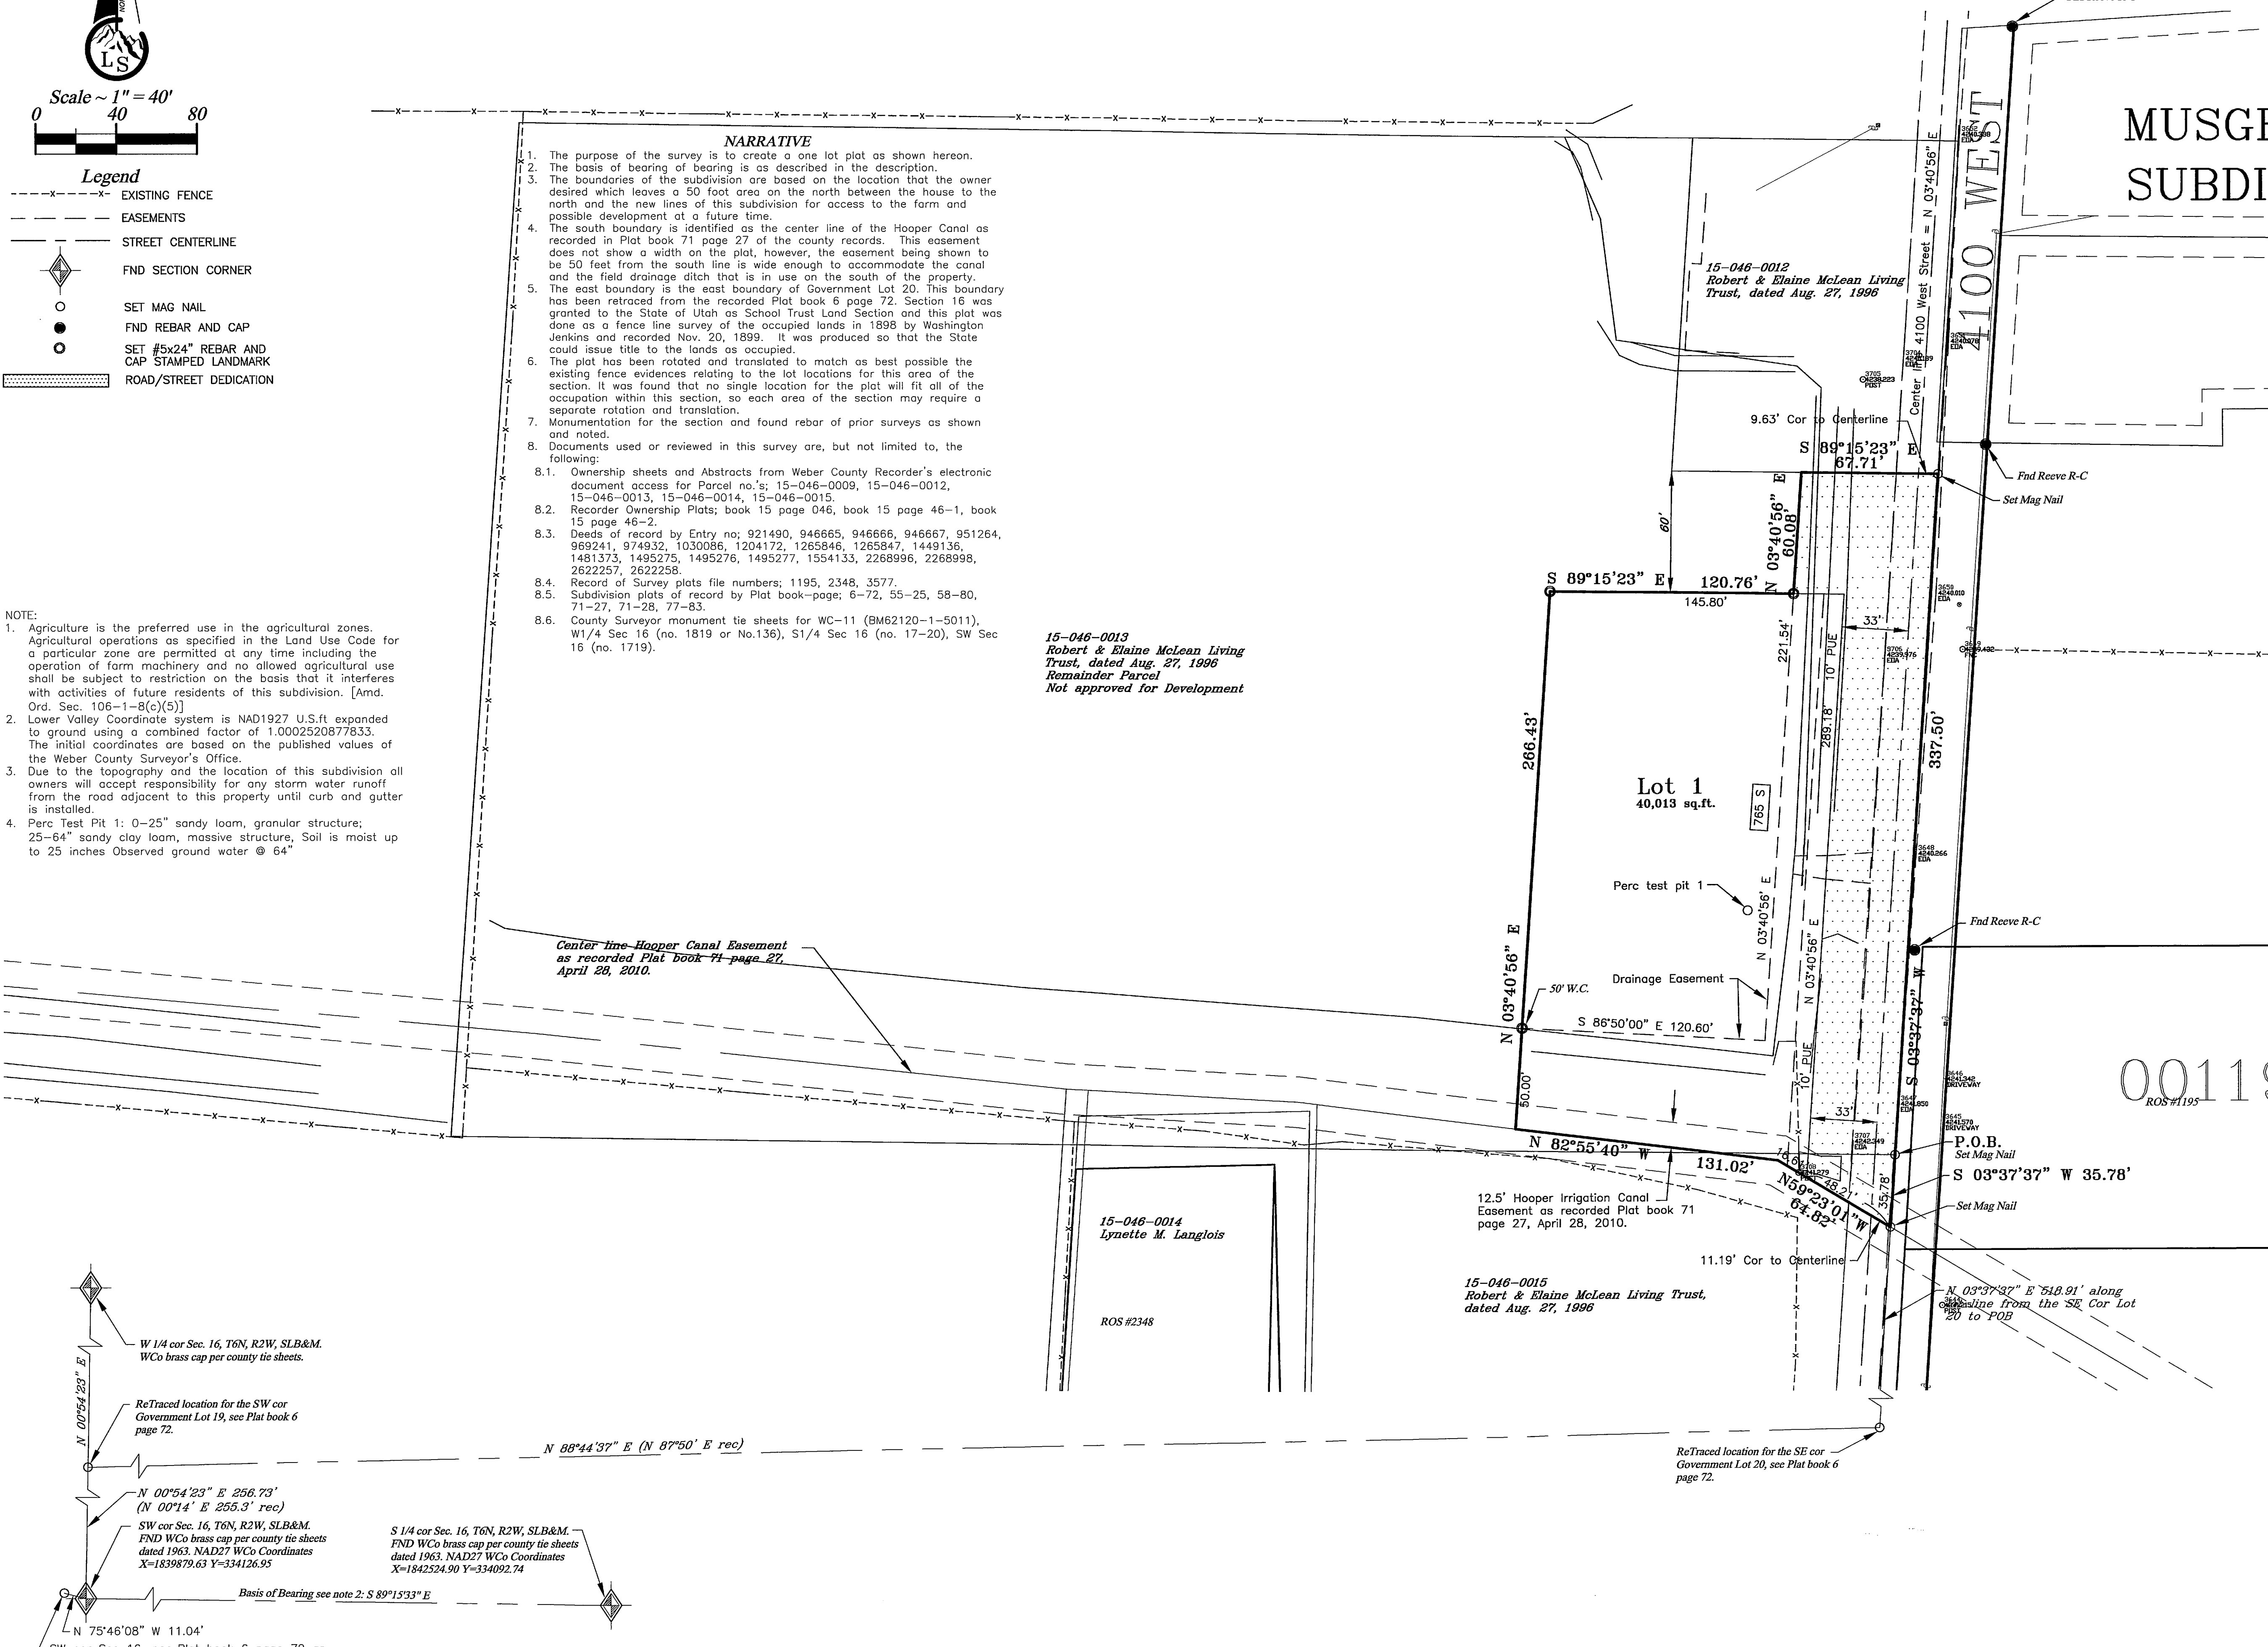


BOUNDARY DESCRIPTION

A tract of land being part of government Lot 20, Section 16, Township 6 North, Range 2 West, Salt Lake Base and Meridian, said tract having a basis of bearing of S 89°15'23" E Between the monumented locations of the Southwest corner (WCo NAD27 State Plane Coordinates X=1839879.63 Y=334126.95) and the South Quarter corner (WCo NAD27 State Plane Coordinates X=1842524.90 Y=334092.74) of said Section 16, said tract more particularly described as follows:
BEGINNING at a point on the east boundary of said Lot 20 at the southeast corner of property described in Quit Claim Deed Entry no. 1495277 Book 1883 page 597 recorded Sept. 29, 1997, said point being located by survey the following three (3) courses; 1) 256.73 feet North 00°54'23" East along section line to the Southwest corner of government Lot 19 as shown on Plat book 6 page 72 recorded Nov. 20, 1899, 2) 1395.07 feet North 88°44'37" East along the south line of Lots 19 and 20 said plat to the Southeast corner of said Lot 20, 3) 518.91 feet North 03°37'37" East along the east boundary of said Lot 20, FROM said Southwest corner of Section 16, RUNNING thence South 03°37'37" West 35.78 feet to the center of an easement for the Hooper Canal - West Weber Canal South Branch shown on Sheet 12 recorded Plat book 71 page 27 on April 28, 2010; Thence North 59°23'01" West 64.82 feet along the center line of said canal easement; Thence North 82°55'40" West 131.02 feet along the center line of said canal easement; Thence leaving said canal easement, North 03°40'56" East 266.43 feet; Thence South 89°15'23" East 120.76 feet; Thence North 03°40'56" East 60.08 feet; Thence South 89°15'23" East 67.71 feet to the East boundary of said Lot 20; Thence South 03°37'37" West 337.50 feet along said East boundary of Lot 20 to the point of beginning. Containing 1.3080 acres, more or less.

SURVEYOR'S CERTIFICATE


I, Ernest D. Rowley, do hereby certify that I am a professional land surveyor in the State of Utah and hold license no. 171781-2201 in accordance with Title 58, Chapter 22 known as the Professional Engineers and Professional Land Surveyor's Licensing Act, have made a survey of the property(s) shown hereon in accordance with UCA 17-23-17, verifying measurements, and placing monuments as represented. That this plat was prepared from the field notes of this survey and from documents and records as noted hereon. I further certify that, to the best of my knowledge and belief, all lots meet the current requirements of the Land Use Ordinance of Weber county.

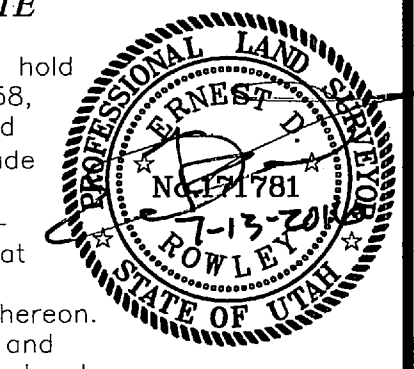

00119

ROS #1195

RECEIVED
AUG 03 2016
BY: 5514

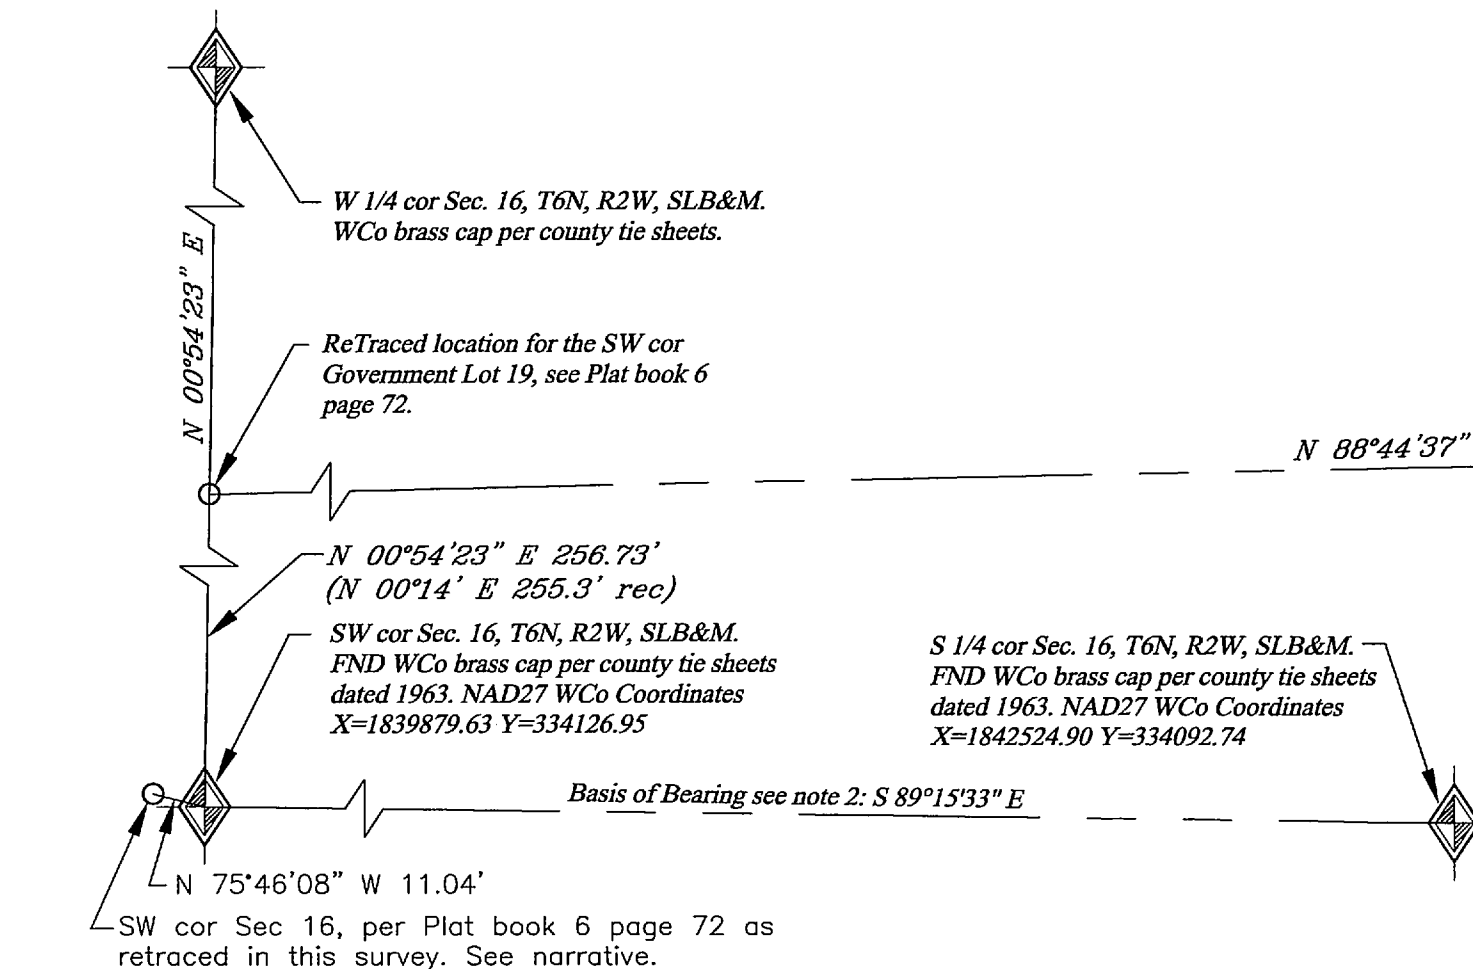

Landmark Surveying, Inc.
A Complete Land Surveying Service
www.LandmarkSurveyUtah.com

4646 South 3500 West - #A-3
West Haven, UT 84401
801-731-4075

DEVELOPER: Robert & Elaine McLean
Address: 721 North 4100 West, Ogden, Utah 84404

SW 1/4 of Section 16,
Township 6 North, Range 2 West, Salt Lake Base and Meridian.

Revisions	DRAWN BY: EDR
	CHECKED BY: ...
	DATE: January 16, 2016
	FILE: 3577