


FOUND 0.3" BRASS CAP WITH PUNCH POINT MONUMENT IN RING AND LID AT INTERSECTION OF 5300 NORTH STREET AND 3350 EAST STREET

FOUND HANSEN REBAR AND CAP AT LOT CORNER

FOUND 0.3" BRASS CAP WITH PUNCH POINT MONUMENT IN RING AND LID AT CENTER OF 5300 NORTH STREET CUL-DE-SAC

SET MA G NAIL ON TOP NORTHERLY EASTERLY FENCE

SET MA G NAIL ON TOP POST EASTERLY FENCE

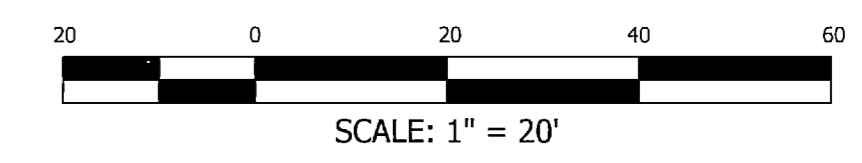

**CERTIFICATE**

I, VON R. HILL, A PROFESSIONAL LAND SURVEYOR ACCORDING TO THE LAWS OF THE STATE OF UTAH, DO CERTIFY THAT I HAVE SURVEYED THE PARCEL OF GROUND SHOWN HEREON ACCORDING TO UTAH STATE CODE 17-23-17.



**DESCRIPTION**

LOT 24 WILLOW CREEK SUBDIVISION-PHASE 2 PART OF SECTION 8, TOWNSHIP 7 NORTH, RANGE 1 EAST, SALT LAKE BASE AND MERIDIAN.

CONTAINS 0.935 ACRES

**NARRATIVE**


THE PURPOSE OF THE SURVEY WAS TO MARK THE PROPERTY CORNERS. THE BASIS OF BEARING WAS DETERMINED USING THE MONUMENTS SHOWN.

RECEIVED  
SEP 06 2016  
BY: 5568

**LEGEND**

PROPERTY LINE	—————
ADJACENT PROPERTY	-----
ROAD CENTERLINE	-----
SECTION LINE	-----
TIE TO MONUMENT	-----
EASEMENT LINE	-----
EDGE OF PAVEMENT	-----
CURB, GUTTER, SIDEWALK	-----
FENCE LINE	-----
WALL	-----
RECORD CALLS ( )	
SET 5/8" REBAR WITH H&A CAP, LS #166385, AT CORNER (UNLESS OTHERWISE NOTED)	●
FOUND PROPERTY MARKER (AS NOTED)	○

181 North 200 West, Suite #4  
Bountiful, Utah 84010  
Phone 801-298-2236  
Fax 801-298-5983

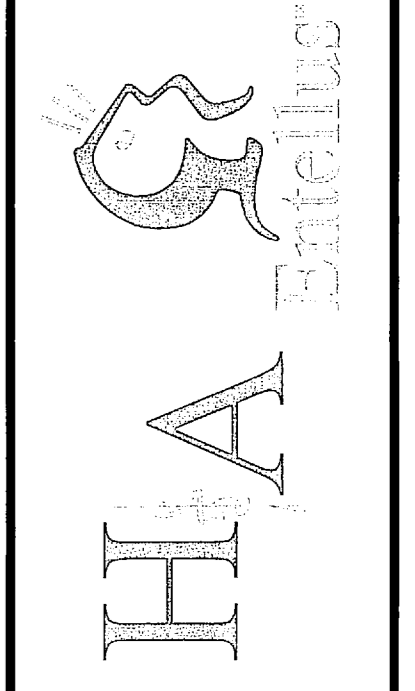

BOUNDARY SURVEY  
**MARTINEAU HOMES**

3383 EAST 5300 NORTH  
LOT 24 WILLOW CREEK SUBDIVISION PHASE 2  
LOCATED IN THE SW 1/4 OF SECTION 8, T.7N., R.1E., S.L.R.&M.  
WEBER COUNTY, UTAH

DRAWN BY	JH	DATE	07/05/2015
APPROVED	VRH	DATE	
REV.	BY	DATE	
SHEET			
C201			
SHEET NAME			
BOUNDARY			
DRAWING NAME			
1022008 TOPO.dwg			
PROJECT NO.			
1022008			