

COURTESY ENGINEERING CO. 11888

West 1/4 corner of Section 18  
T.5N., R.2W., S.L.B. & M.  
(Brass Cap)

NW corner of the NW 1/4 of  
Section 18, T.5N., R.1W., S.L.B. & M.  
(Brass cap)

**PARCEL 1**  
DESCRIPTION FOR OVERALL CHURCH PARCEL

A part of the Northwest Quarter of Section 18, Township 5 North,  
Range 2 West, Salt Lake Base and Meridian, U.S. Survey:  
Beginning at a point in 5100 South Street said point being 1716.00 feet  
South from the Northwest corner of said Section 18,  
442.86 feet; thence North 0°19'11" East 693.00 feet; thence South 18°40'49" East  
114.00 feet; thence South 0°19'11" West 160.00 feet; thence North 89°40'49" East  
150.00 feet; thence South 0°19'11" West 160.00 feet; thence  
North 89°40'49" West 114.00 feet to the point of beginning.

**PARCEL 2**  
DESCRIPTION OF PARCEL FROM SMITH TO CHURCH

A part of the Northwest Quarter of Section 18, Township 5 North,  
Range 2 West, Salt Lake Base and Meridian, U.S. Survey:  
Beginning at a point in 5100 South Street said point being 1716.00 feet  
South from the Northwest corner of said Section 18,  
516.22 feet; thence North 0°19'11" East 160.00 feet; thence South 18°40'49" East  
40.64 feet; thence North 0°19'11" West 160.00 feet; thence  
North 89°40'49" West 40.64 feet to the point of beginning.

**PARCEL 3**  
DESCRIPTION OF PARCEL FROM CHURCH TO SMITH

A part of the Northwest Quarter of Section 18, Township 5 North,  
Range 2 West, Salt Lake Base and Meridian, U.S. Survey:  
Beginning at a point in 5100 South Street said point being 1716.00 feet  
South from the Northwest corner of said Section 18,  
666.22 feet; thence North 0°19'11" East 160.00 feet; thence South 18°40'49" East  
40.64 feet; thence North 0°19'11" West 160.00 feet; thence  
North 89°40'49" West 40.64 feet to the point of beginning.



**PARCEL 4**  
DESCRIPTION OF OVERALL SMITH PARCEL

A part of the Northwest Quarter of Section 18, Township 5 North,  
Range 2 West, Salt Lake Base and Meridian, U.S. Survey:  
Beginning at a point in 5100 South Street said point being 1716.00 feet  
South from the Northwest corner of said Section 18,  
556.86 feet; thence North 0°19'11" East 160.00 feet; thence South 18°40'49" East  
150.00 feet; thence South 0°19'11" West 160.00 feet; thence  
North 89°40'49" West 150.00 feet to the point of beginning.

**CERTIFICATION**

I, Gary L. Newman, do hereby certify that I am a Registered Land  
Surveyor, and that I hold Certificate No. 4778, as prescribed by the Laws of  
the State of Utah, and I have made a survey of the above described property,  
and the property shown on this drawing.

Date: 5/16/91

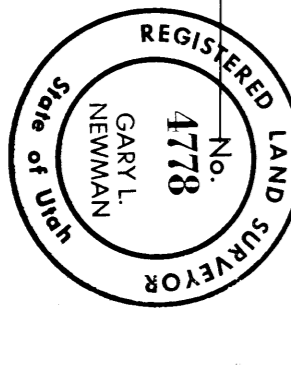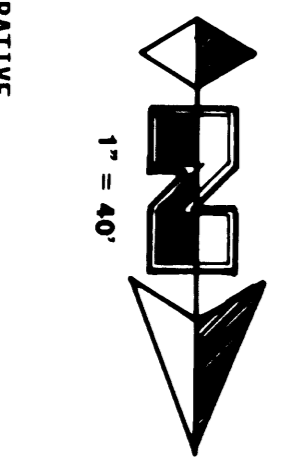

**NARRATIVE**  
This survey was requested by Mr. Scott Thompson in behalf of the  
Hooper Stake of the L.D.S. Church in order to determine the location of the  
Section in relation to existing occupation. The West Line of the Quarter  
Section was used as the basis of Bearings. Property Corners were monumented  
as depicted on this drawing.

RECEIVED  
JUL 0 9 1991

13 January 1988

**GREAT BASIN ENGINEERING, INC.**  
CONSULTING ENGINEERS & SURVEYORS  
ODDEN & SALT LAKE CITY, UTAH

**OCCUPATION SURVEY FOR L.D.S. CHURCH HOOPER STAKE**  
A part of the NW 1/4 of Section 18, T.5N., R.2W., S.L.B. & M. Salt Lake U.S. Survey