

00000

BOUNDARY DESCRIPTION



SURVEYOR'S CERTIFICATE

I, CHESTER L. NELSON DO HEREBY CERTIFY THAT I AM A REGISTERED LAND SURVEYOR, AND THAT I HAVE PERSONALLY EXAMINED THE PLAT AND THE RECORDS OF THE WEBER COUNTY RECORDERS OFFICE AND AS DESCRIBED ABOVE AND SHOWN PER THIS PLAT.


DATE

CHESTER L. NELSON
R.L.S. No. 4263



NARRATIVE


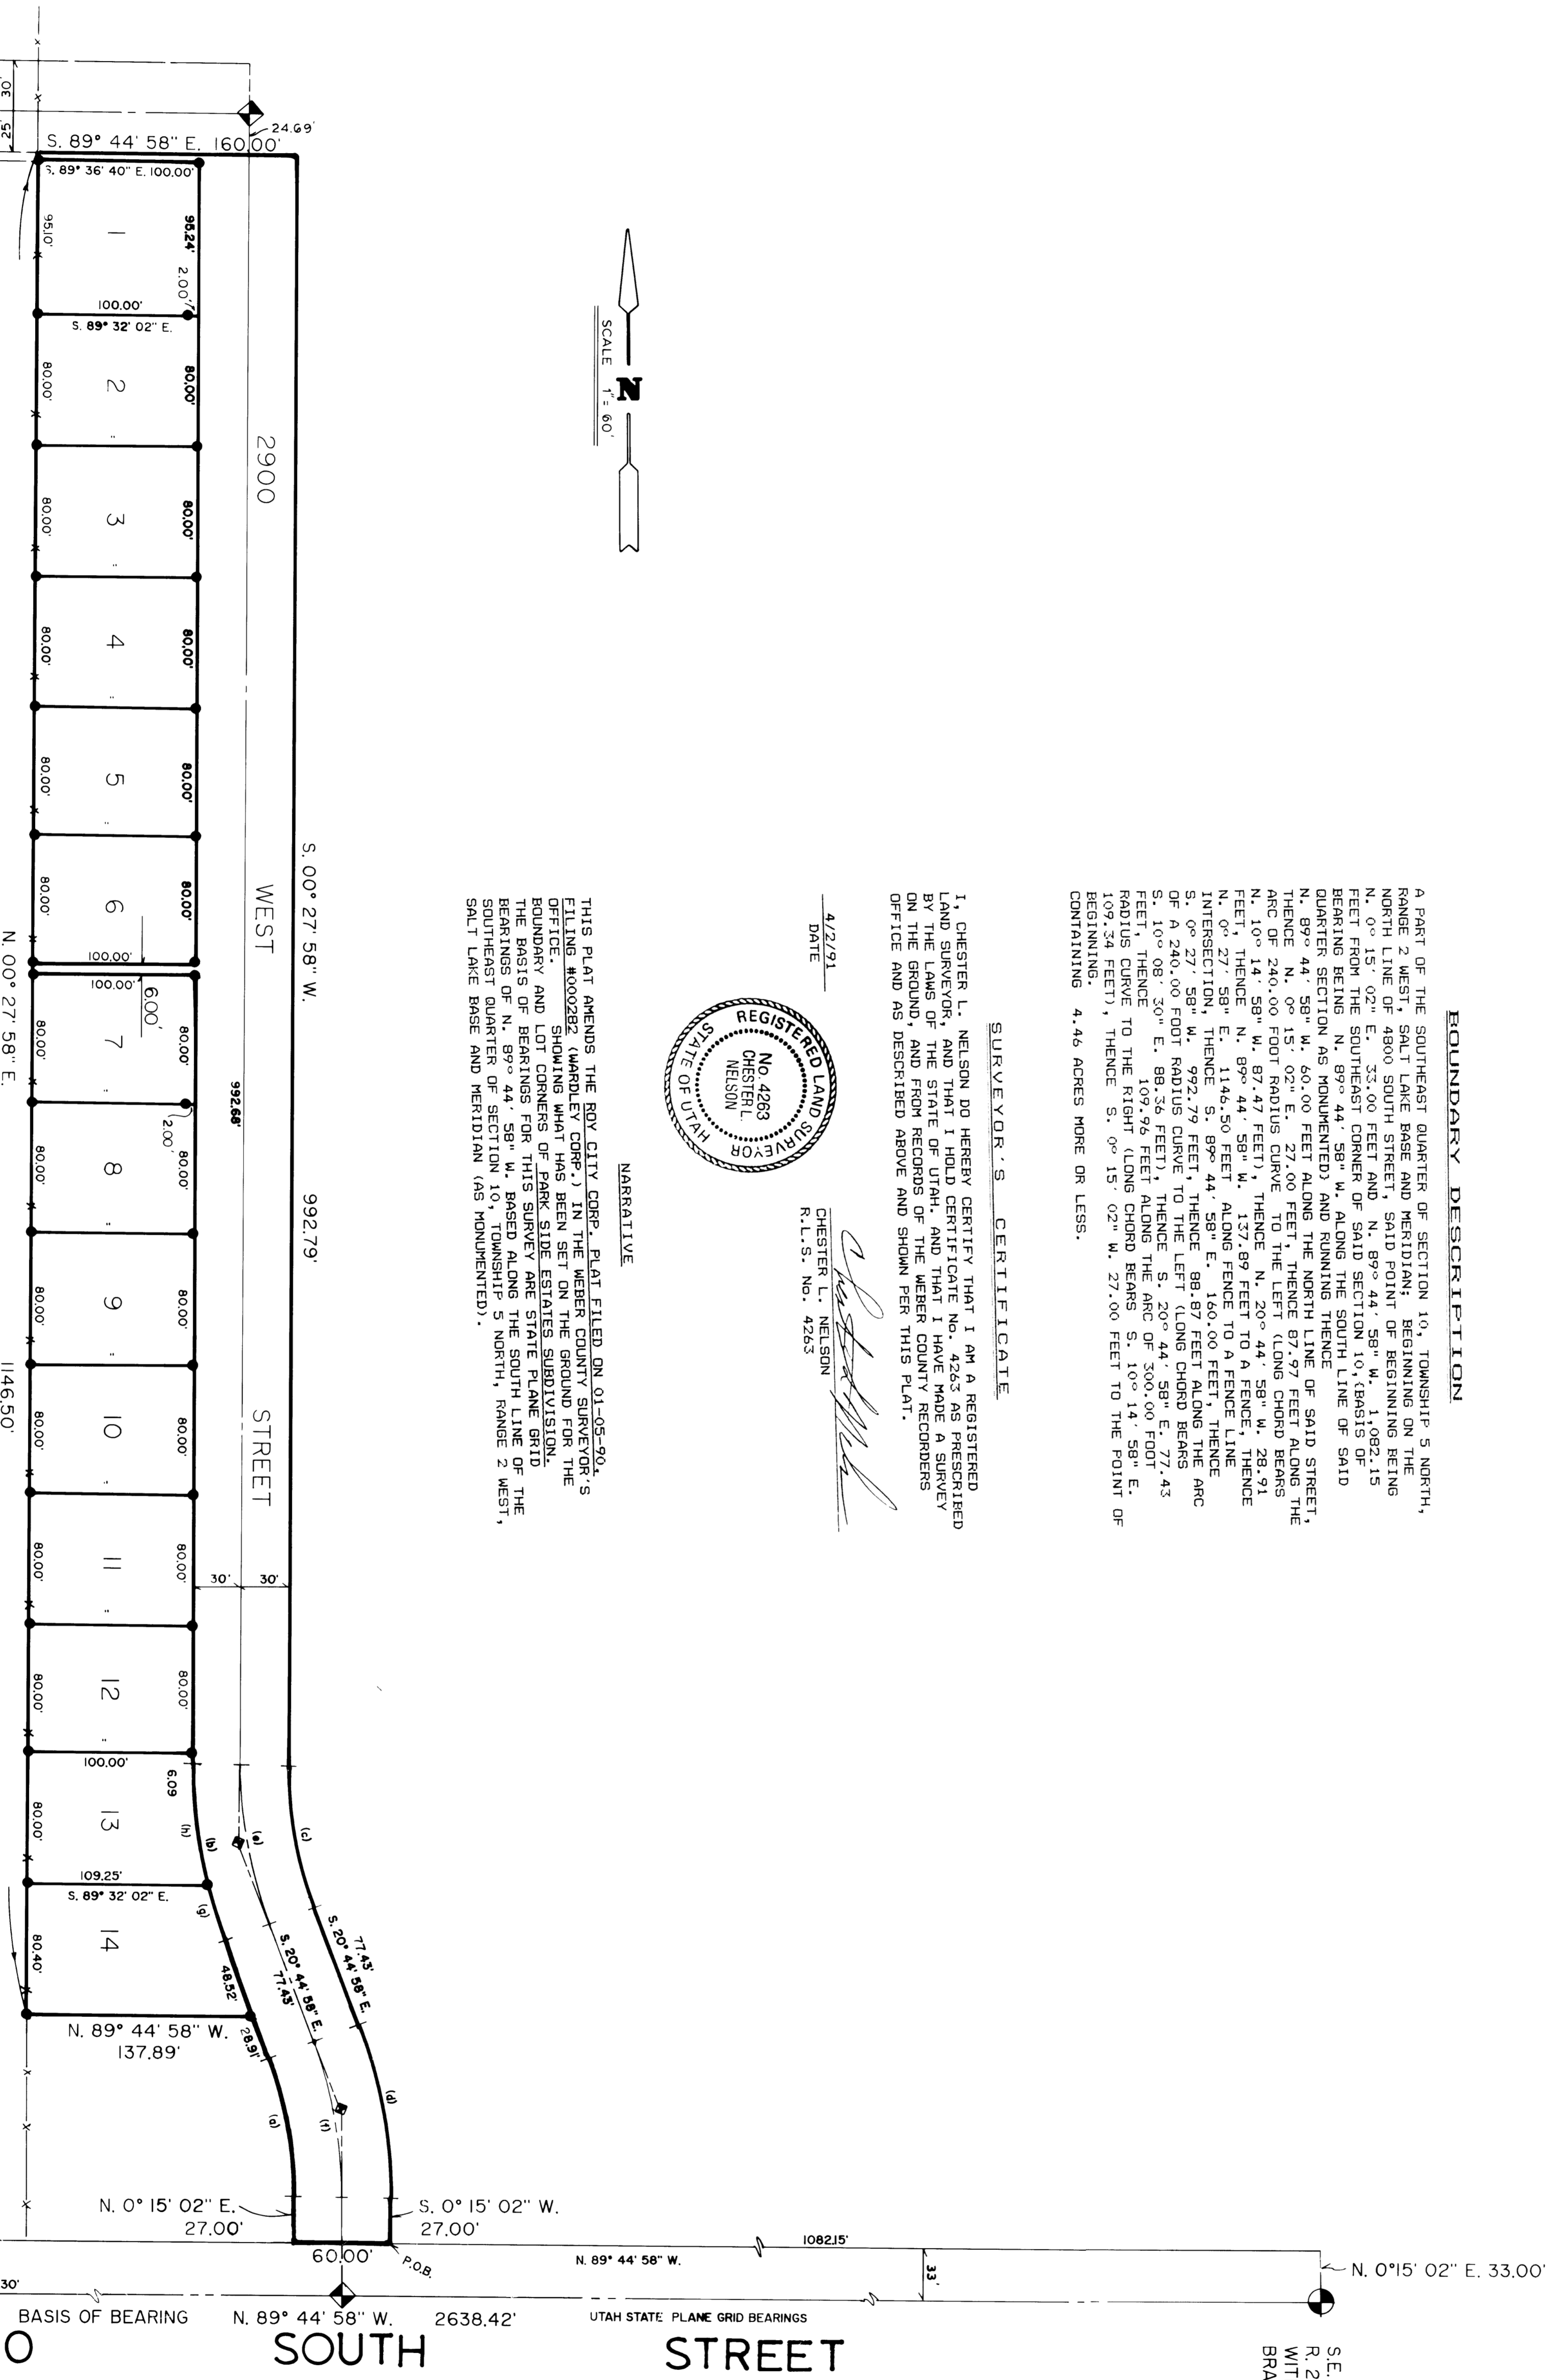

CURVE DATA

(1)	(2)	(3)	(4)

LEGEND

- () DISTANCE AND OR BEARING PER DEED OR PLAT.
- x-x-x-x- NO REBAR/FENCE IS MEASURED DISTANCE OR POINTED PLAT OR DEED BEARING TO STATE PLANE GRID BEARING.
- x-x-x-x- EXISTING FENCE.
- SET 3/4" REBAR W/CLAS SURVEY CAP.
- SEE PLAT DOCUMENTS W/OT GRASS & ALUMINUM CAP

S.E. CORN. SECTION 10 T 5 N.
R 2 W, S 1 B 8 N, AS MONUMENTED
WITH WEBER COUNTY SURVEYORS
BRASS CAP.

4800 SOUTH STREET

WEBER Co. 1526.27' MEAS. 1526.30'

BASIS OF BEARING N. 89° 44' 58" W., 2638.42'

UTAH STATE PLANE GRID BEARINGS

108215'

N. 0° 15' 02" E. 33.00'

RECEIVED
JUL 31 1991

Webber County Surveyor

CONSTRUCTION & LAND SURVEYORS, INC.
2781 WASHINGTON BLVD.
SALT LAKE CITY, UT 84119
(801) 588-4838

CLIENT: WARDLEY CORPORATION

SURVEY LOCATION:
SE 1/4 SECTION 10,
TOWNSHIP 5 NORTH, RANGE 2 WEST,
SALT LAKE BASE & MERIDIAN.