



566000

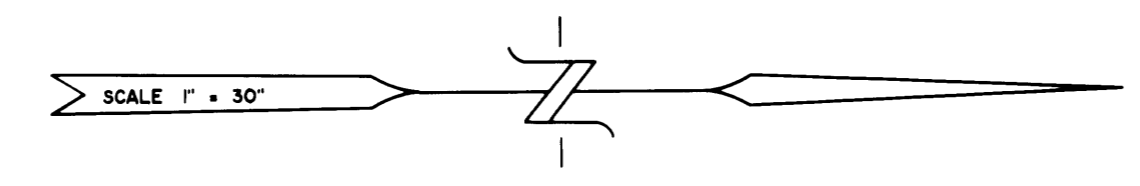

LEGEND
DISTANCES AND OR BEARING PER DEED OR P.L.A.T.
NO PARENTHESES IS MEASURED DISTANCE OR ROTATED
PLAT OR DEED BEARING TO STATION PLANE AND BEARING
EXISTING FENCE
SET 3/4" BEARS WITH C.B.L.S. SURVEY CAP.

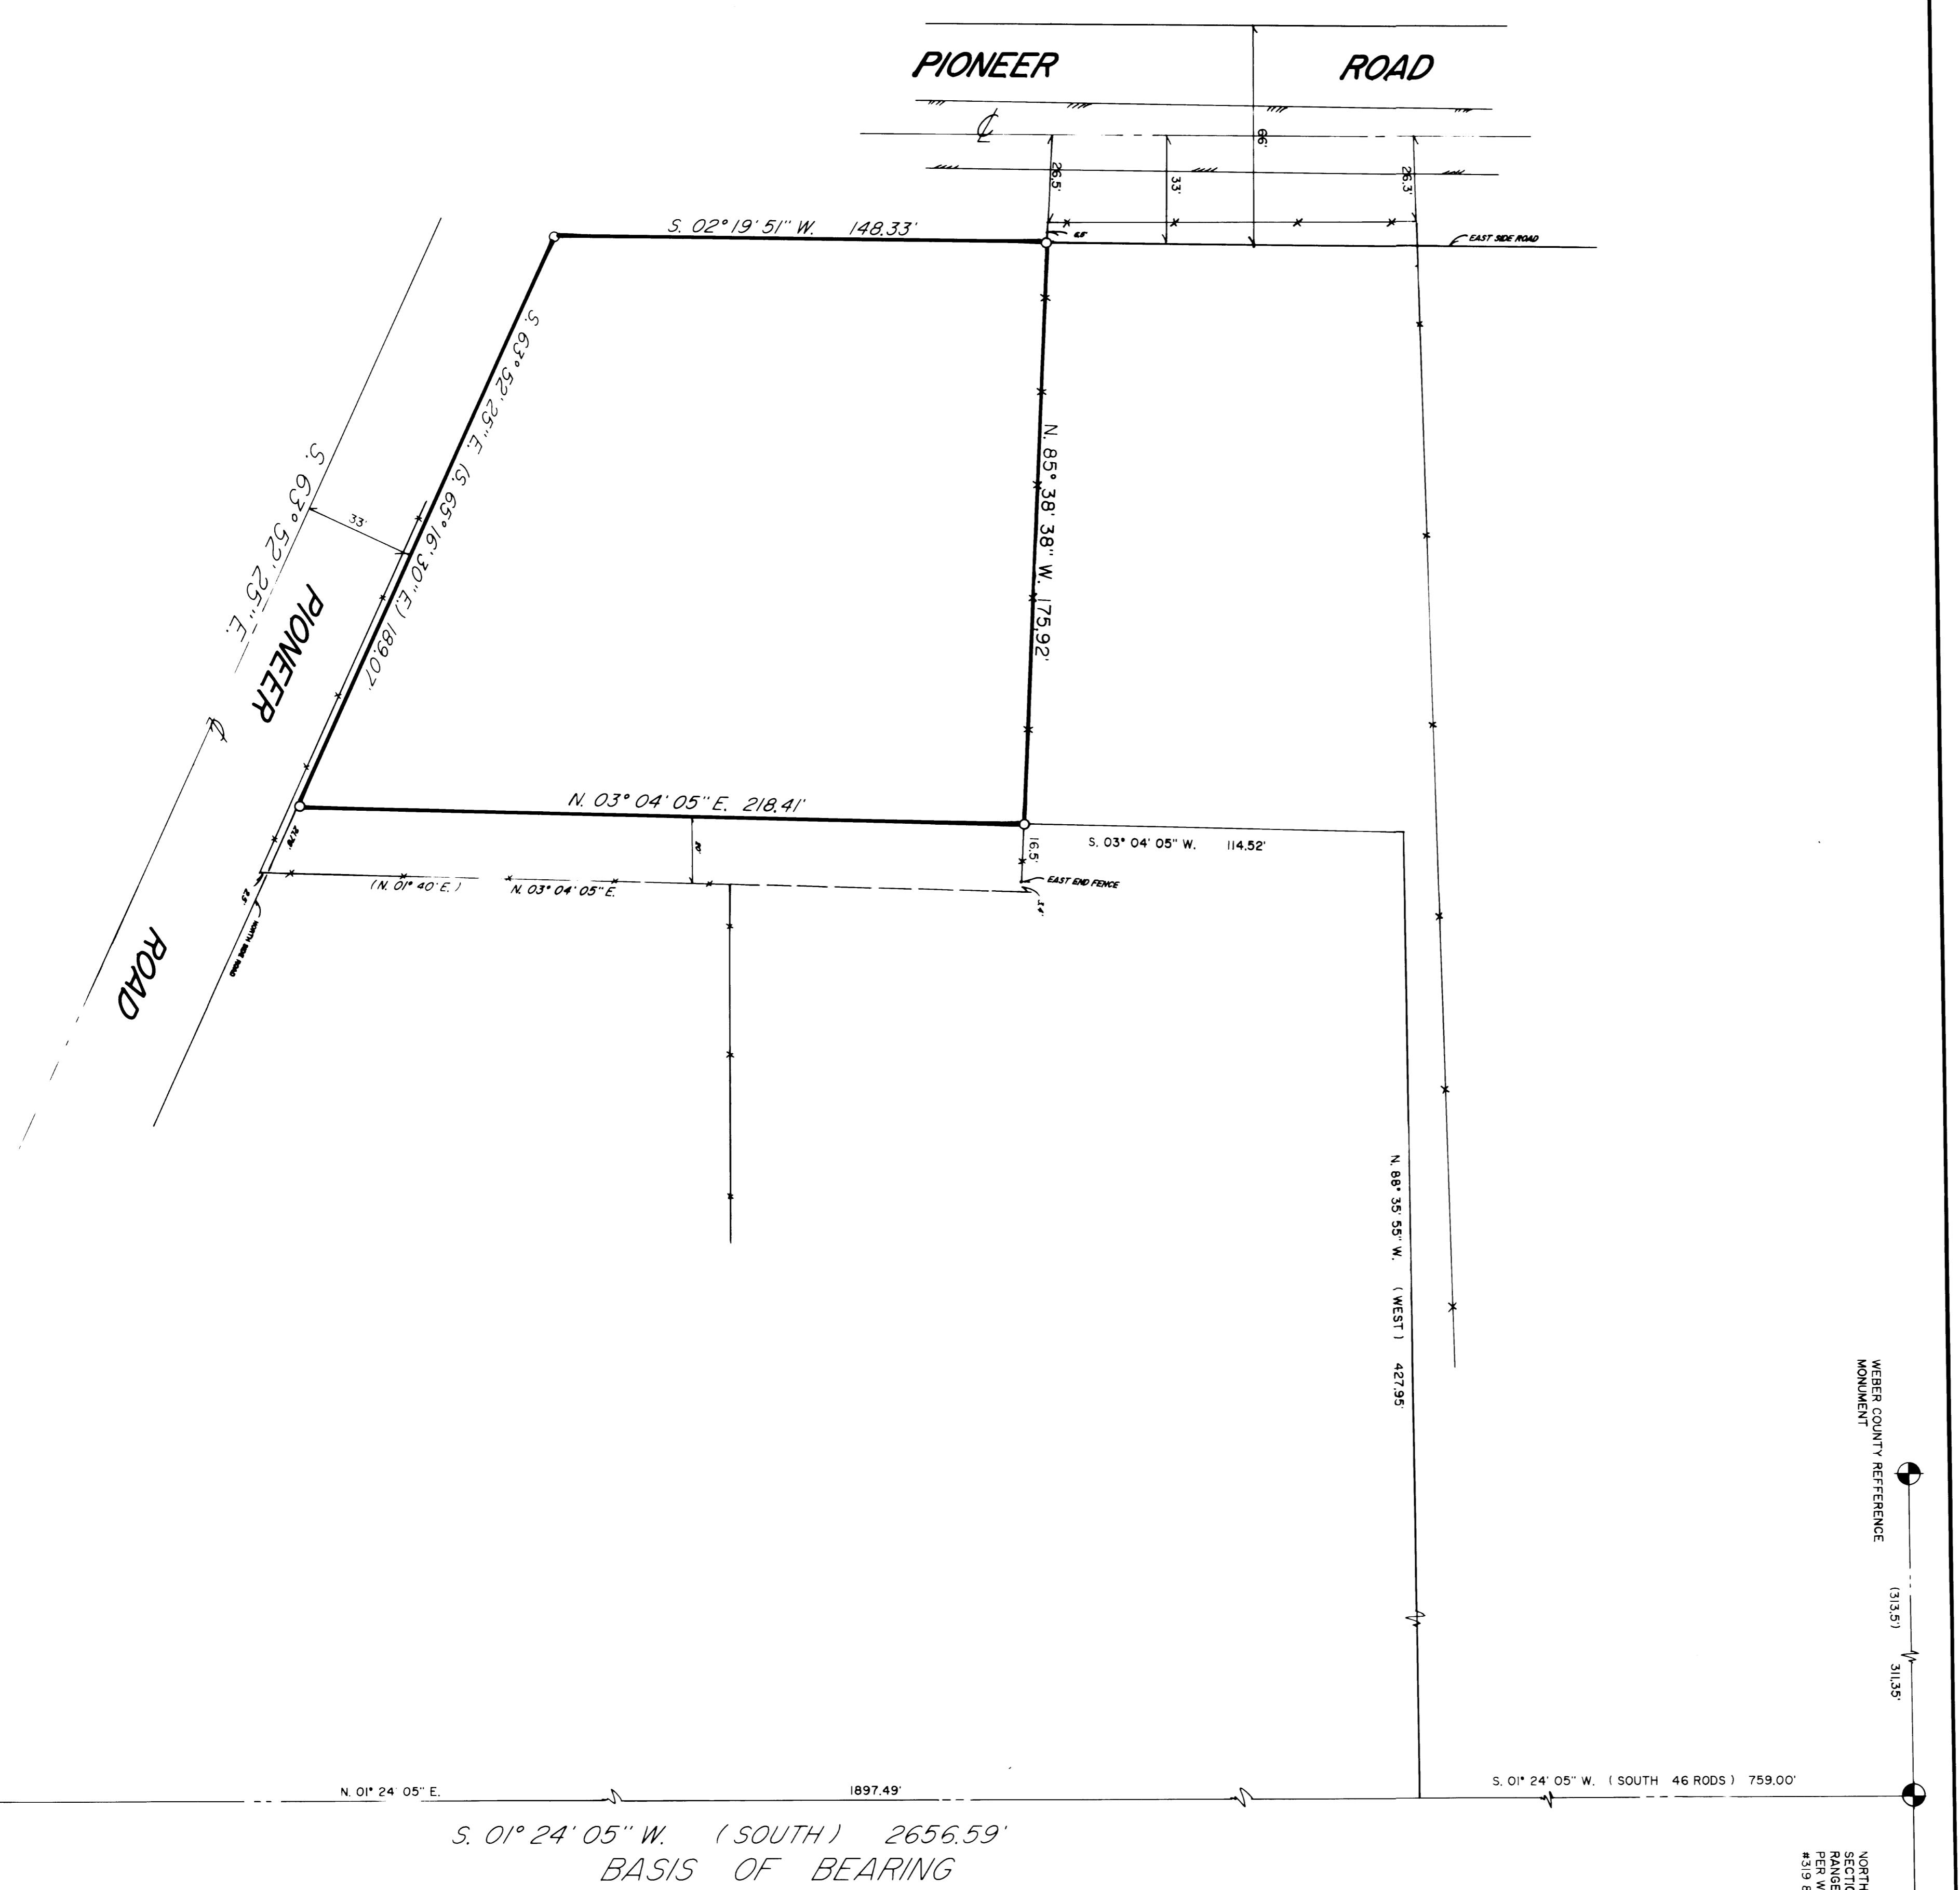


S. 01° 24' 05" W. (SOUTH) 2656.59'
BASIS OF BEARING

MONUMENT REFERENCE

LEGAL DESCRIPTION


SURVEYOR'S CERTIFICATE
CYNTHIA L. ROBBINETT R.L.S.:7511
DATE 4-23-91

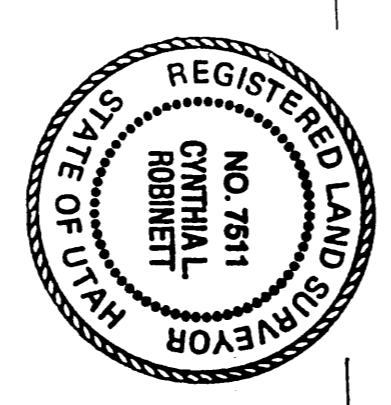

NARRATIVE



RECEIVED
JUL 31 1991

CLIENT:
GORDON HILLIARD

SURVEY LOCATION:
NE 1/4 SEC. 5,
TOWNSHIP 6 NORTH, RANGE 2 WEST,
SALT LAKE BASE & MERIDIAN.

SURVEY DATE: 4-23-91

JOB NO.: P.581-11

CONSTRUCTION & LAND SURVEYORS INC.
2781 WASHINGTON BLVD.
ORDER UTM 84401
(801) 398-4838