
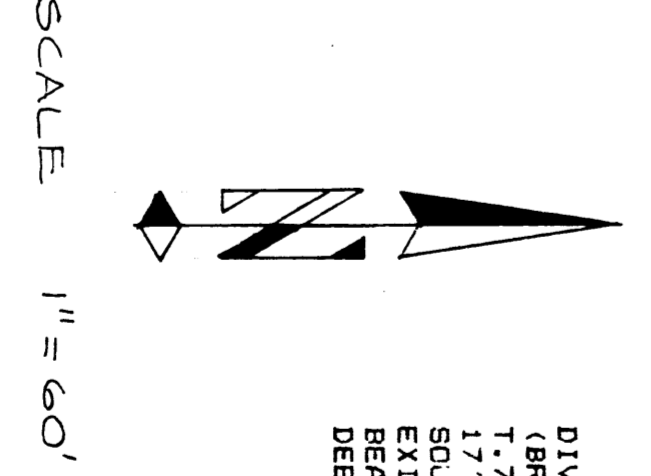


045000

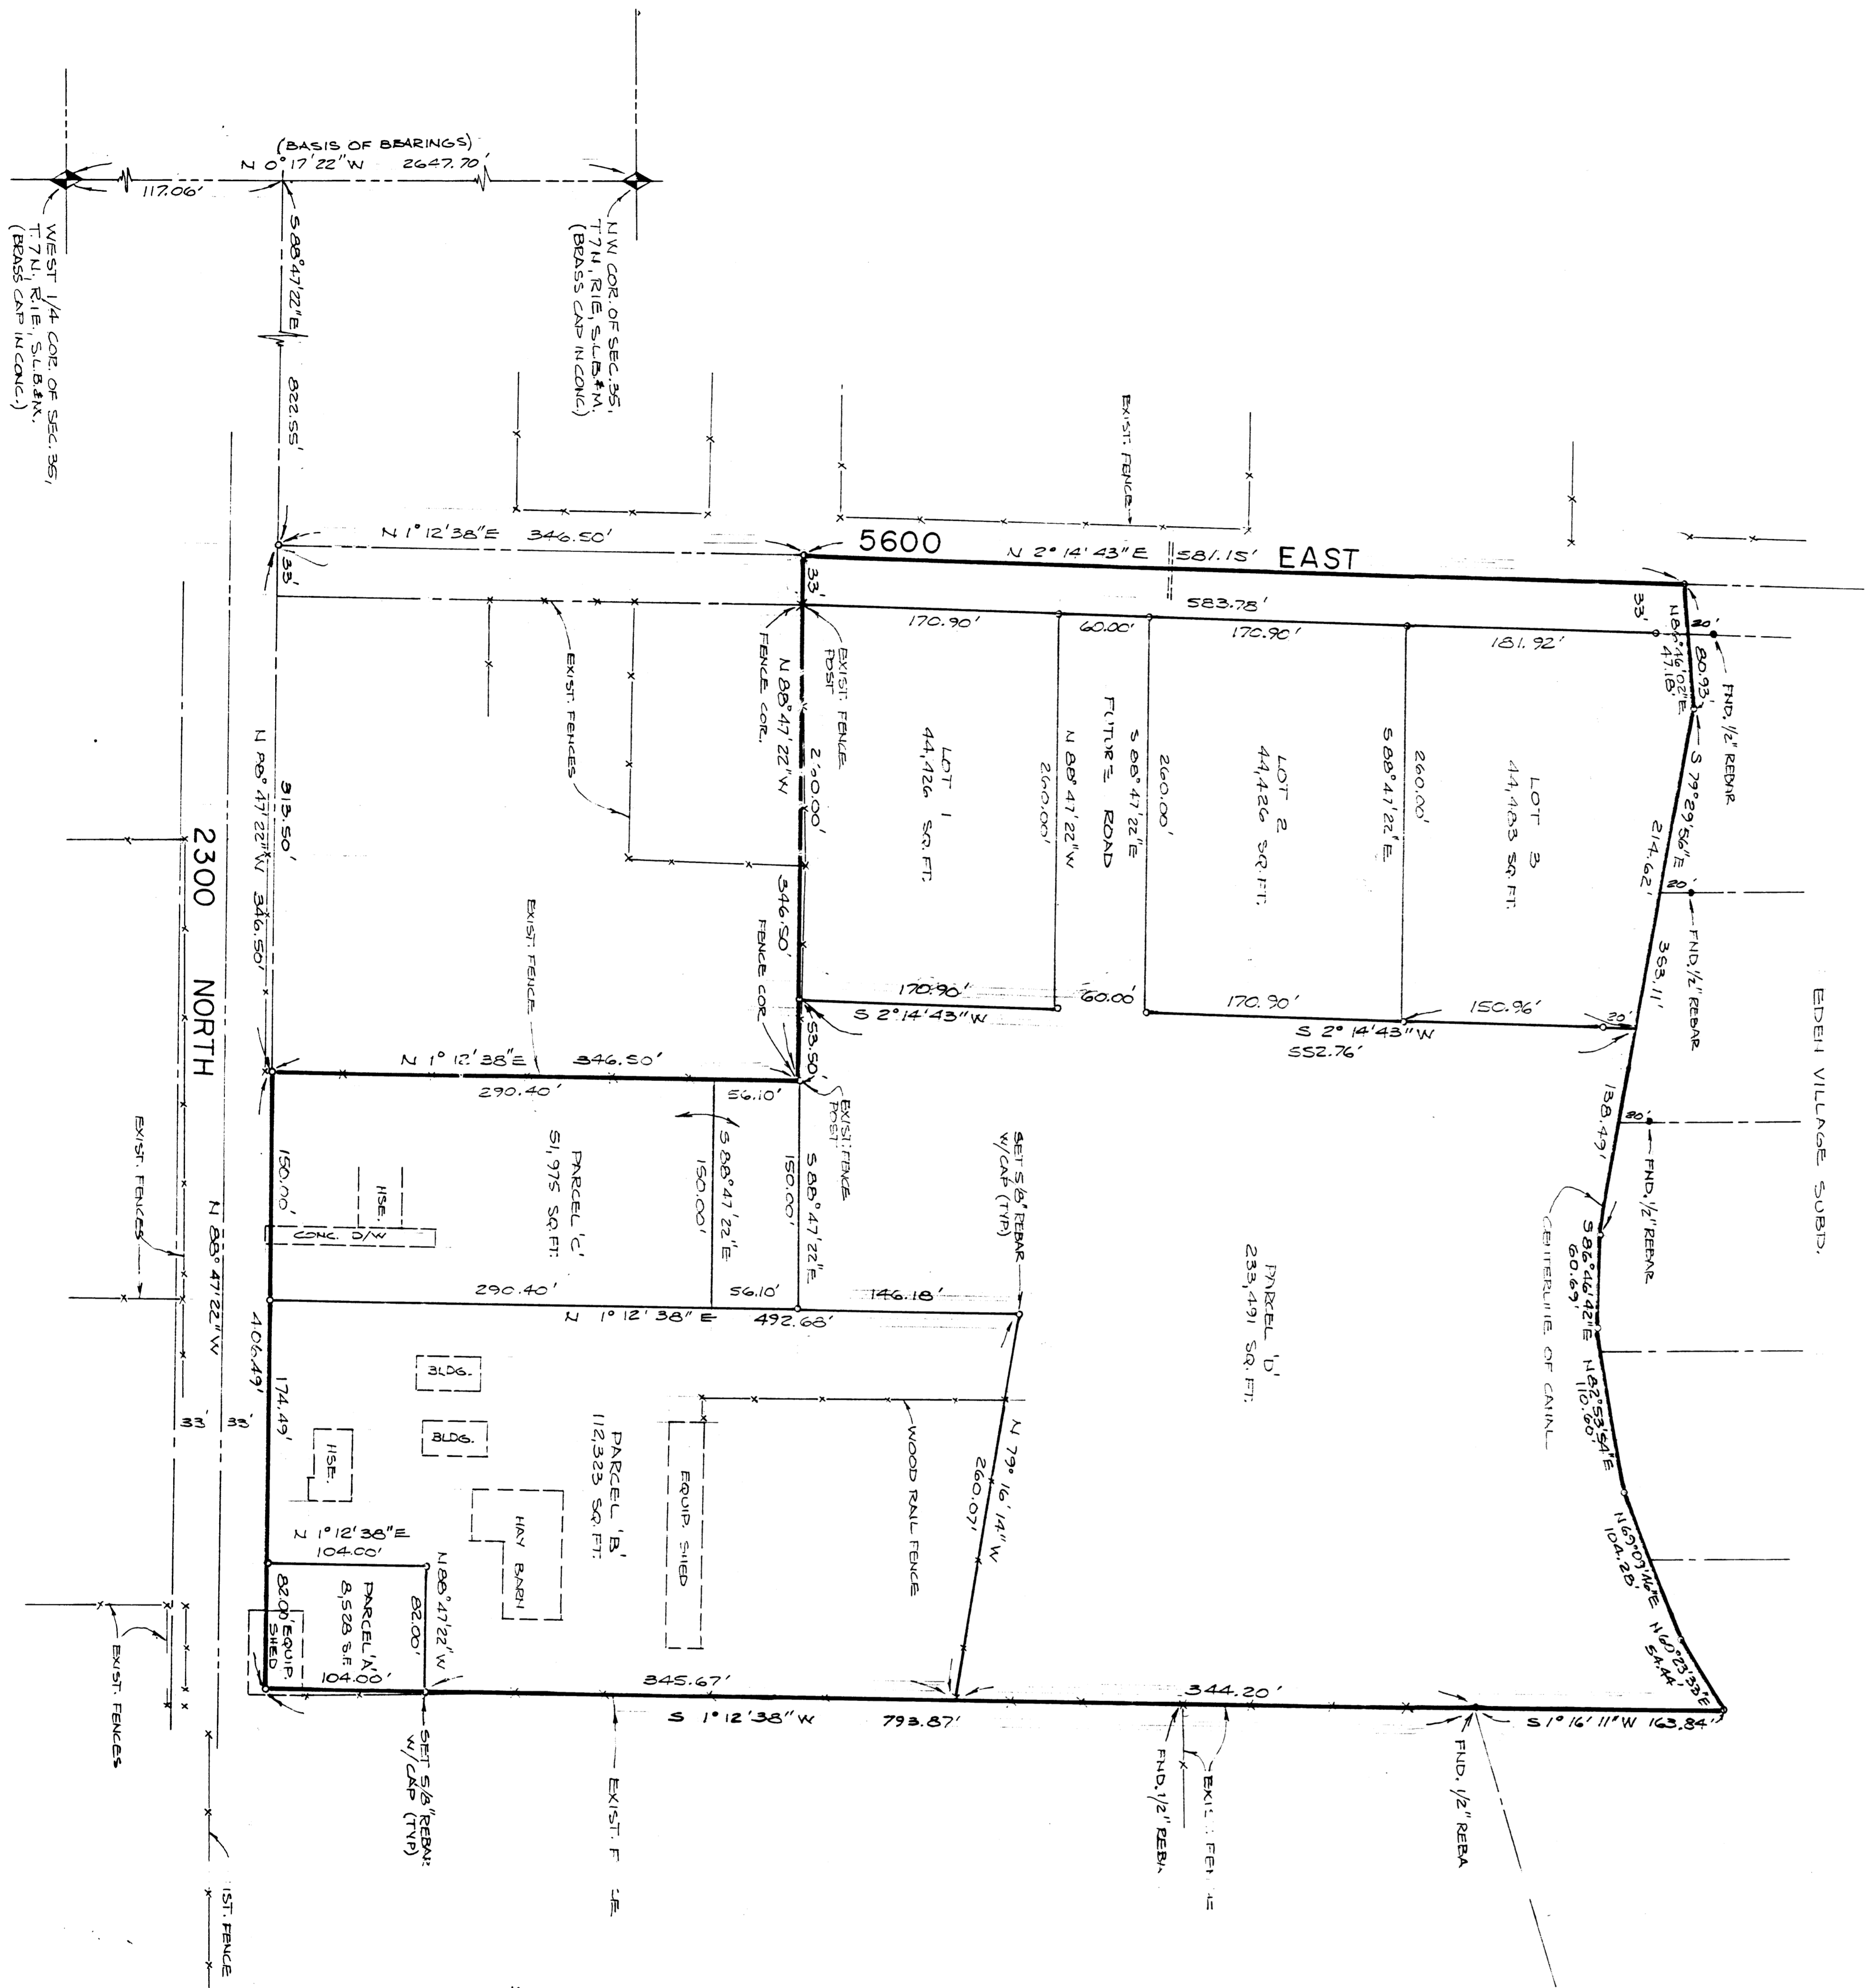

NARRATIVE

THE SOUTH LINE OF EDEN VILLAGE SUBD. WAS UTILIZED AS THE BASIS OF BEARINGS. ALL OTHER PROPERTY LINES WERE ESTABLISHED BY RECORDED DEEDS AND EXISTING FENCE LINES.

CERTIFICATION


DATE 7-26-91
JOHN P. REEVE



PROJECT NO. 7-26-91
DATE 7-26-91
SCALE 1" = 60'

REEVE & REEVE, INC.
CIVIL AND ENVIRONMENTAL ENGINEERING
LAND PLANNING AND SITE DESIGN

DR. GALE B. ARMSTRONG SURVEY

SHEET 1
SHEETS 1

RECEIVED
SEP 04 1991
Water County Recorder