


SURVEYORS CERTIFICATE

I, Larry M. Buttars, a registered Land Surveyor as prescribed by the laws of the State of Utah, and holding licence No. 2596 do hereby certify that I made a survey of the below described property and the Plat hereon is a true and correct representation of said survey.

Date: 5-13-91 Sign: *Larry M. Buttars*

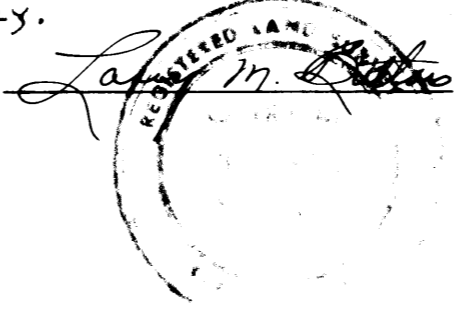

DESCRIPTION

All of lot 12, Liberty Meadows Subdivision in Weber County, Utah, according to the official plat thereof.

NARRATIVE

The purpose of this survey was to establish the lot line between lots 11 & 12 for construction. Original Subdivision bearings, distances and Survey date were used to establish this line.

LEGEND

- o Set 3/4" x 24" re-bar with plastic cap stamped L. Buttars R.L.S. 2596
- Set P.K. nail with ribbon

| | |
|--|------------------|
| BUTTARS SURVEYING | |
| 1815 26 TH STREET | OGDEN, UT. 84401 |
| | PHONE 392-5271 |
| CLIENT: EARL SNYDER | |
| SURVEY LOCATION: LIBERTY MEADOWS SUBDIV., WEBER COUNTY IN S.E. 1/4 SEC. 20, T. 1N., R. 1E. | |
| SURVEY DATE: 5-11-91 | |

RECEIVED
SEP 10 1991

Weber County Surveyor