


SURVEYORS CERTIFICATE

I, Larry M. Buttars, a registered Land Surveyor as prescribed by the laws of the State of Utah, and holding licence No. 2596, do hereby certify that I made a survey of the below described property and the Plat hereon is a true and correct representation of said survey.

Date 5-17-91 Sign *Larry M. Buttars*

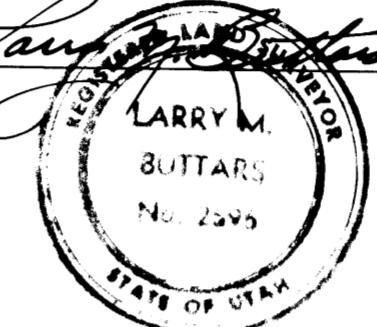

DESCRIPTION

All of lot 16 and part of lot 15, Main Point South Subdivision in Weber County, Utah, described as follows: beginning at the N.W. cor. of said lot 15, and running thence S. 30° E. 120.95 ft., thence N. 51° 51' 33" E. 49.41 ft., thence N. 37° 32' 28" W. 117.18 ft., thence along a 255.54 ft. radius curve to the right 33.63 ft. to the point of beginning.

All of lot 14 and part of lot 15, Main Point South Subdivision in Weber County, Utah, described as follows: beginning at the N. E. corner of said lot 15, and running thence S. 46° 20' 02" W. 104.11 ft., thence S. 35° W. 57.63 ft., thence N. 37° 32' 28" W. 117.18 ft., thence along a 255.54 ft. radius curve to the left 77.87 ft. to the point of beg.

NARRATIVE

The purpose of this survey was to re-subdivide lots 14, 15, and 16 into two parcels to allow construction of homes on larger parcels. Recorded bearings, Monuments and lot corners from this Subdivision were used for this Survey.

LEGEND

- Set 3/4" x 24" re-bar with plastic cap stamped L. Buttars R.L.S. 2596
- Set P.K. nail with ribbon

RECEIVED

SEP 10 1991

Weber County Surveyor

BUTTARS SURVEYING

1815 26TH STREET OGDEN, UT. 84401
PHONE 392-5291

CLIENT: TOM MILLER

SURVEY LOCATION:
MAIN POINT SO. SUBDIV. WEBER COUNTY
PT. N.W. V4 SEC. 22, T.5N., R.1W.

SURVEY DATE: 5-15-91