


000573

000573

000573


000573

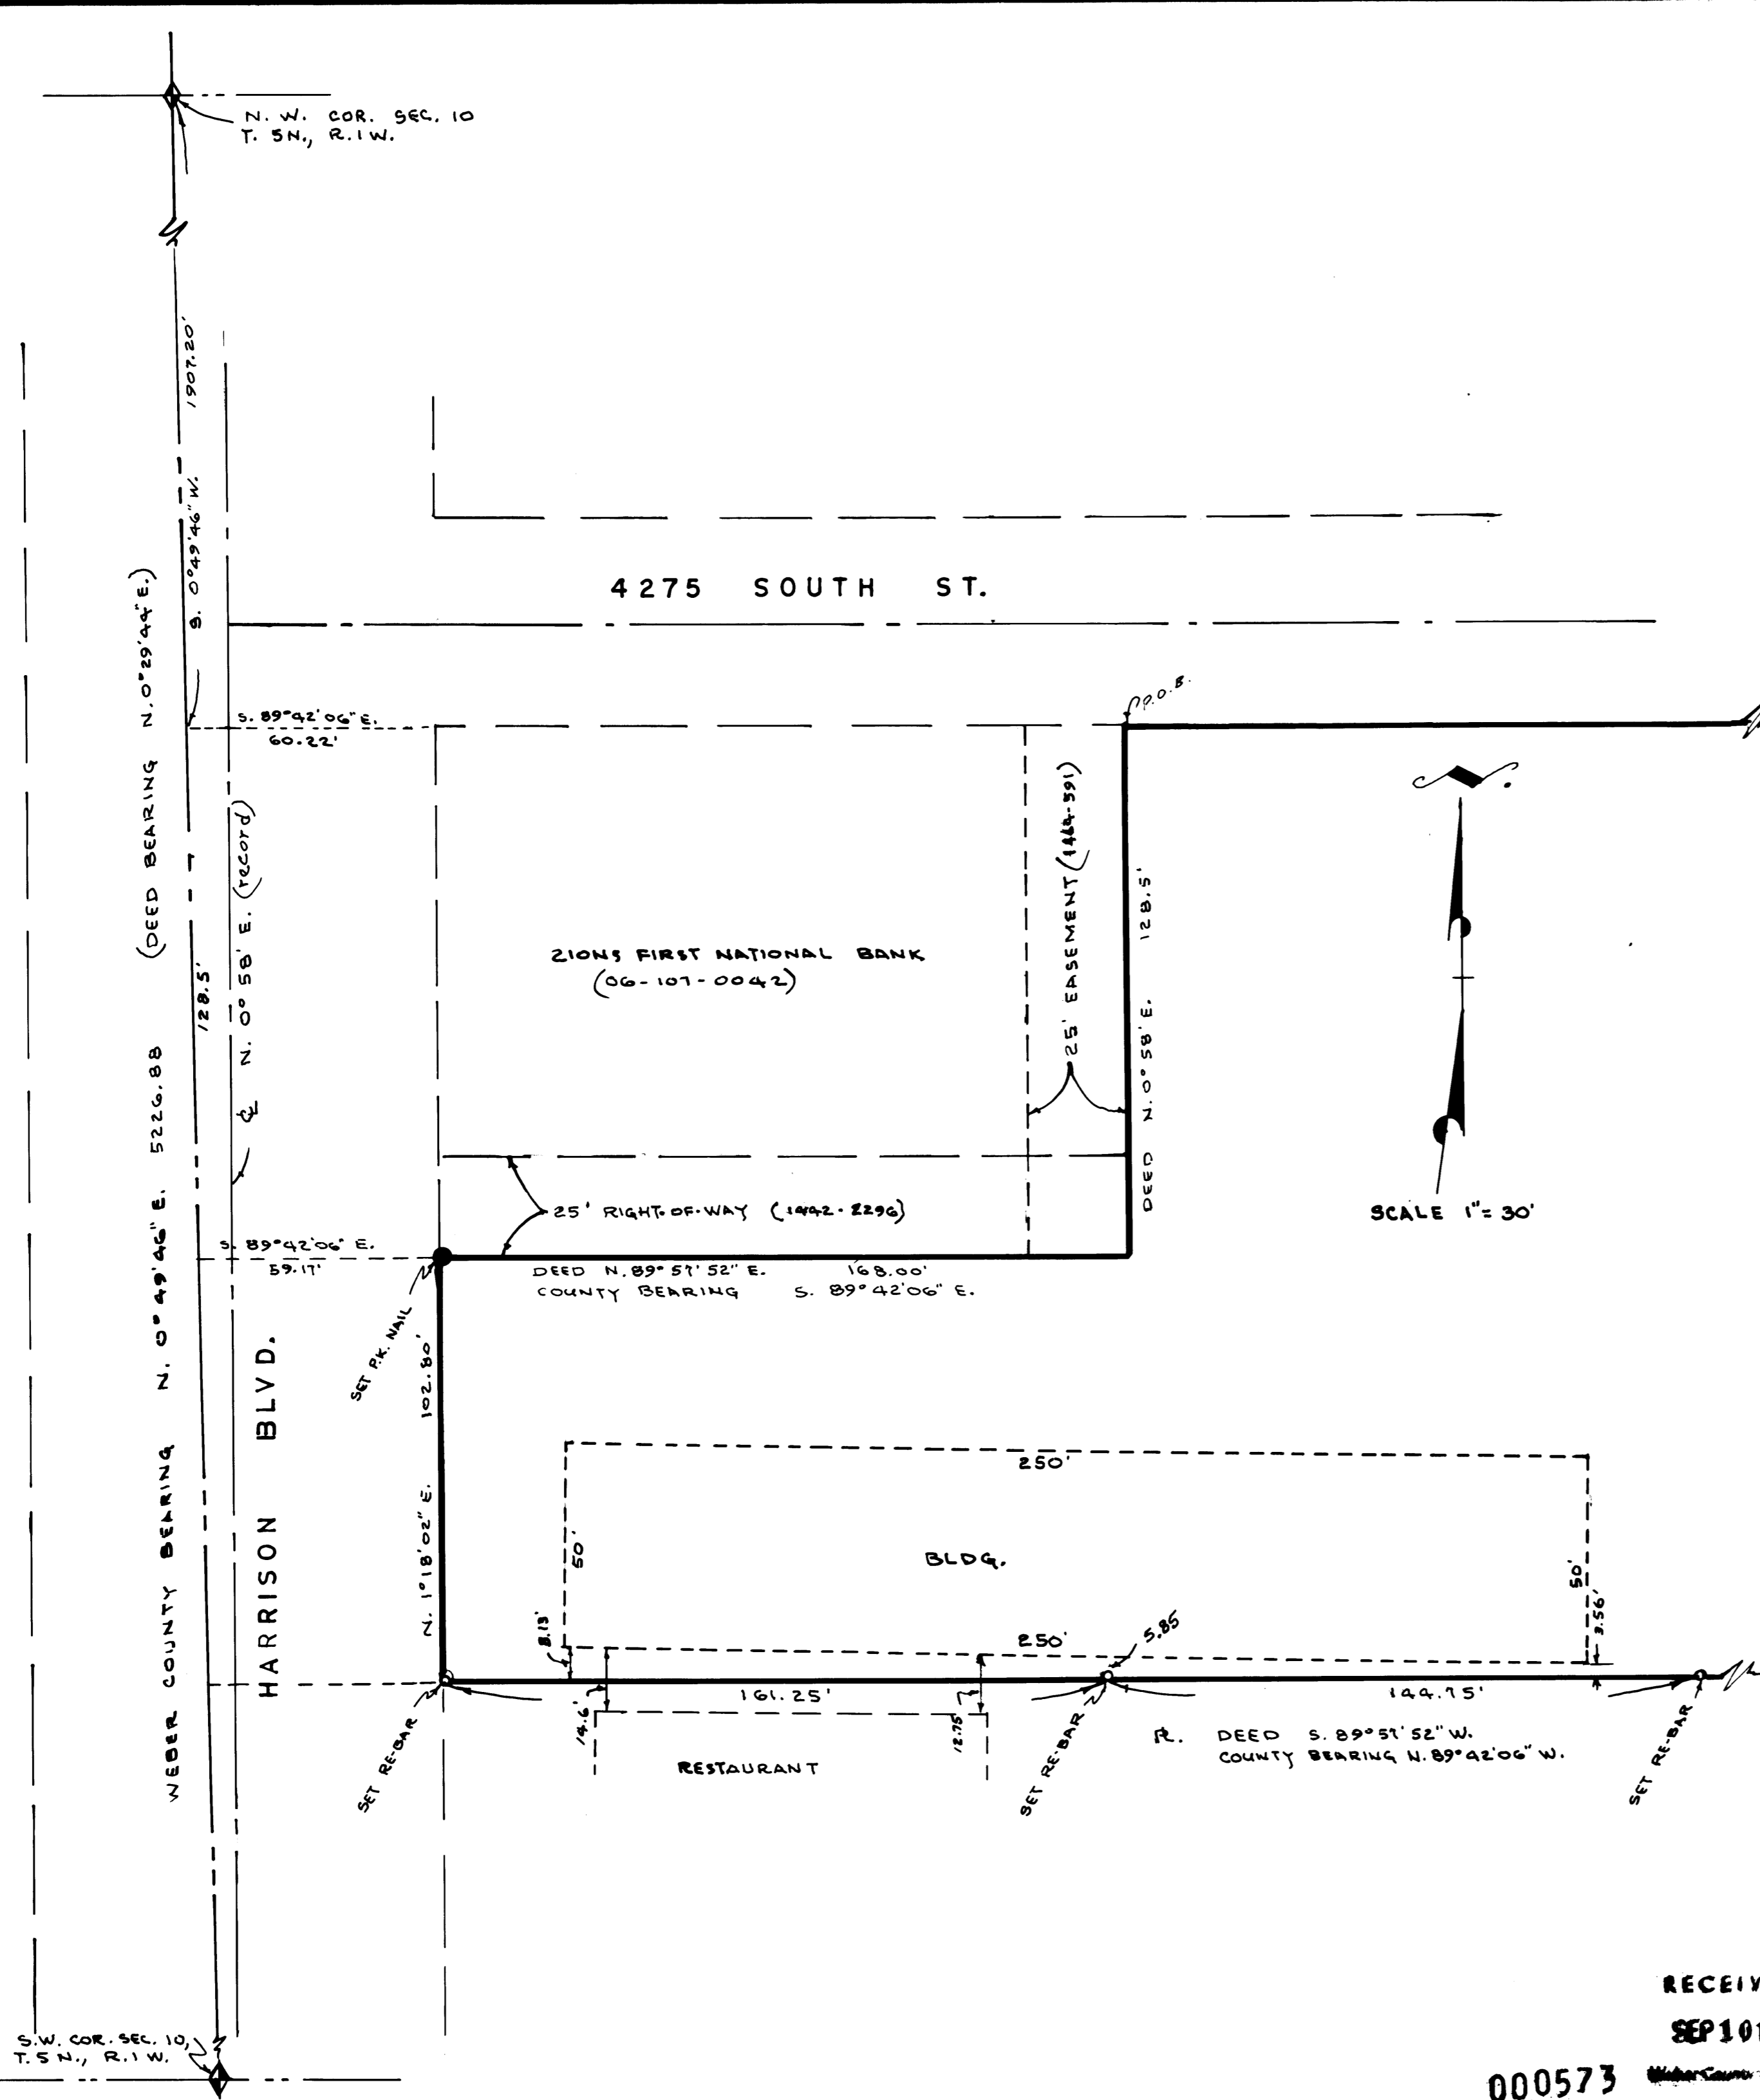

SURVEYOR CERTIFICATE

I, LARRY M. BUTTARS, SURVEYOR, DO HEREBY CERTIFY THAT THE FOREGOING IS A TRUE AND CORRECT COPY OF THE ORIGINAL SURVEY RECORD.

Date: 1-7-91

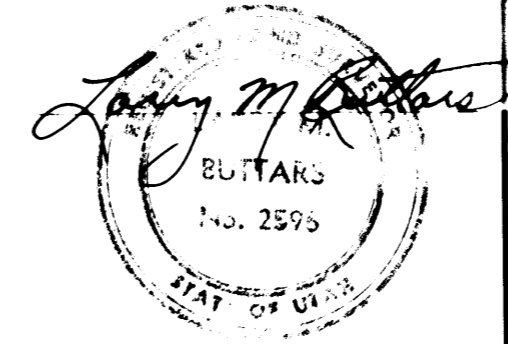

DESCRIPTION

Land Serial No. 06-107-0019

NARRATIVE

The purpose of this Survey was to establish the South property line for existing bldg. modifications.
 Bearings rotated clockwise 0°20'02" to State plane co-ordinates. (County Bearings)

LEGEND

- Set 3/4" rebar with plastic cap stamped L. Buttars R.L.S. 2596
-

BUTTARS SURVEYING

1815 EAST STREET

CLIENT: MITER CORP.

SURVEY LOCATION:
 N. W. 1/4 SECTION 10, T. 5N., R. 1W.
 OGDEN CITY, WEBER COUNTY, UT.

SURVEY DATE: 1-4-91

RECEIVED SEP 10 1991

000573

000573