


NUMBER	ACCOUNT	APPROVAL	NO. AUTHORIZED BY	REVISIONS	MADE BY	DATE	DESIGN BY	SCALE
		SIGNATURE						
SHEETS		DATE						

WEBER COUNTY
SURVEYOR & ENGINEER'S
OFFICE


LOCATED IN THE SOUTHWEST 1/4 OF
SECTION 6, T7N, R2E
SURVEYED NOV 13TH, 1987

SURVEYED FOR DR ALVIN F. AND
MRS. LANE H. COBARR

NUMBER	ACCOUNT
SHEETS	

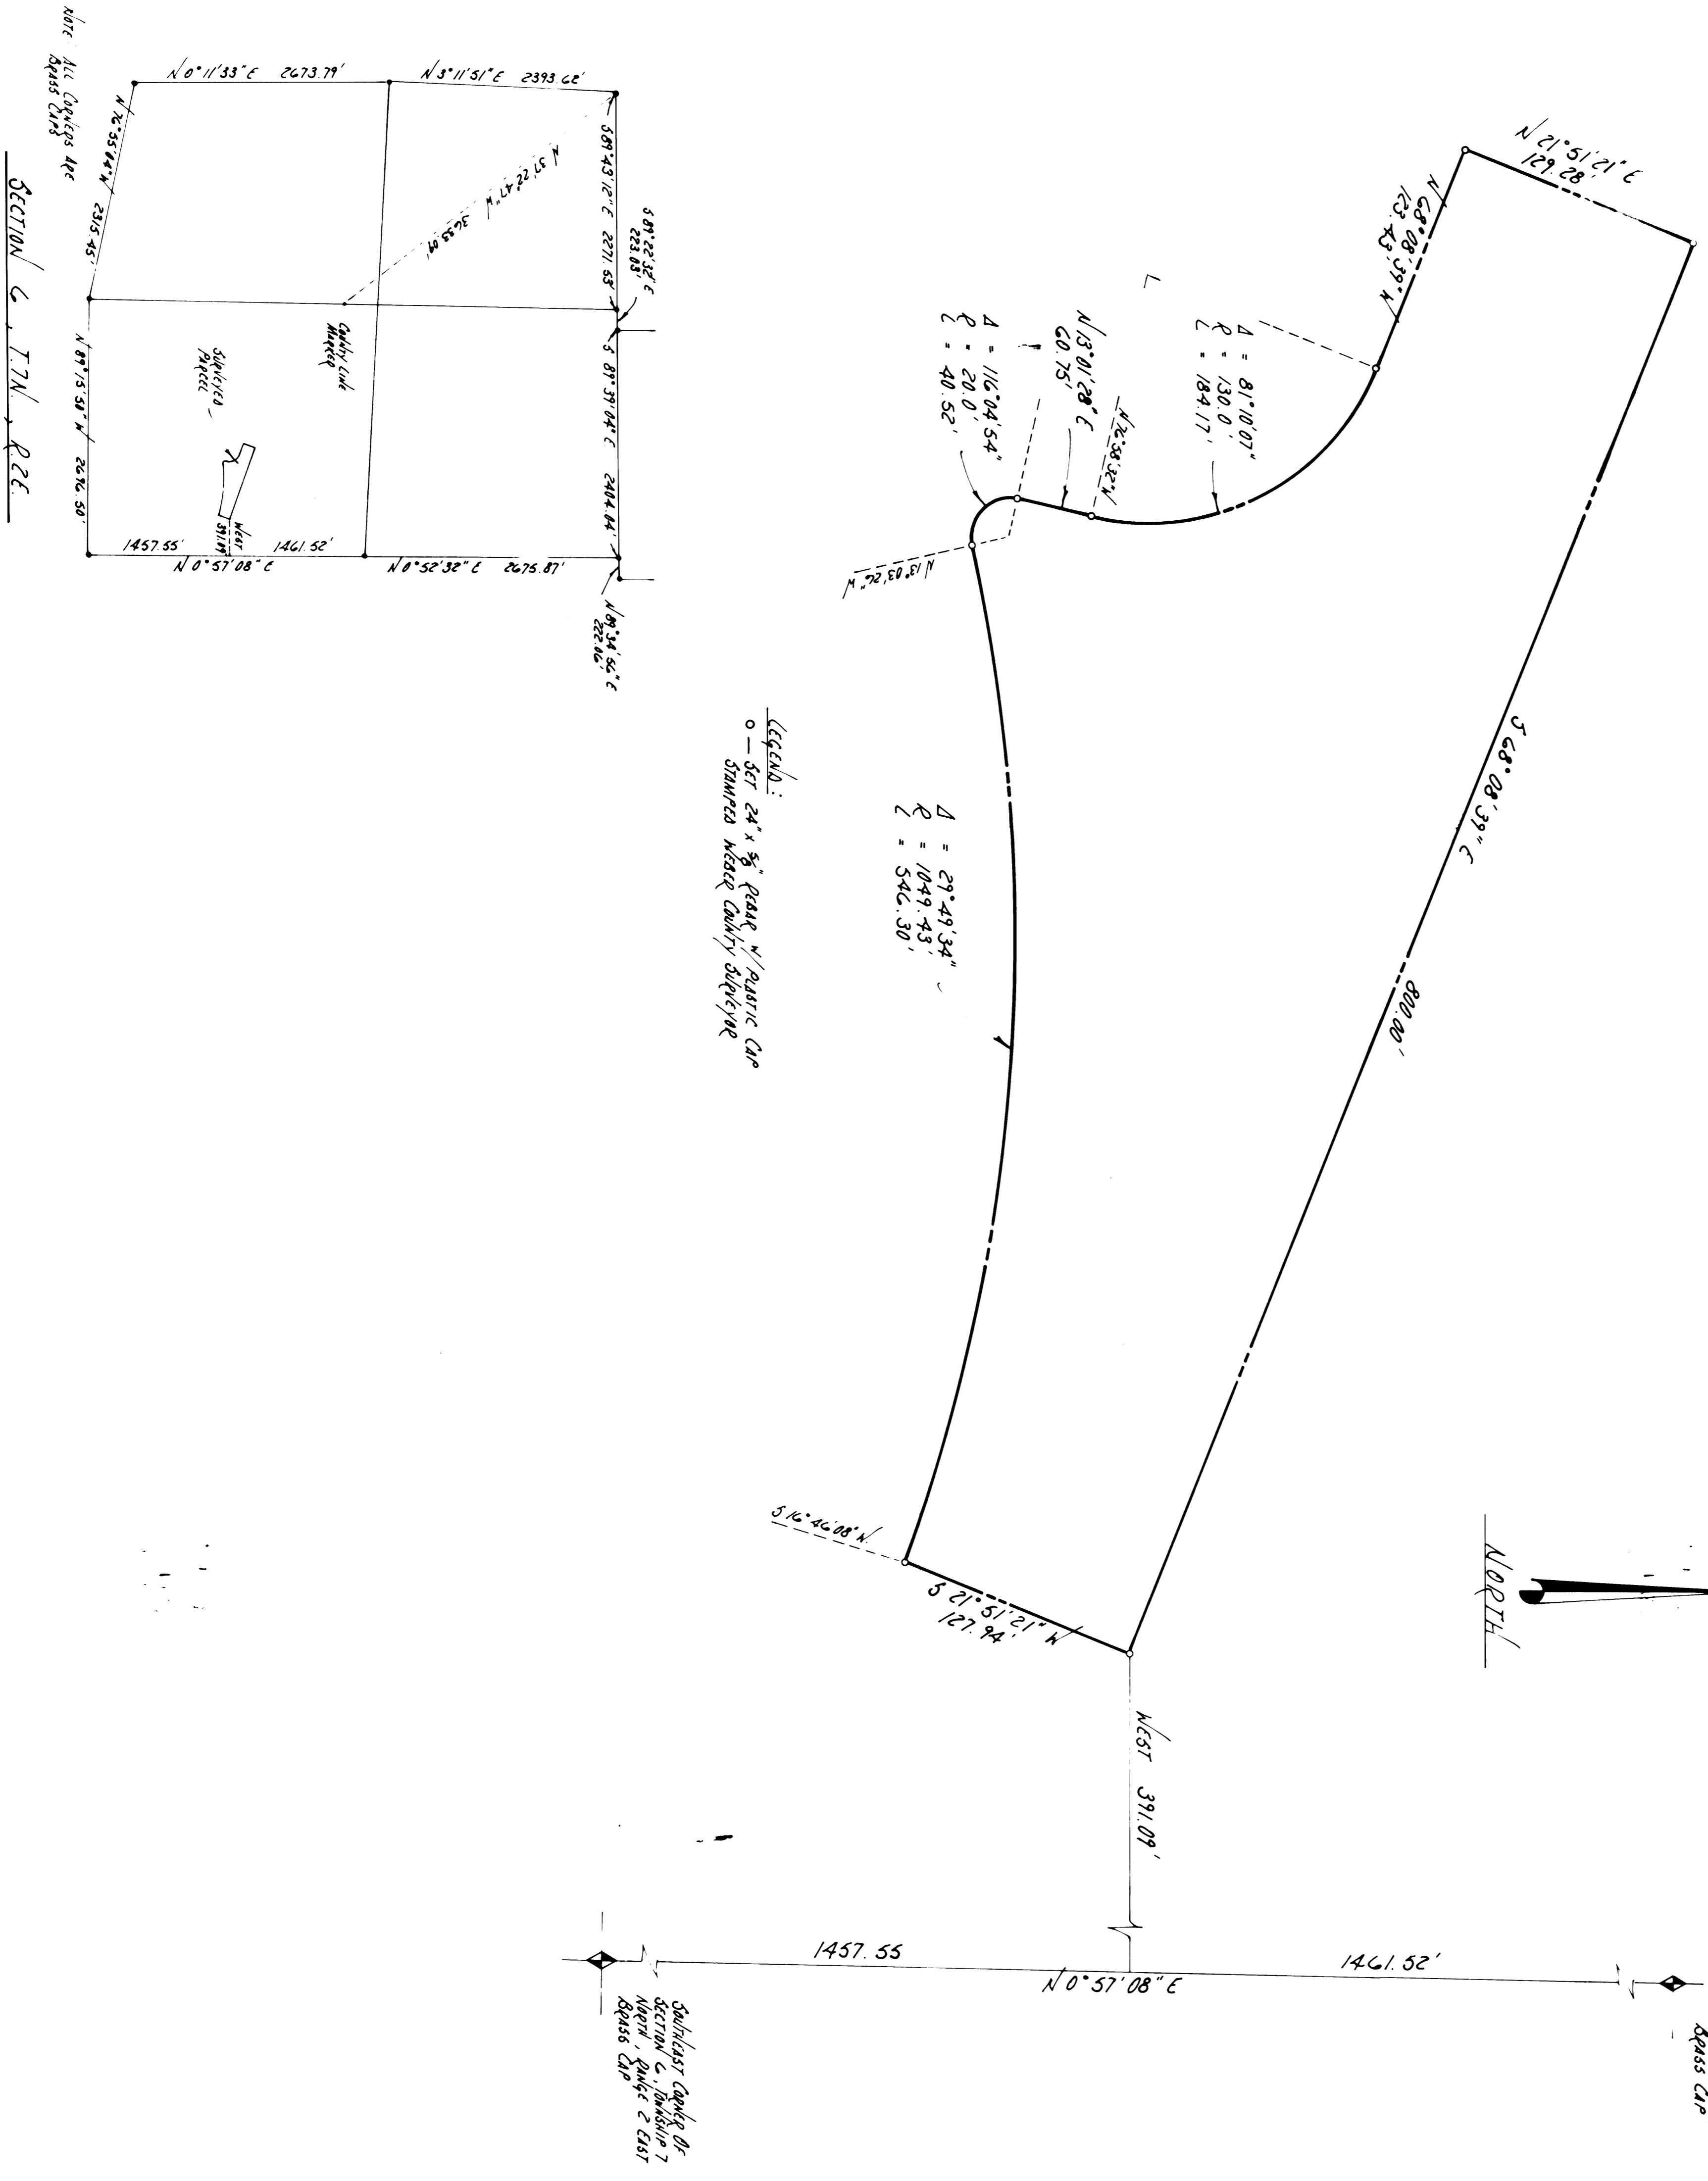

LEGEND:

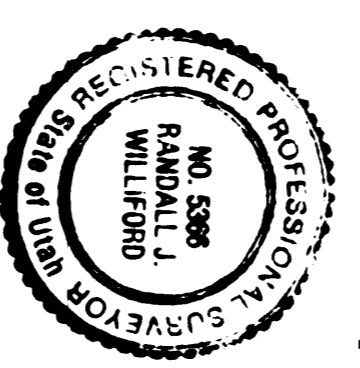

SURVEYOR'S CERTIFICATE

DEPUTY COUNTY SURVEYOR

NARRATIVE
This survey was performed to create a parcel for the future site of the Weber State College Observatory. The location was staked and described as directed by Dr. Alvin Cobarr and interpretation was necessary. This is a new parcel. No deed interpretation was necessary.

PROPERTY DESCRIPTION
Beginning at a point that is N 09° 10' 08\"/>

RECEIVED
JAN 13 1988
Weber County Surveyor