


CERTIFICATE

I, VON R. HILL, A PROFESSIONAL LAND SURVEYOR ACCORDING TO THE LAWS OF THE STATE OF UTAH, DO CERTIFY THAT I HAVE SURVEYED THE PARCEL OF GROUND SHOWN HEREON ACCORDING TO UTAH STATE CODE 17-23-17.

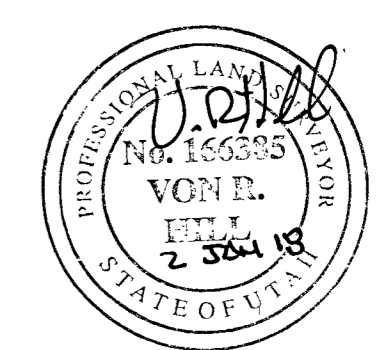

DESCRIPTION

PART OF THE WEST HALF AND SOUTHEAST QUARTER OF SECTION 30, TOWNSHIP 6 NORTH, RANGE 1 WEST, SALT LAKE MERIDIAN, US SURVEY: BEGINNING AT A POINT THAT IS SOUTH 1°26' WEST 140 FEET, MORE OR LESS, FROM THE NORTHEAST CORNER OF THE SOUTHEAST QUARTER OF SAID SECTION 30, SAID POINT IS ON THE NORTH LINE OF WILSON AVENUE, RUNNING THENCE NORTH 68°55'49\"/>

DESCRIPTION INFORMATION IS FROM THE WEBER COUNTY RECORDER'S OFFICE. SERIAL # 14-013-0006

NARRATIVE

THE PURPOSE OF THE SURVEY WAS TO MARK THE PROPERTY CORNERS ALONG THE NORTHERLY RIGHT OF WAY OF EXCHANGE ROAD. THE CENTER QUARTER POSITION FOUND IN PLACE WAS 0.60 FEET WESTERLY OF THE CALCULATED POSITION FROM MONUMENTS 358 AND 359. THE POSITION OF THE MONUMENT IN PLACE WAS ACCEPTED AND ALL PROPERTY LINES WERE LAID OUT FROM SAID POSITIONS AS PER DESCRIPTION CALLS. THE CENTER LINE OF EXCHANGE ROAD WAS DETERMINED FROM THE GREAT BASIN SURVEY # 000145 AND THE OGDEN CITY PLAT DRAWING #2666, ONLY AS FAR AS THE CENTER OF THE SECTION LINE RUNNING THE SOUTH. SAID LINE IS ALSO THE CITY LIMIT LINE. THE CENTER LINE OF THE WEST SECTION LINE WAS DETERMINED FROM THE RIGHT-OF-WAY LINE ESTABLISHED BY THE 1986 MOUNTAIN WEST PROFESSIONAL LAND SURVEYOR'S P.C. SURVEY FOR OGDEN CITY #002055. THE RIGHT-OF-WAY IN THIS SURVEY WAS CONFIRMED BY ADDITIONAL DATA FROM THE WEBER COUNTY SURVEYOR'S OFFICE, UNCHANGED AS OF THE PRESENT DATE.

PRIOR SURVEYS USED IN THIS SURVEY:
 GREAT BASIN 1988, SURVEY #000145
 MOUNTAIN WEST PROFESSIONAL LAND SURVEYORS PC 1986, SURVEY #002055

FOUND CL ROAD MONUMENT, OGDEN CITY # 358, RING, LID AND BRASS CAP.

FOUND CL ROAD MONUMENT, OGDEN CITY # 359, RING, LID AND BRASS CAP.

HILL & ARGYLE, Inc.
 Engineering and Surveying
 181 North 200 West, Suite #4, Bountiful, Utah 84010
 (801) 298-2236 Phone, (801) 298-5983 Fax

RECEIVED
 APR 20 2018
 BY: 5990

SURVEY REQUESTED BY
AUTOWASH
 FOR:
 CHADWICK HOMES
 760 WEST EXCHANGE ROAD
 SECTION 30, T6N, R1W, SLB&M
 OGDEN CITY, WEBER COUNTY, UTAH

DRAWN JPC	DATE 6/26/08
APPROVED VRH	DATE 01/02/18
REVISED	DATE
SHEET 1	OF 1
SHEET NAME	Boundary
DRAWING NAME	Boundary
PROJECT NO.	08-211