


D=1°39'51"
 R=1195.17
 L=34.71
 LC=34.71
 N 67°10'06" W

RECEIVED
 JUN 06 2010
 BY: 6019

SURVEYOR'S CERTIFICATE
 I, Tyler D. Knight, do hereby certify that I am a professional land surveyor in the State of Utah and hold certificate no. 9008384-2201 as prescribed by the laws of this State. That I have made a survey of the property(s) shown hereon in accordance with UCA 17-23-17. That this plot was prepared from the field notes of this survey and from documents and records as noted hereon.

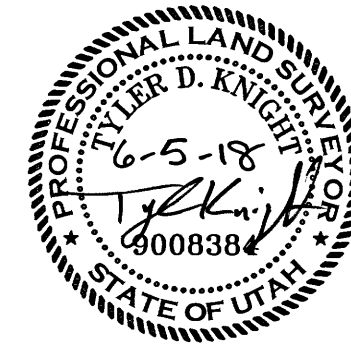

RECORD OF SURVEY

Landmark Surveying, Inc.
 A Complete Land Surveying Service
 www.LandmarkSurveyUtah.com
 4646 South 3500 West - #A-3
 West Haven, UT 84401
 801-731-4075

CLIENT: Keith Webb
 Address: 508 W. Harrisville Rd.
 Harrisville UT, 84404

A part of the NW 1/4 of Section 6, Township 6 North, Range 1 West, Salt Lake Base and Meridian.

Revisions:	DRAWN BY: TB
	CHECKED BY: TDK
	DATE: 4/6/2018
	FILE: 3710