


39000

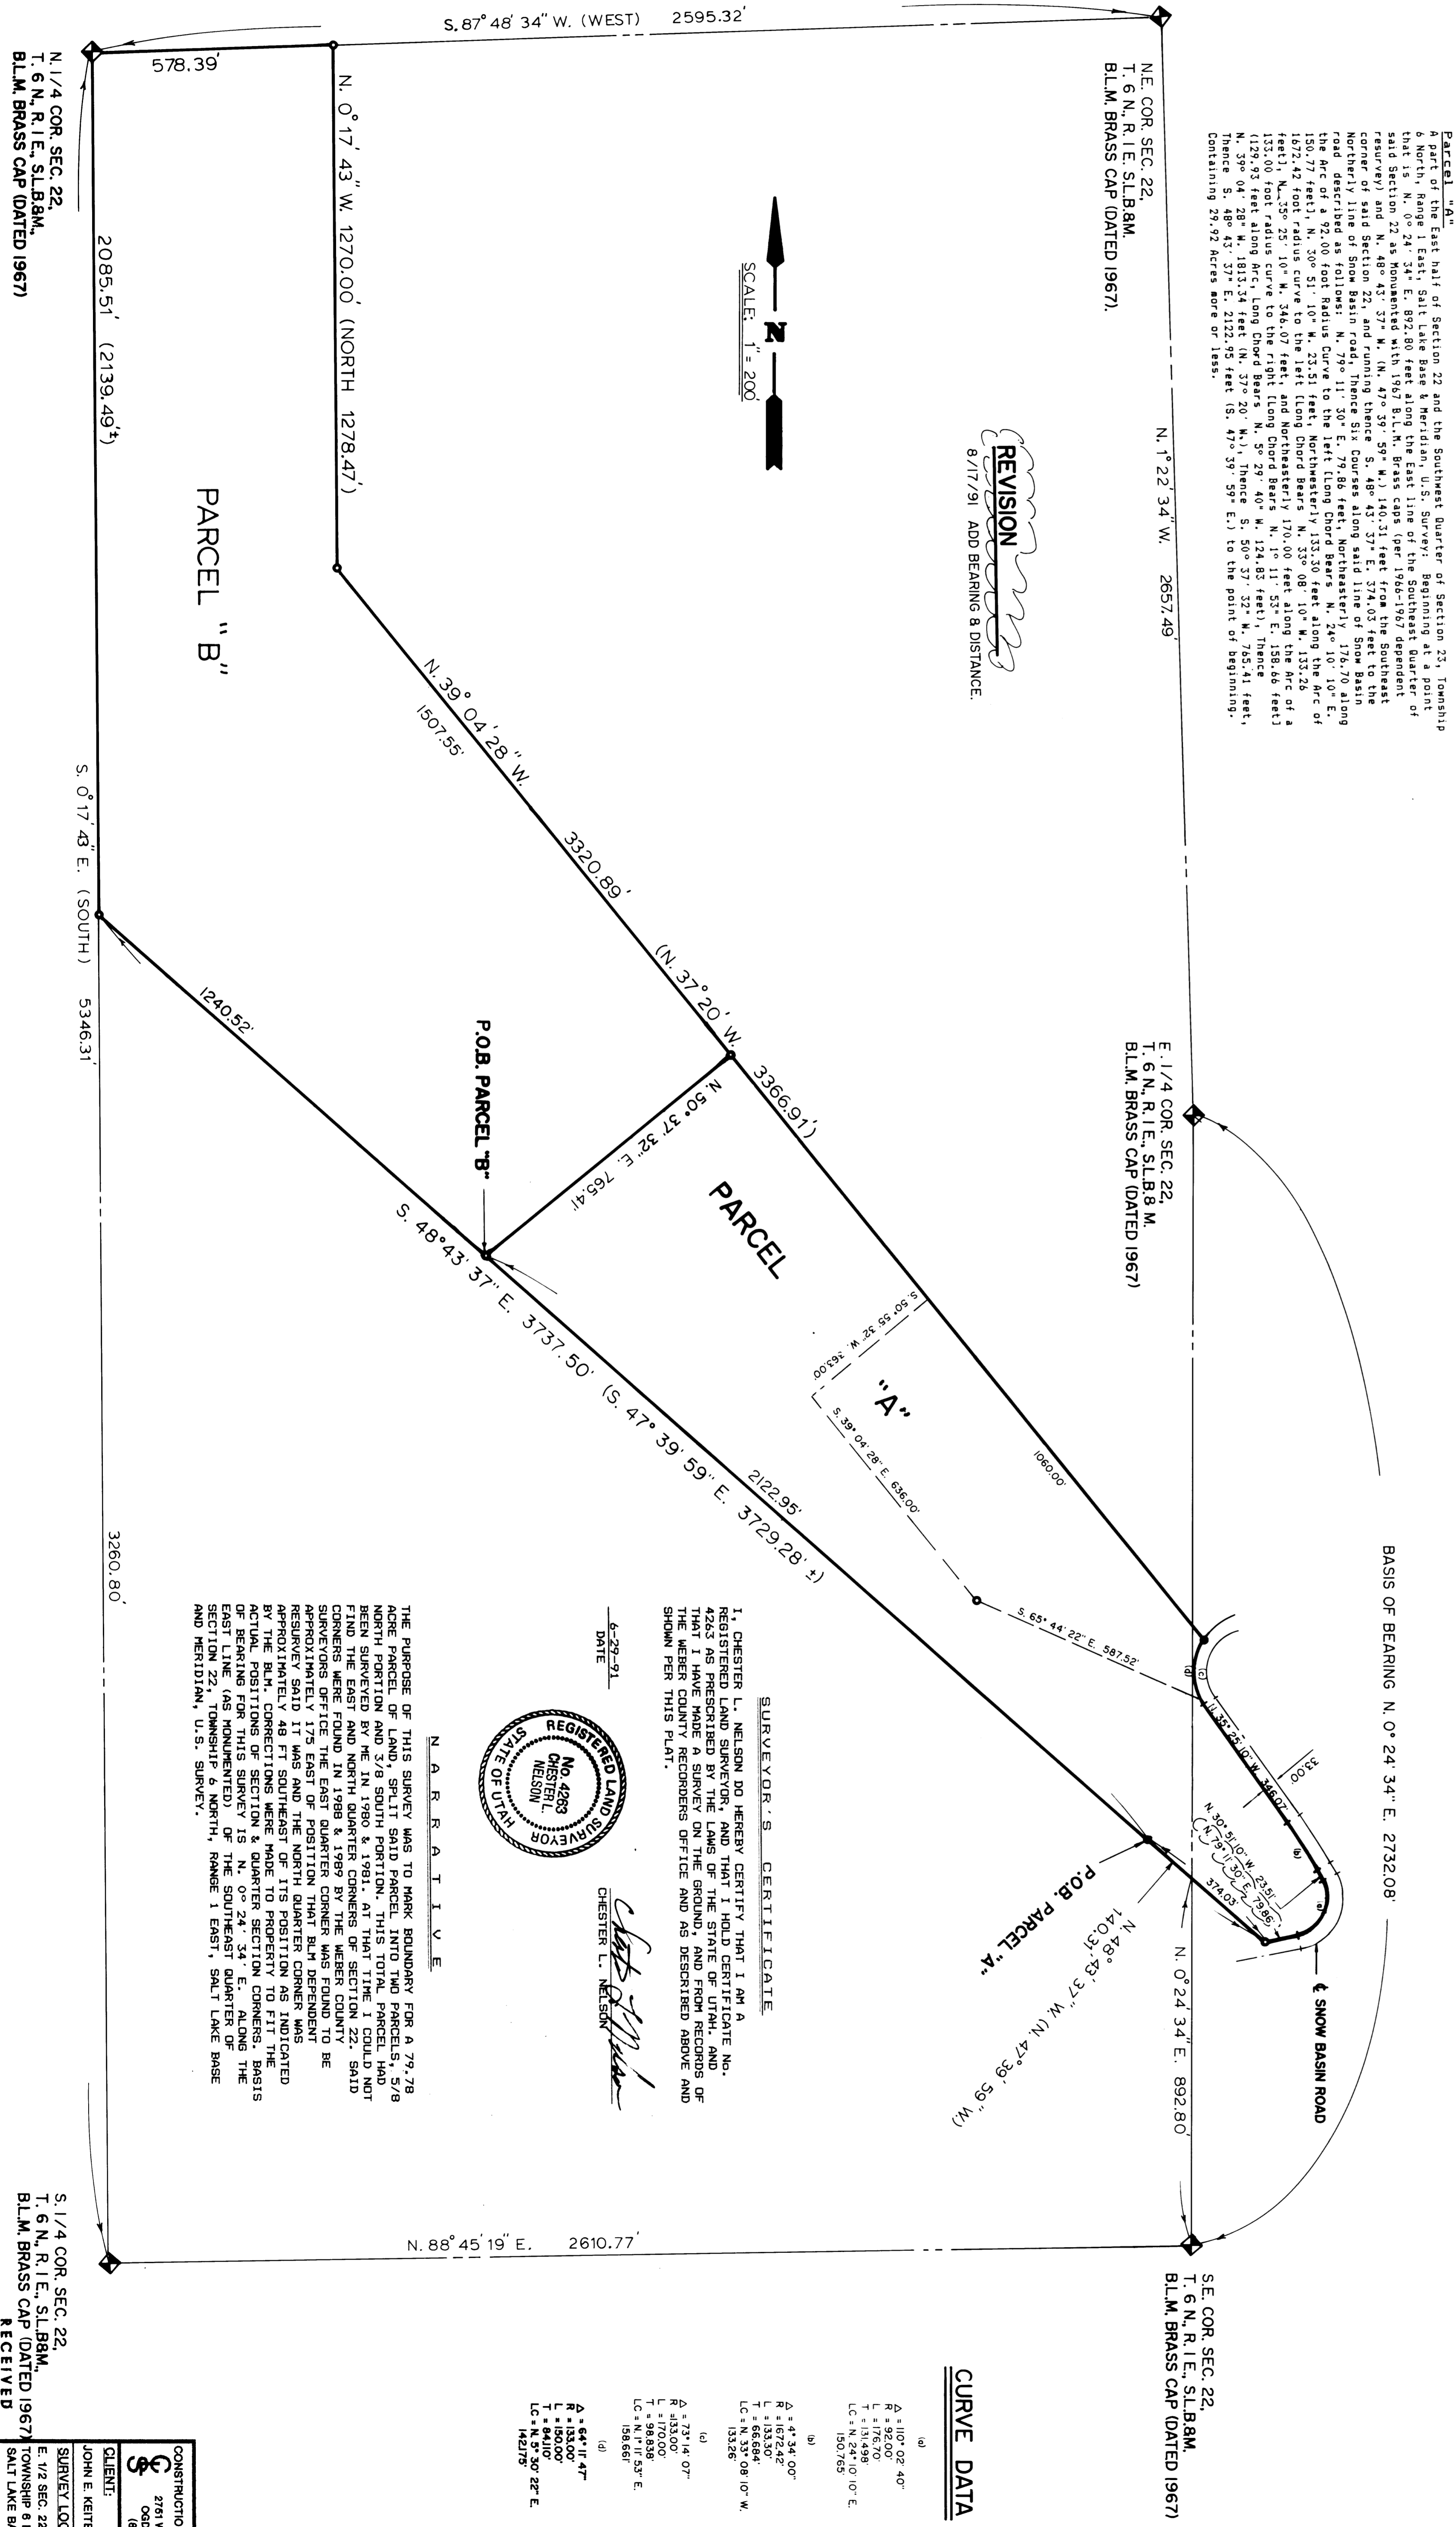

LEGAL DESCRIPTIONS

TOTAL






CURVE DATA


NARRATIVE

THE PURPOSE OF THIS SURVEY WAS TO MARK BOUNDARY FOR A 79.78 ACRES PARCEL IN THE EAST QUARTER OF SECTION 22, TOWNSHIP 6 NORTH, RANGE 1 EAST, SALT LAKE BASE & MERIDIAN, U.S. SURVEY. THIS TOTAL PARCEL HAD BEEN SURVEYED BY ME IN 1980 & 1981. AT THAT TIME I COULD NOT FIND THE EAST AND NORTH QUARTER CORNERS OF SECTION 22. SAID SURVEYING OFFICE THE EAST QUARTER CORNER WAS FOUND TO BE APPROXIMATELY 175 FEET EAST OF POSITION THAT BLM DEPENDENT RESURVEY SAID IT WAS AND THE NORTH QUARTER CORNER WAS INDICATED BY THE BLM. CORRECTIONS WERE MADE TO PROPERTY TO FIT THE ACTUAL POSITIONS OF SECTION & QUARTER SECTION CORNERS. BEARINGS AND DISTANCES OF THE EAST QUARTER CORNER OF THE SECTION 22, TOWNSHIP 6 NORTH, RANGE 1 EAST, SALT LAKE BASE AND MERIDIAN, U.S. SURVEY.



SURVEYOR S. CERTIFICATE
 CHESTER L. NELSON
