


ELIZABETH KEENAN

LOT 8
 241 SOUTH 8600 EAST
 LOCATED IN THE NORTHEAST 1/4 OF SECTION 17, T.6N., R.2E., S.L.B.&M.
 HUNTSVILLE, WEBER COUNTY, UTAH

DRAWN: DW 5/21/2018
 APPROVED: VRH 5/21/2018
 PROJECT: 1521002

C201
 BOUNDARY SURVEY

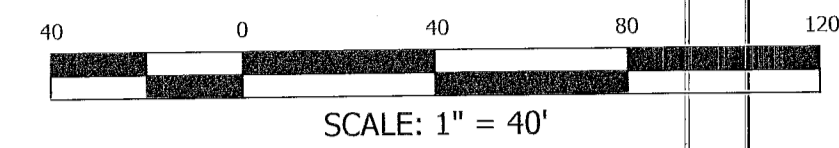

CERTIFICATE

I, VON R. HILL, A PROFESSIONAL LAND SURVEYOR ACCORDING TO THE LAWS OF THE STATE OF UTAH, DO CERTIFY THAT I HAVE SURVEYED THE PARCEL OF GROUND SHOWN HEREON ACCORDING TO UTAH STATE CODE 17-23-17.



NARRATIVE

THE PURPOSE OF THE SURVEY WAS TO MARK THE PROPERTY CORNERS. THE BASIS OF BEARING WAS ESTABLISHED BETWEEN THE MONUMENTS SHOWN. FIELD WORK DONE APRIL 25, 2018.

DESCRIPTION

ALL OF LOT 8 LOCATED IN FIELD OF DREAMS SOUTH FORK SUBDIVISION PLAT 2, PART OF THE NORTHEAST 1/4 OF SECTION 17, TOWNSHIP 6 NORTH, RANGE 2 EAST, SALT LAKE BASE & MERIDIAN, WEBER COUNTY, UTAH SUBDIVISION ENTRY# 1275460 FEB 18, 1994
 CONTAINS 2.28 ACRES

FOUND EAST 1/4 COR. OF SEC. 17, T.6N., R.2E., S.L.B. & M. 0.30' DIA. W.C.S. BRASS CAP WITH X IN CONCRETE COLLAR, FLUSH WITH GROUND.

BASIS OF BEARING
 N00° 00' 00"E
 2370.17'
 (RECORD & MEASURED)

FOUND NORTH WITNESS MON. TO S.E. COR. SEC. 17, T.6N., R.2E., S.L.B. & M. 0.30' DIA. BRASS CAP WITH X IN CONCRETE COLLAR 0.5' ABOVE GROUND.

RECEIVED
 DEC 16 2018
 BY 6142

LEGEND

PROPERTY LINE	—————
ADJACENT PROPERTY	- - - - -
SECTION LINE	-----
TIE TO MONUMENT	- · - · -
EDGE OF PAVEMENT	· · · · ·
CHAIN LINK FENCE LINE	— · — · —
RECORD CALLS ()	()
SET 5/8" REBAR WITH H&A ENTELLUS CAP, LS #166385, AT CORNER (UNLESS OTHERWISE NOTED)	●
FOUND PROPERTY MARKER (AS NOTED)	○

