


PLAN HOLD CORPORATION • IRVINE, CALIFORNIA
PROJECT BY NUMBER 07548
PROJECT USE OF FEASIBILITY STUDY





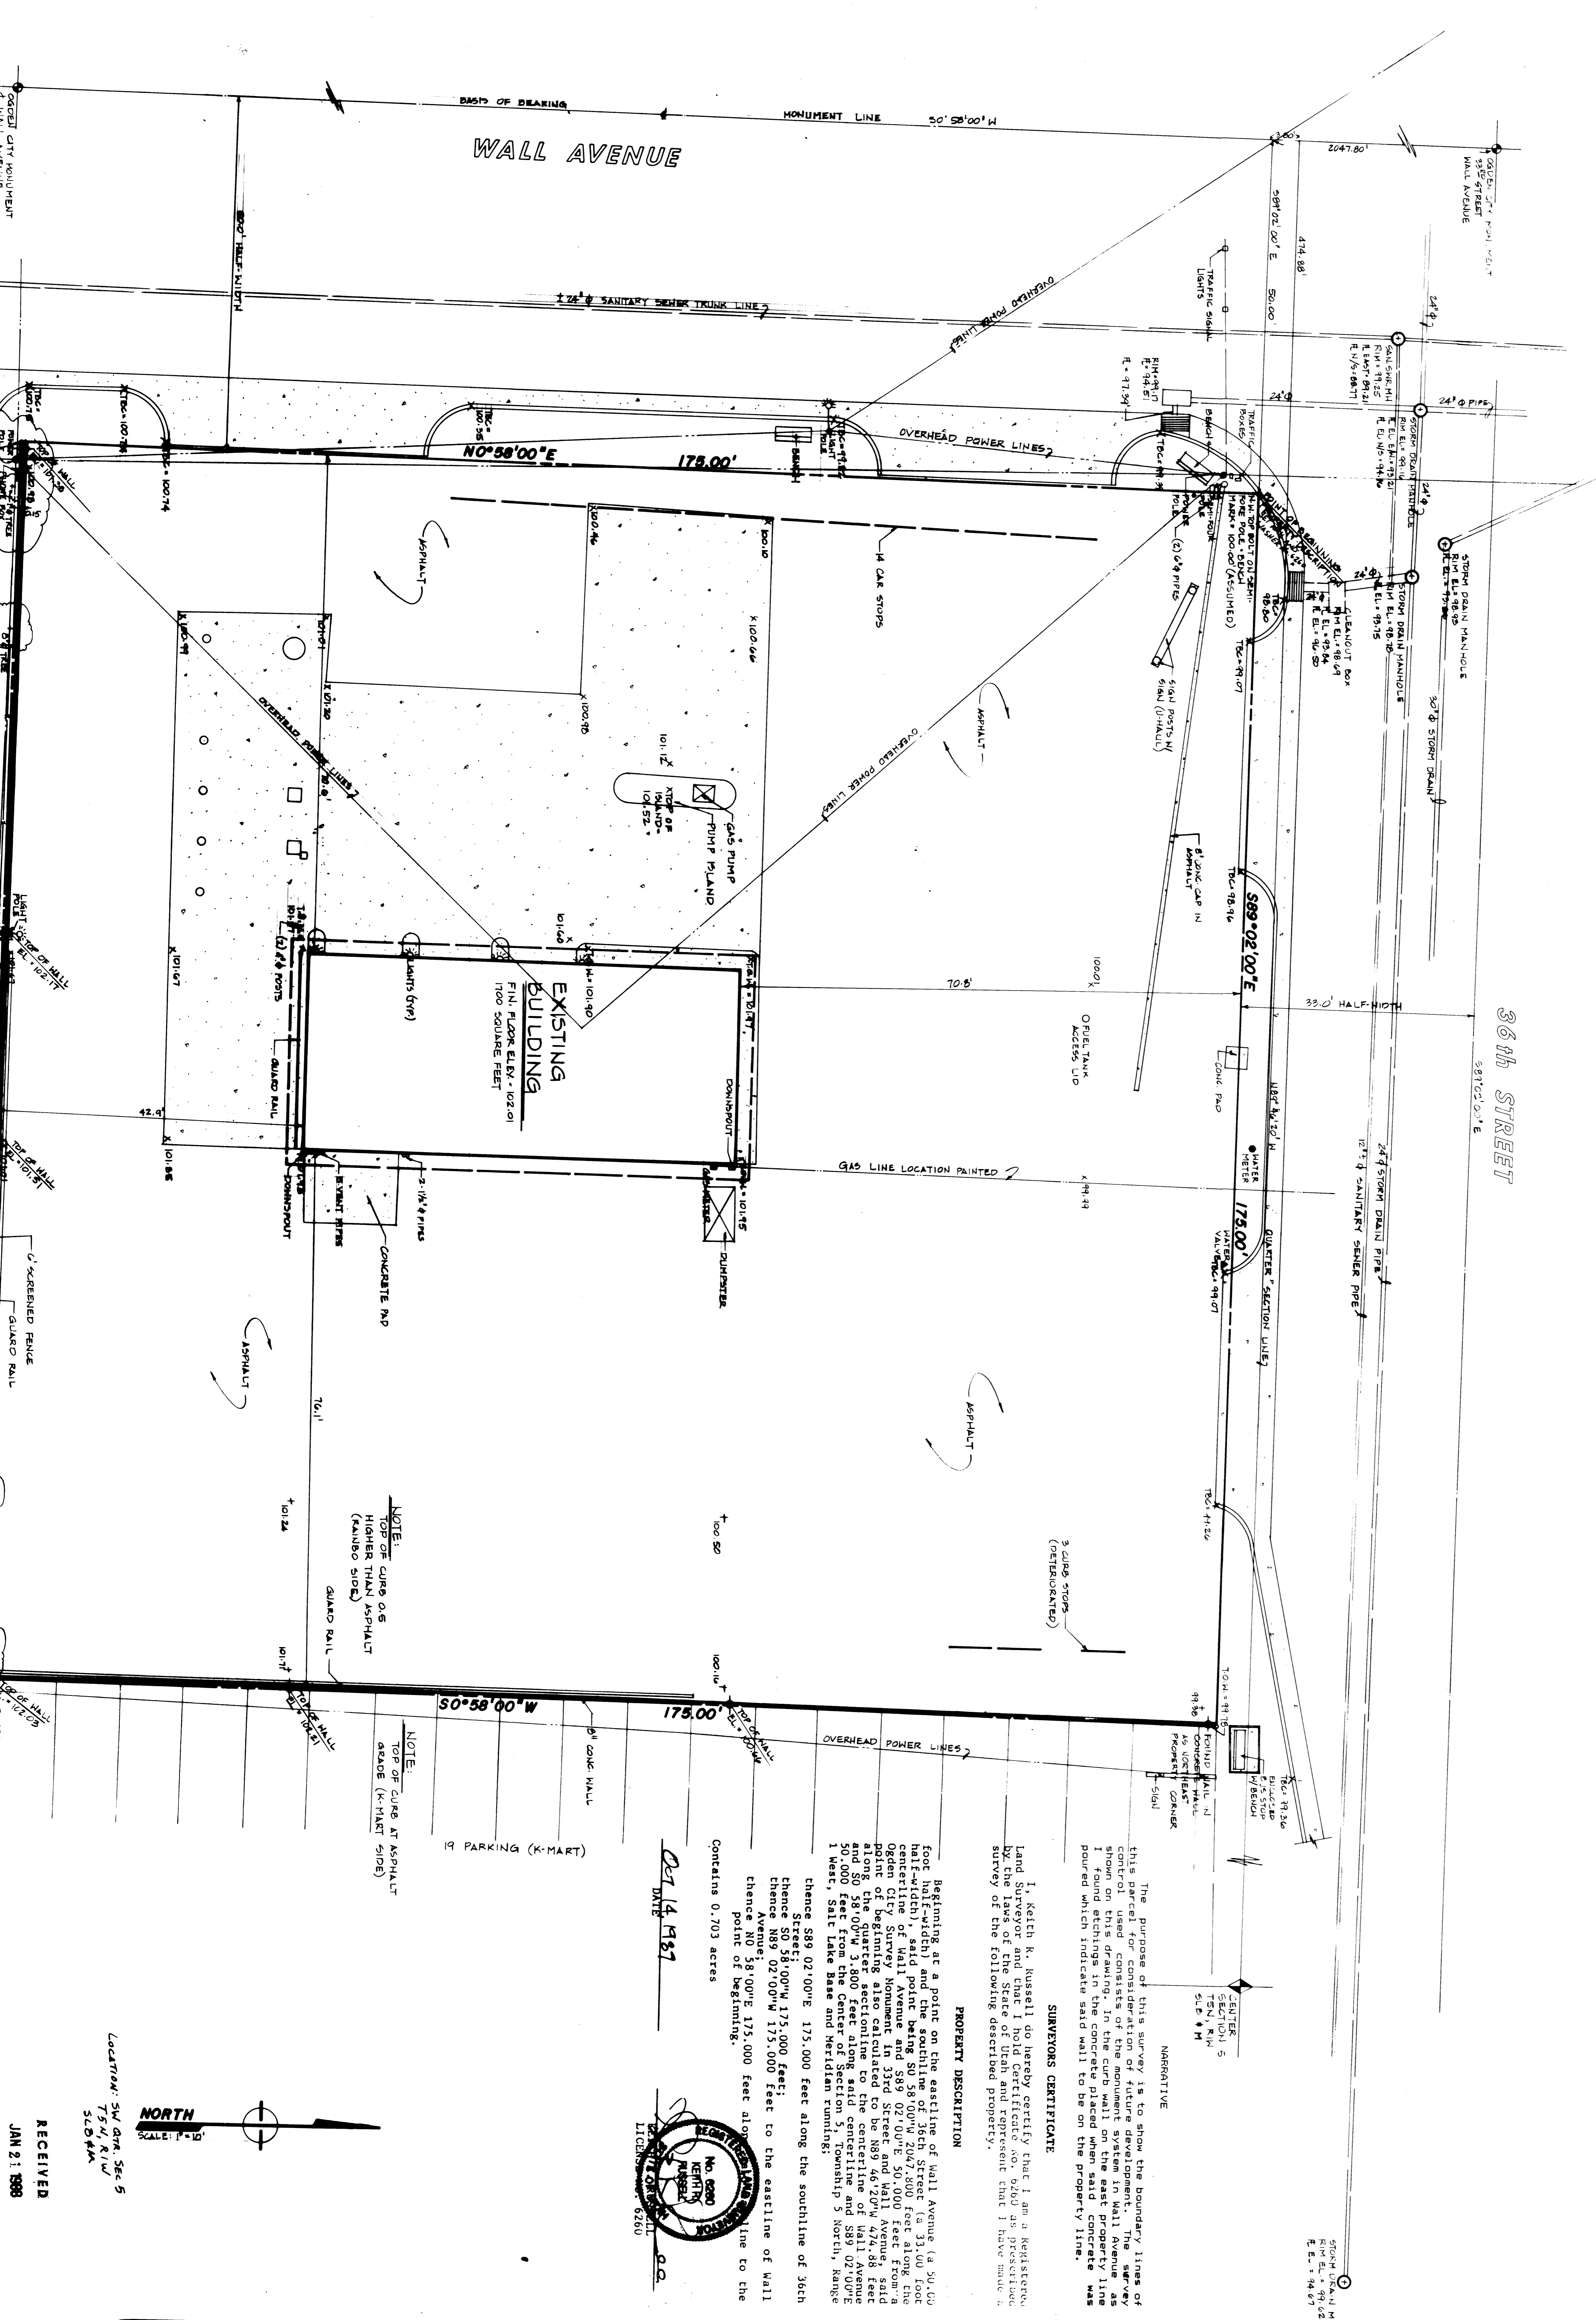

NOTE:
TOP OF CURB AS HIGHER THAN ASPHALT (RAINAGE SIDE)

NOTE:
TOP OF CURB AT ASPHALT (K-MART SIDE)

DATE: 14 1987

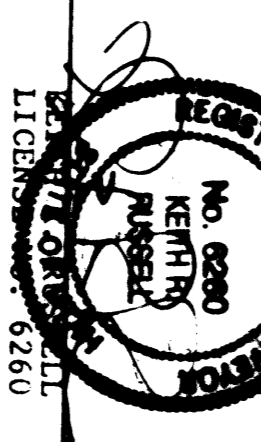

PROPERTY DESCRIPTION



 chence S 89° 02' 00" E 175.000 feet along the southeast of 36th Street;
 chence S 0° 58' 00" W 175.000 feet;
 chence N 0° 58' 00" W 175.000 feet along the eastline to the point of beginning.
 Contains 0.703 acres

SURVEYORS CERTIFICATE


NARRATIVE


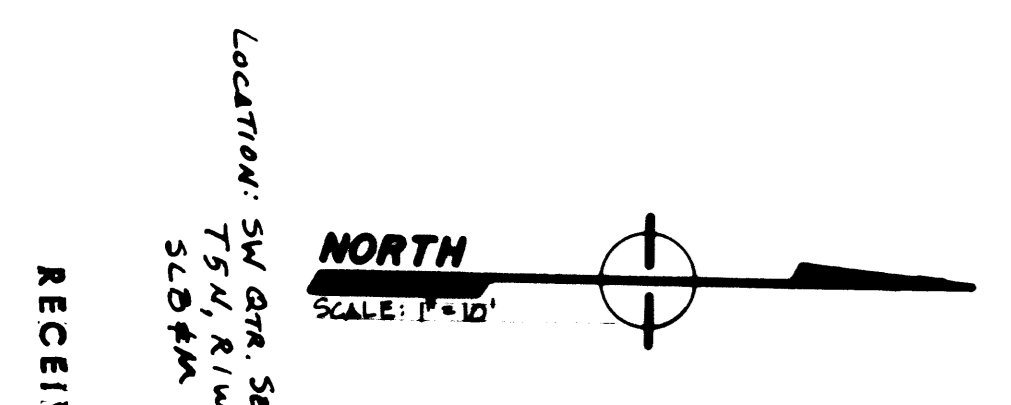


RECEIVED
JAN 21 1988

BOUNDARY & TOPOGRAPHY SURVEY
36th STREET & WALL AVENUE
SOUTH OGDEN, UTAH
RANCO OIL COMPANY

BONNEVILLE ENGINEERING
CONSULTING ENGINEERS
SALT LAKE CITY, UTAH

