


**SURVEYORS CERTIFICATE**

I, Larry M. Buttars, a registered Land Surveyor as prescribed by the laws of the State of Utah, and holding licence No. 2596, do hereby certify that I made a survey of the below described property and the Plat hereon is a true and correct representation of said survey.

Date: 8-19-91 Sign: \_\_\_\_\_

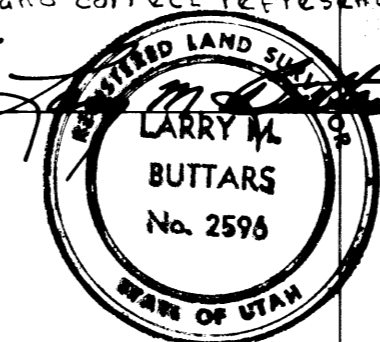

**DESCRIPTION**

A part of the S.E. 1/4 of section 22, T.5N., R.1W., S.L.B. & M., U.S. Survey: Beginning at a point S. 0° 20' 49" E. along the 1/4 Sec. line 990.0 ft. and S. 89° 13' 28" E. 1455.55 ft. from the Northwest corner of said 1/4 section, and running thence N. 0° 46' 32" E. 330.0 ft., thence S. 89° 13' 28" E. 374.81 ft., thence S. 31° 30' 28" E. 317.37 ft. to a point N. 89° 13' 36" W. 180.78 ft. from the West-erly line of Wasatch Drive, thence S. 89° 13' 36" E. 180.78 ft., thence S. 31° 06' 22" E. along said Westerly line of Wasatch Drive 70.04 ft., thence N. 89° 13' 28" W. 763.53 ft. to the point of beginning.  
contains 3.88 Acres

**NARRATIVE**

This survey was made to establish the boundaries of property.  
Basis of bearings is the West line of the Southeast Quarter of Section 22, called S. 0° 20' 49" E., the Utah State grid bearing, as provided by the Weber County Surveyors Office.  
Survey corner markers found (Cox survey) and the location of Wasatch Drive were used in addition to occupation to determine the tie East (1481 ft.) is in error and that the true distance East from the Section line to the point of beginning should be 1455.55 ft.

**LEGEND**

- Set 3/4" x 24" re-bar with plastic cap stamped L. Buttars R.L.S. 2596
- Set P.K. nail with ribbon

RECEIVED

DEC 03 1991

Weber County Surveyor

<b>BUTTARS SURVEYING</b>	
1815 26 <sup>TH</sup> STREET OGDEN, UT. 84401 PHONE 392-5291	
CLIENT: PAM NAISBITT	
SURVEY LOCATION: S.E. 1/4 SEC. 22, T.5N., R.1W. WEBER COUNTY, UTAH	
SURVEY DATE: 8-1-91	