


000628

000628

000628

000628

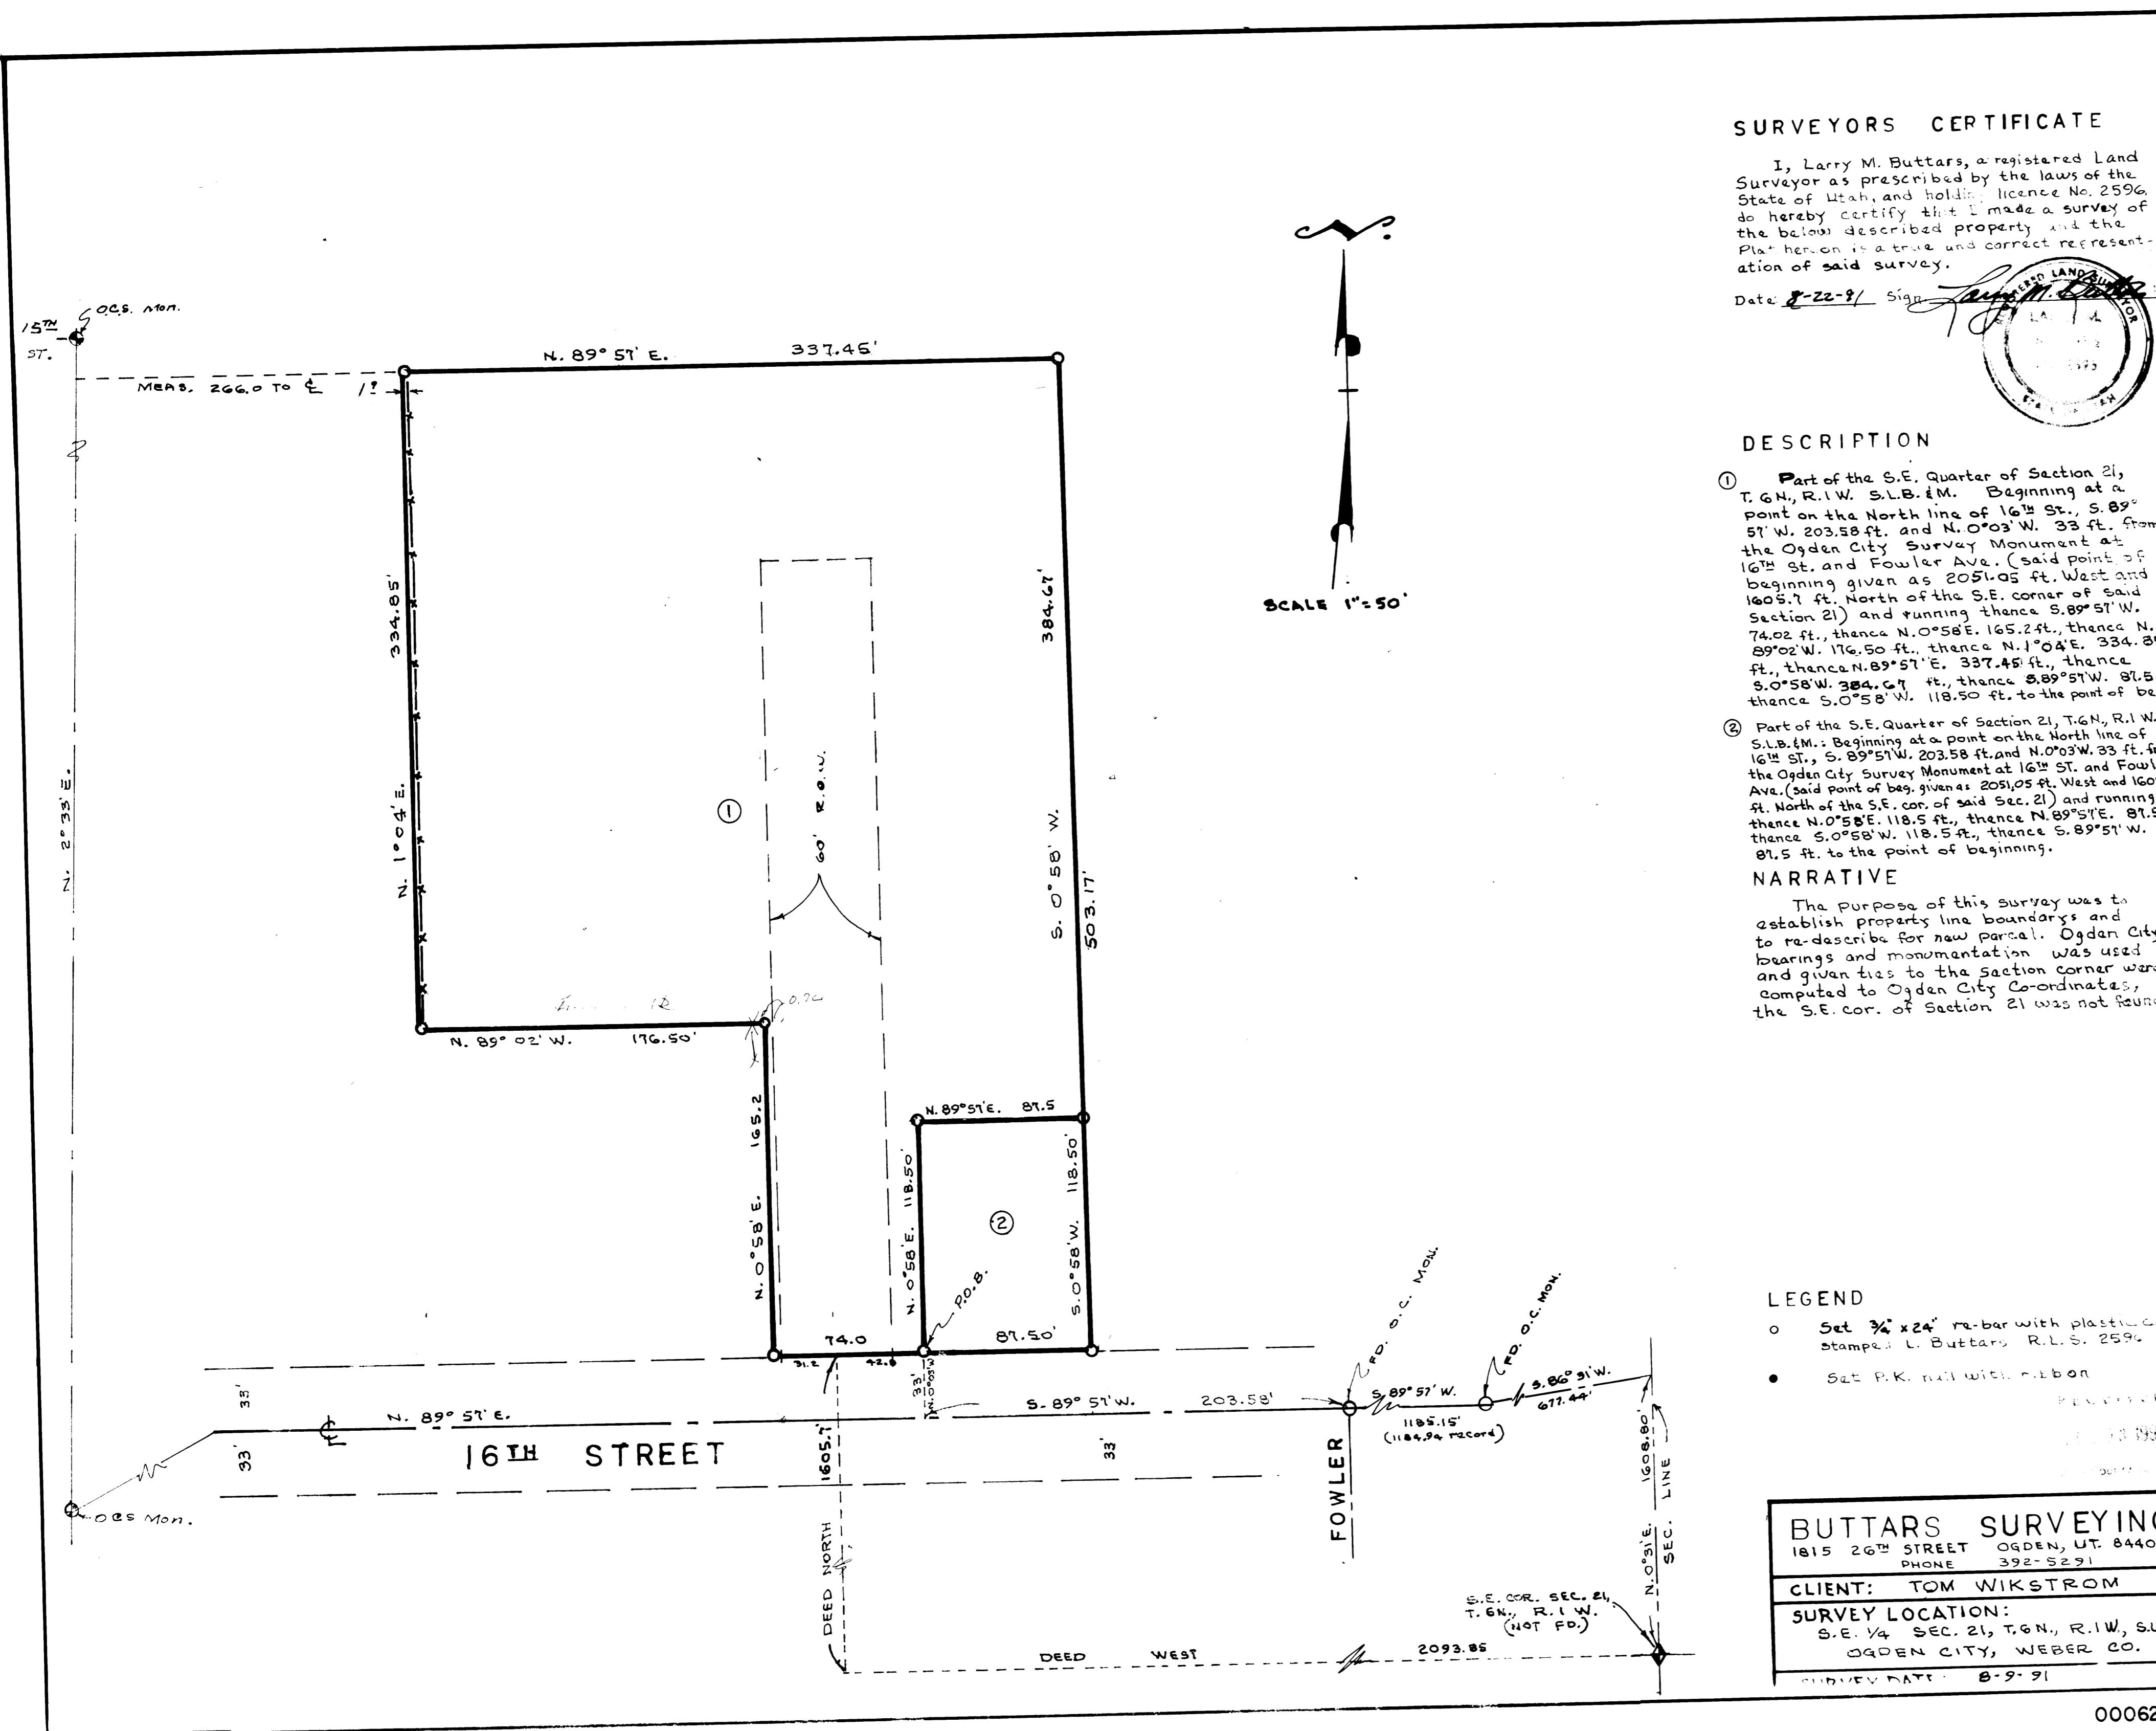

000628