


DATE: 07-17-13
 SCALE: 1" = 40'
 PROJECT NUMBER: 1301001

RECORD OF SURVEY FOR WESTERN COATING, INC.
 A PORTION OF LOT 5, WEBER INDUSTRIAL PARK, PLAT A
 LYING AND SITUATE IN THE NORTHEAST QUARTER OF SECTION 36,
 TOWNSHIP 7 NORTH, RANGE 2 WEST, SALT LAKE BASE AND MERIDIAN

Boundary Consultants
 Professional Land Surveyors
 1295 North 1700 West, Farr West, Utah
 801-792-1569 801-690-7158 FAX

DESIGNED	DEH	DRAWN	DEH	CHECKED	DEH
SHEET	1				
OF	1				

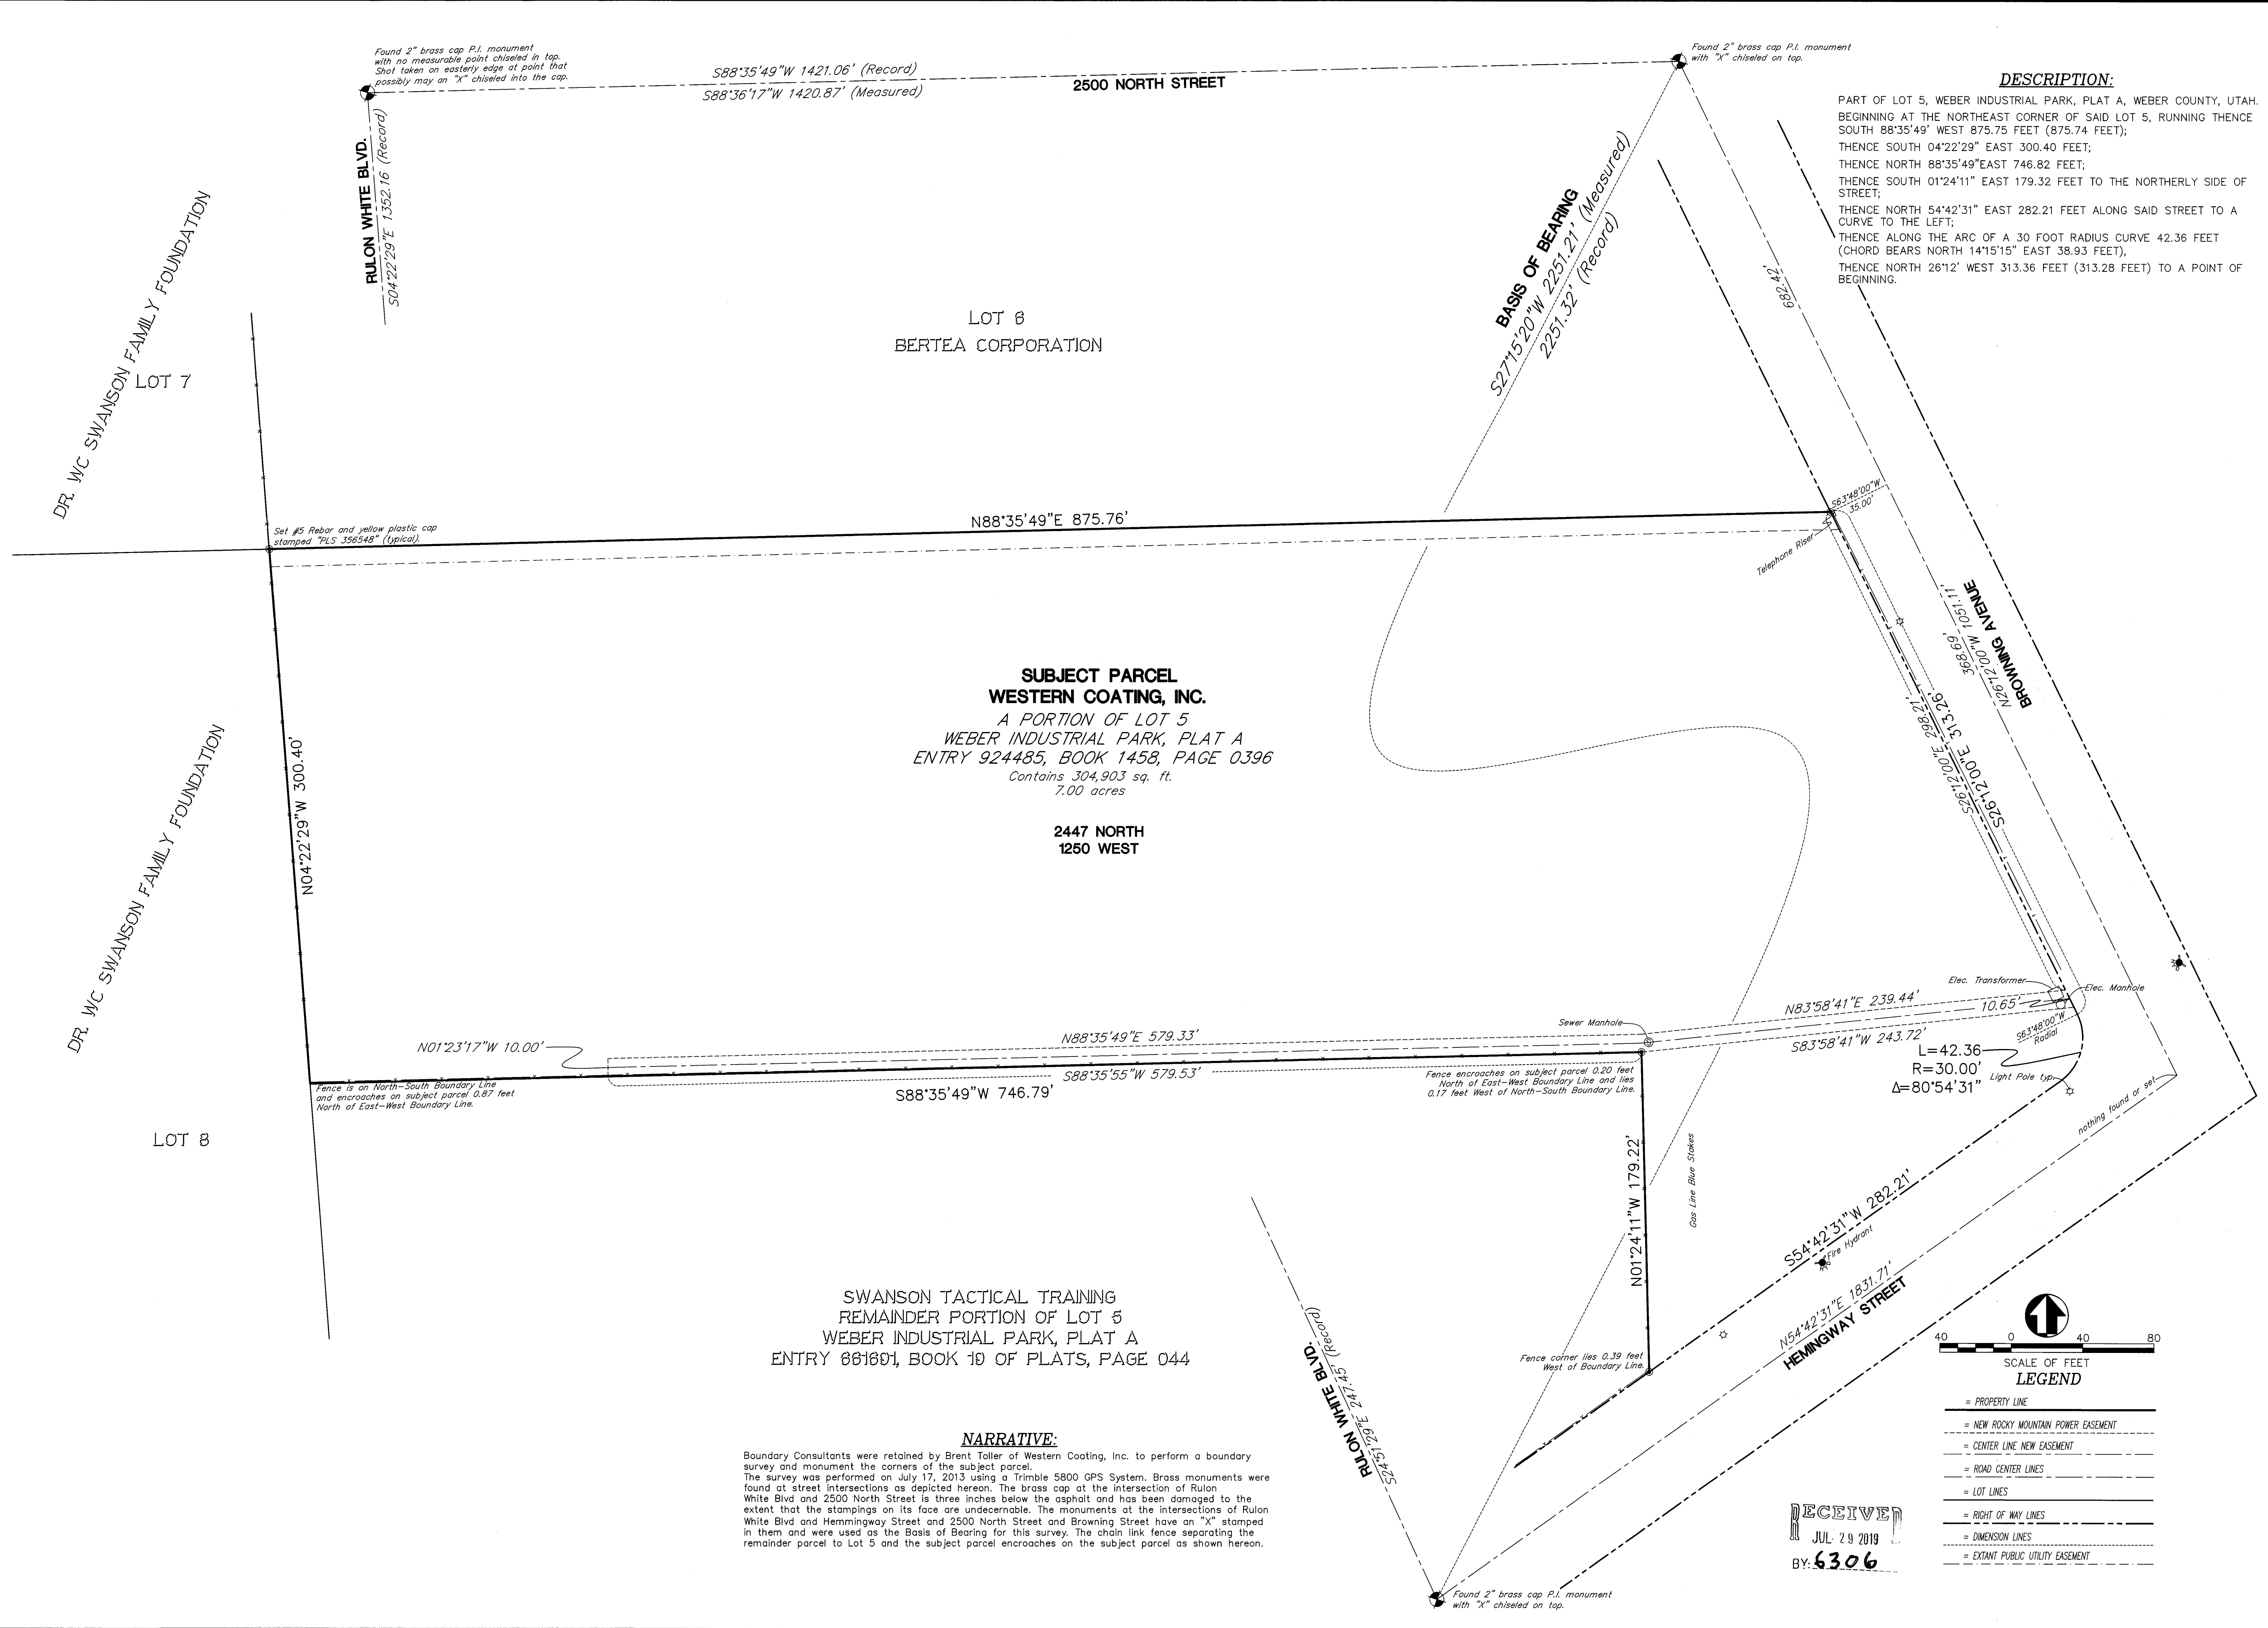

RECEIVED
 BY: 6306