



Scale: 1" = 150'

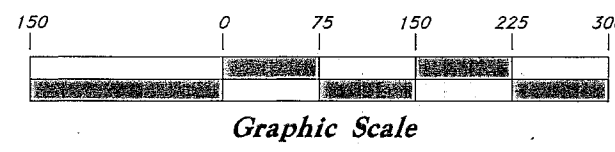

Legend

(Note: All items may not appear on drawing)

- San. Sewer Manhole
- Water Manhole
- Storm Drain Manhole
- Cleanout
- Electrical Manhole
- Catch Basins
- Exist. Fire Hydrant
- Fire Hydrant
- Fire Department Connection
- Post Indicator Valve
- Exist. Water Valve
- Water Valve
- Sanitary Sewer
- Culinary Water
- Gas Line
- Irrigation Line
- Storm Drain
- Telephone Line
- Secondary Waterline
- Power Line
- Fire Line
- Land Drain
- Power pole
- Power pole w/guy
- Light Pole
- Fence
- Flowline of ditch
- Overhead Power line
- Corrugated Metal Pipe
- Concrete Pipe
- Reinforced Concrete Pipe
- Ductile Iron
- Polyvinyl Chloride
- Top of Asphalt
- Edge of Asphalt
- Centerline
- Flowline
- Finish Floor
- Top of Curb
- Top of Wall
- Top of Walk
- Top of Concrete
- Natural Ground
- Finish Grade
- Match Existing
- Fire Department Connection
- Finish Contour
- Exist. Contour
- Finish Grade
- Exist. Grade
- Ridge Line
- Direction of Flow
- Existing Asphalt
- New Asphalt
- Heavy Duty Asphalt
- Existing Concrete
- Tree To Remain in Place
- Cluster of Trees
- Stream Channel (Orange Pins)
- Wetland Boundary (Pink Pins)
- Stream Channel
- Wetlands

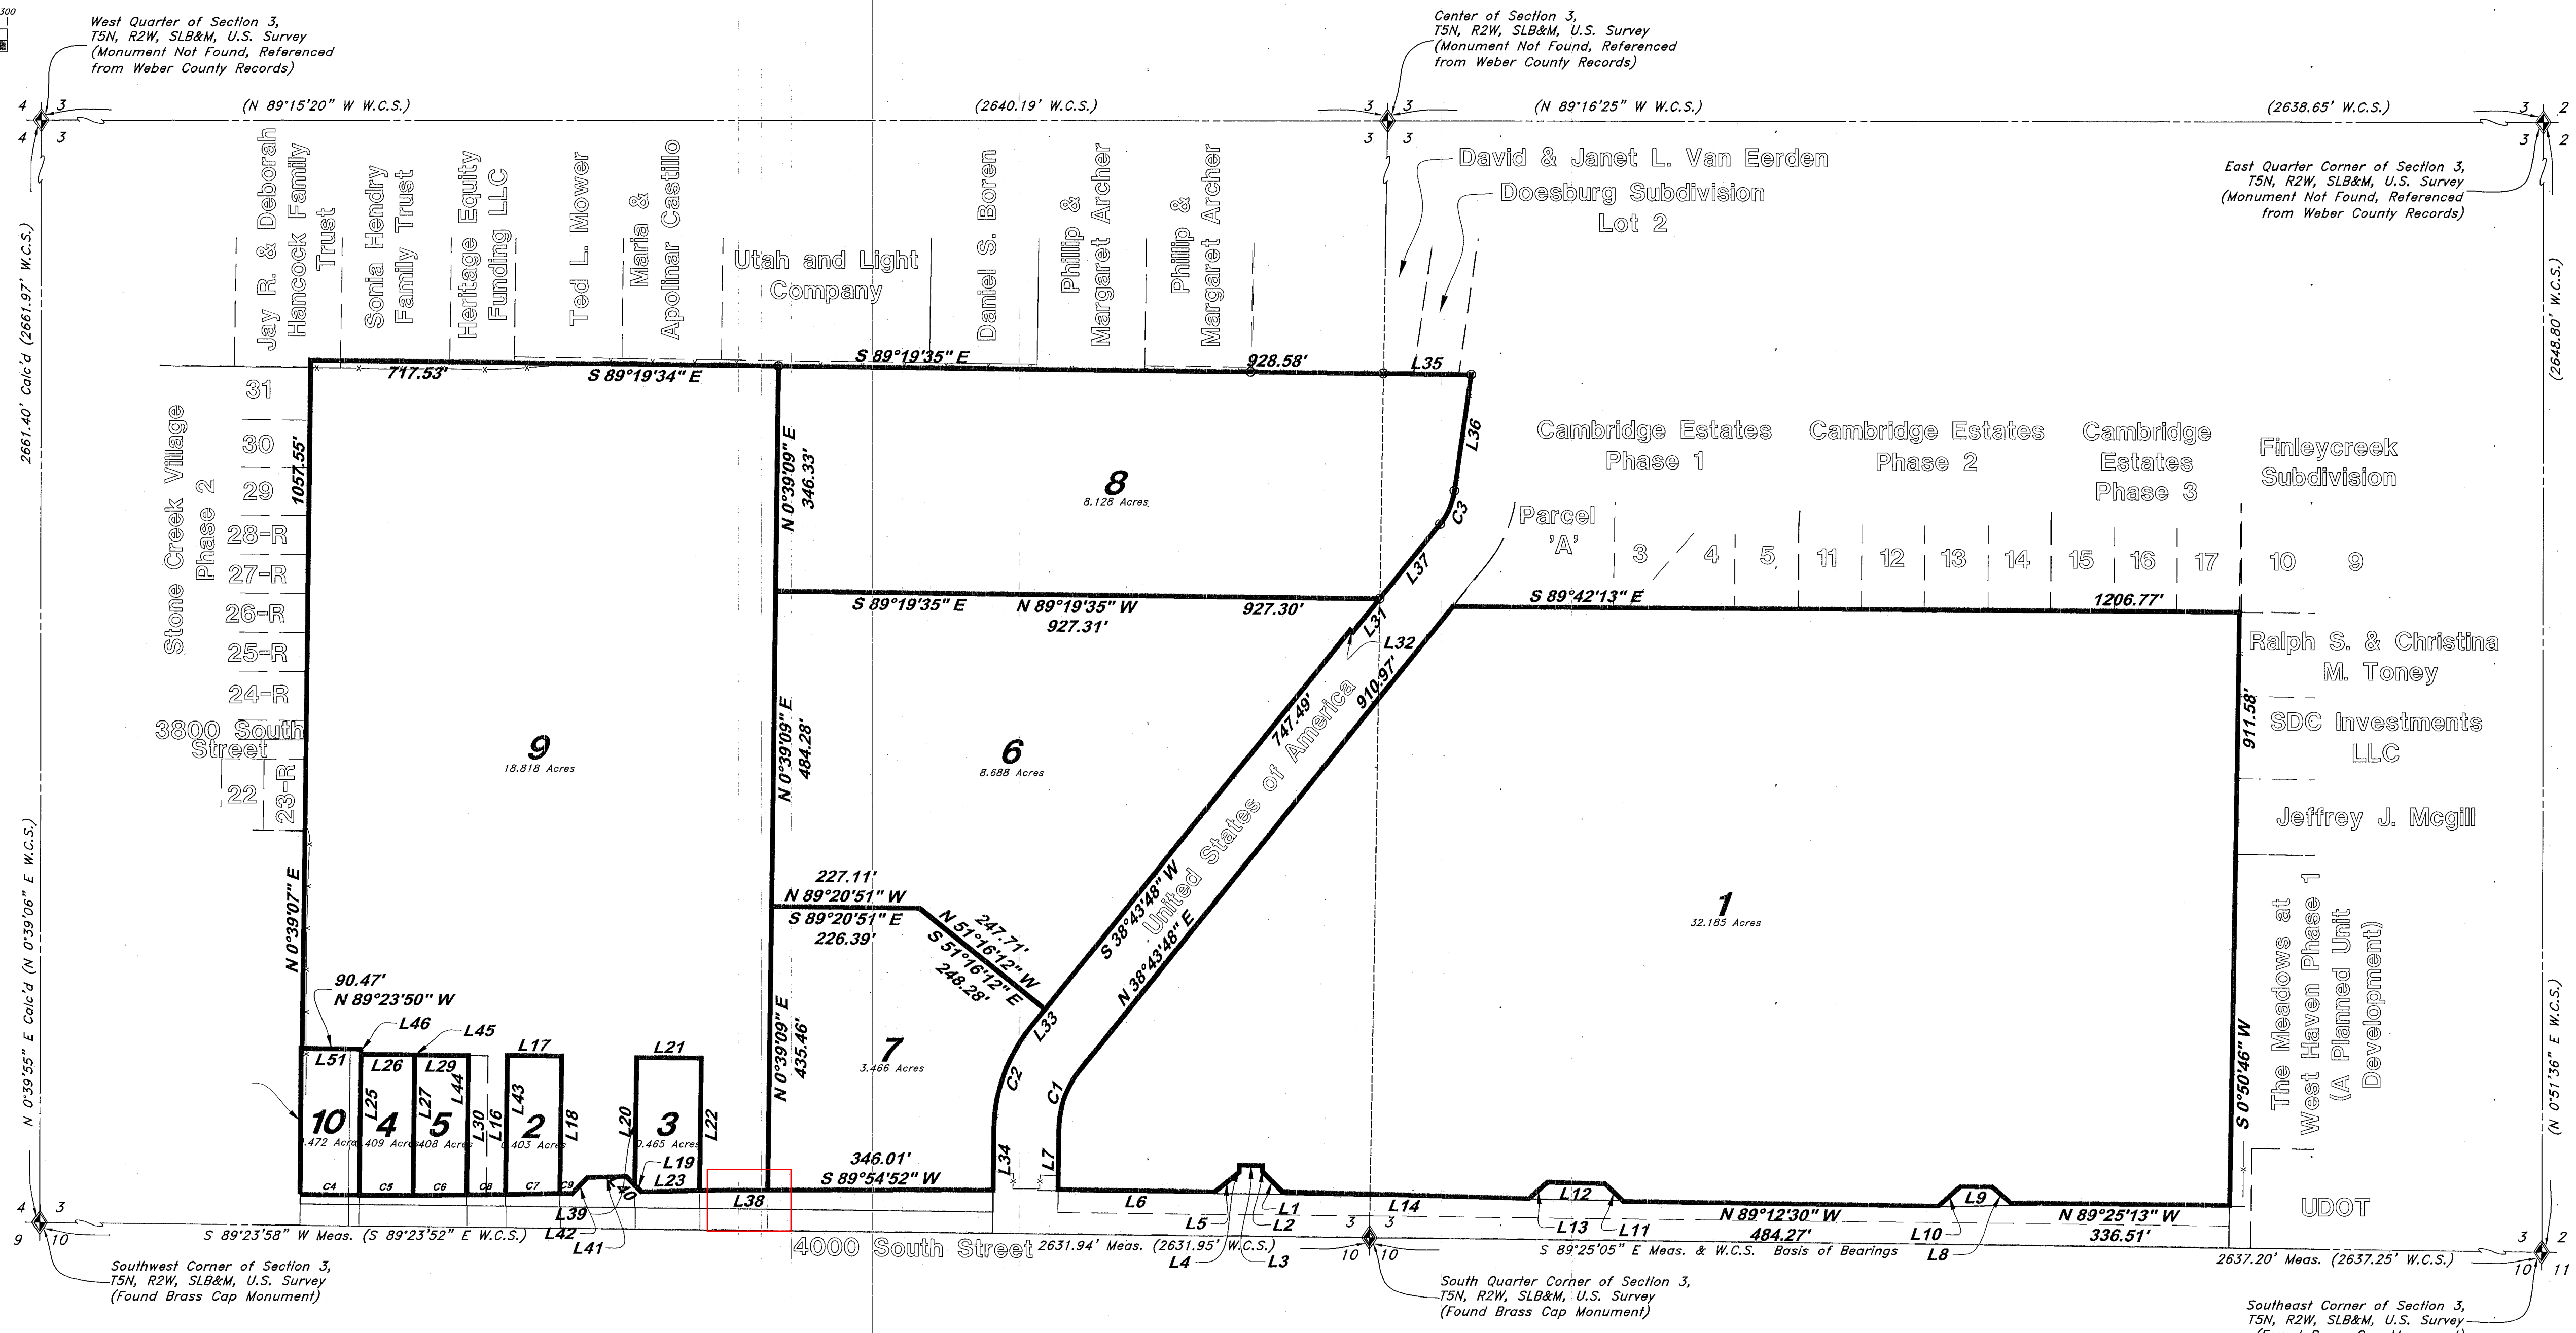

Curve	Delta	Radius	Length	Chord	Chord Bearing
C1	38°07'54"	150.00'	99.83'	98.00'	N 19°39'48" E
C2	38°07'56"	250.00'	166.39'	163.33'	S 19°39'48" W
C3	30°36'00"	105.00'	56.08'	55.41'	S 23°25'48" W
C4	0°33'23"	9359.00'	90.87'	90.87'	S 89°18'05" E
C5	0°30'18"	9359.00'	82.50'	82.50'	N 89°49'56" W
C6	0°30'19"	9359.00'	82.52'	82.52'	S 89°39'46" W
C7	0°30'19"	9359.00'	82.55'	82.55'	S 88°47'30" W
C8	0°21'57"	9359.00'	59.76'	59.76'	S 89°13'58" W
C9	0°06'58"	9359.00'	18.97'	18.97'	S 88°28'51" W


Line	Bearing	Length
L1	N 44°49'07" W	43.11
L2	N 0°23'56" E	9.25
L3	N 88°27'49" W	35.00
L4	S 0°23'56" W	11.16
L5	S 51°30'06" W	47.99
L6	N 89°19'02" W	240.39
L7	N 0°35'40" E	93.24
L8	N 49°27'20" W	37.49
L9	N 89°23'35" W	47.00
L10	S 48°36'23" W	45.45
L11	N 46°05'08" W	38.57
L12	N 88°27'49" W	88.00
L13	S 49°10'02" W	38.58
L14	N 88°27'49" W	378.75
L16	N 0°36'06" E	213.92
L17	S 89°23'54" E	82.50
L18	S 0°35'59" W	211.32

Line	Bearing	Length
L19	N 45°39'45" W	14.25
L20	N 0°35'24" E	196.54
L21	S 89°24'41" E	99.00
L22	S 0°35'25" W	203.52
L23	S 88°43'41" W	88.75
L25	N 0°36'06" E	216.43
L26	S 89°23'54" E	82.50
L27	S 0°36'06" W	215.80
L29	S 89°23'54" E	82.50
L30	S 0°36'00" W	214.45
L31	S 38°43'48" W	65.28
L32	N 51°16'12" W	5.00
L33	S 38°43'48" W	36.86
L34	S 0°35'48" W	94.44
L35	S 89°20'45" E	134.82
L36	S 0°07'48" W	180.41
L37	S 38°43'48" W	147.82


Line	Bearing	Length
L38	S 89°55'17" W	55.71
L39	S 0°35'24" W	196.54
L40	N 45°39'45" W	19.34
L41	S 88°43'41" W	59.51
L42	S 43°44'17" W	33.75
L43	S 0°36'12" W	213.91
L44	N 0°36'06" E	214.44
L45	N 89°23'50" W	165.27
L46	N 0°36'06" E	8.25
L50	S 0°11'12" W	224.57
L51	N 89°22'00" W	92.23

NOTES

1. Utilities shown are from observed evidence on the site and records available at the time of the survey.
2. No encroachments were found other than what is shown on the drawing.
3. There no were delineation markers observed in process of conducting the fieldwork indicating a prior delineation of wetlands.
4. This property is approximately 1350 feet from the Intersection of 4000 South and Midland Drive.
5. There are no constructed buildings on this site.
6. There are no striped parking stalls on this site.

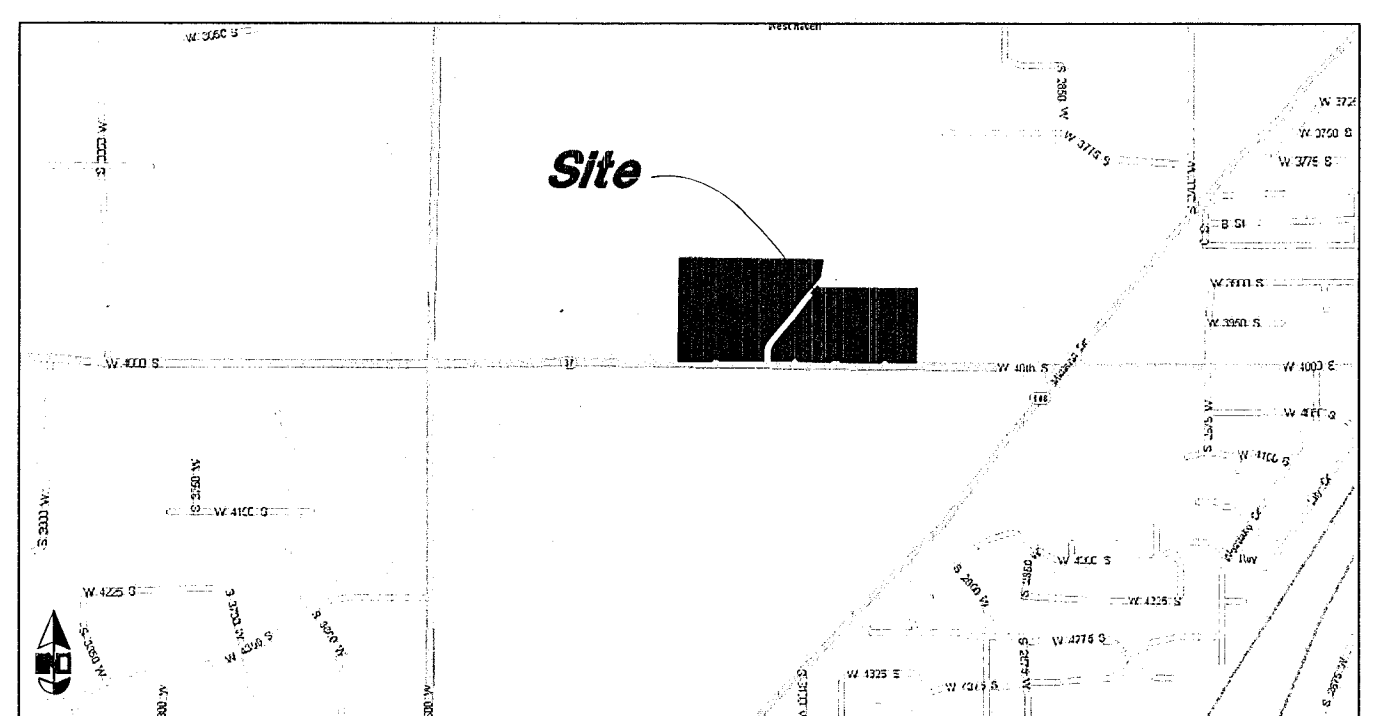

VICINITY MAP
Not to Scale

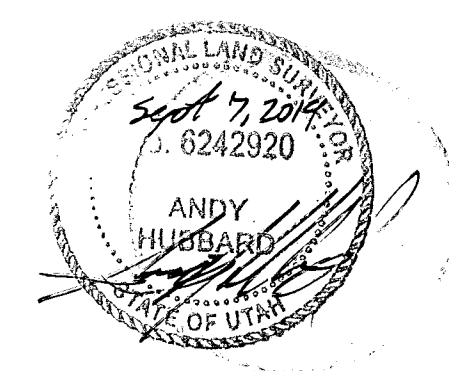

DATE: AUG 11 2018
BY: B. B. B.


GREAT BASIN ENGINEERING
 5746 SOUTH 1475 EAST OGDEN, UTAH 84403
 MAIN (801)394-4515 SALC (801)392-7544
 WWW.GREATBASINENGINEERING.COM

ALTA/NSPS Land Title Survey
Salt Point - West Haven
 Approx. 3650 South 3700 West
 West Haven City, Weber County, Utah
 A part of Section 3, T5N, R2W, SLB&M, U.S. Survey


Legend

(Note: All items may not appear on drawing)


- San. Sewer Manhole
- Water Manhole
- Storm Drain Manhole
- Cleanout
- Electrical Manhole
- Catch Basins
- Exist. Fire Hydrant
- Fire Hydrant
- Fire Department Connection
- Post Indicator Valve
- Exist. Water Valve
- Water Valve
- Sanitary Sewer
- Culinary Water
- Gas Line
- Irrigation Line
- Storm Drain
- Telephone Line
- Secondary Waterline
- Power Line
- Fire Line
- Land Drain
- Power pole w/guy
- Light Pole
- Fence
- Flowline of ditch
- Overhead Power line
- Corrugated Metal Pipe
- Concrete Pipe
- Reinforced Concrete Pipe
- Ductile Iron
- Polyvinyl Chloride
- Top of Asphalt
- Edge of Asphalt
- Centerline
- Flowline
- Finish Floor
- Top of Curb
- Top of Wall
- Top of Walk
- Top of Concrete
- Natural Ground
- Finish Grade
- Match Existing
- Fire Department Connection
- Finish Contour
- Exist. Contour
- Finish Grade
- Exist. Grade
- Ridge Line
- Direction of Flow
- Existing Asphalt
- New Asphalt
- Heavy Duty Asphalt
- Existing Concrete
- Tree To Remain in Place
- Cluster of Trees
- Stream Channel (Orange Pins)
- Welland Boundary (Pink Pins)
- Stream Channel
- Wellands

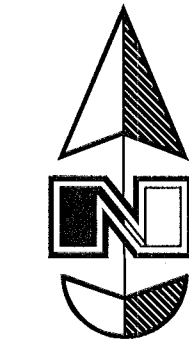

Scale: 1" = 80'

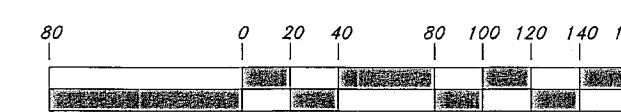

Graphic Scale

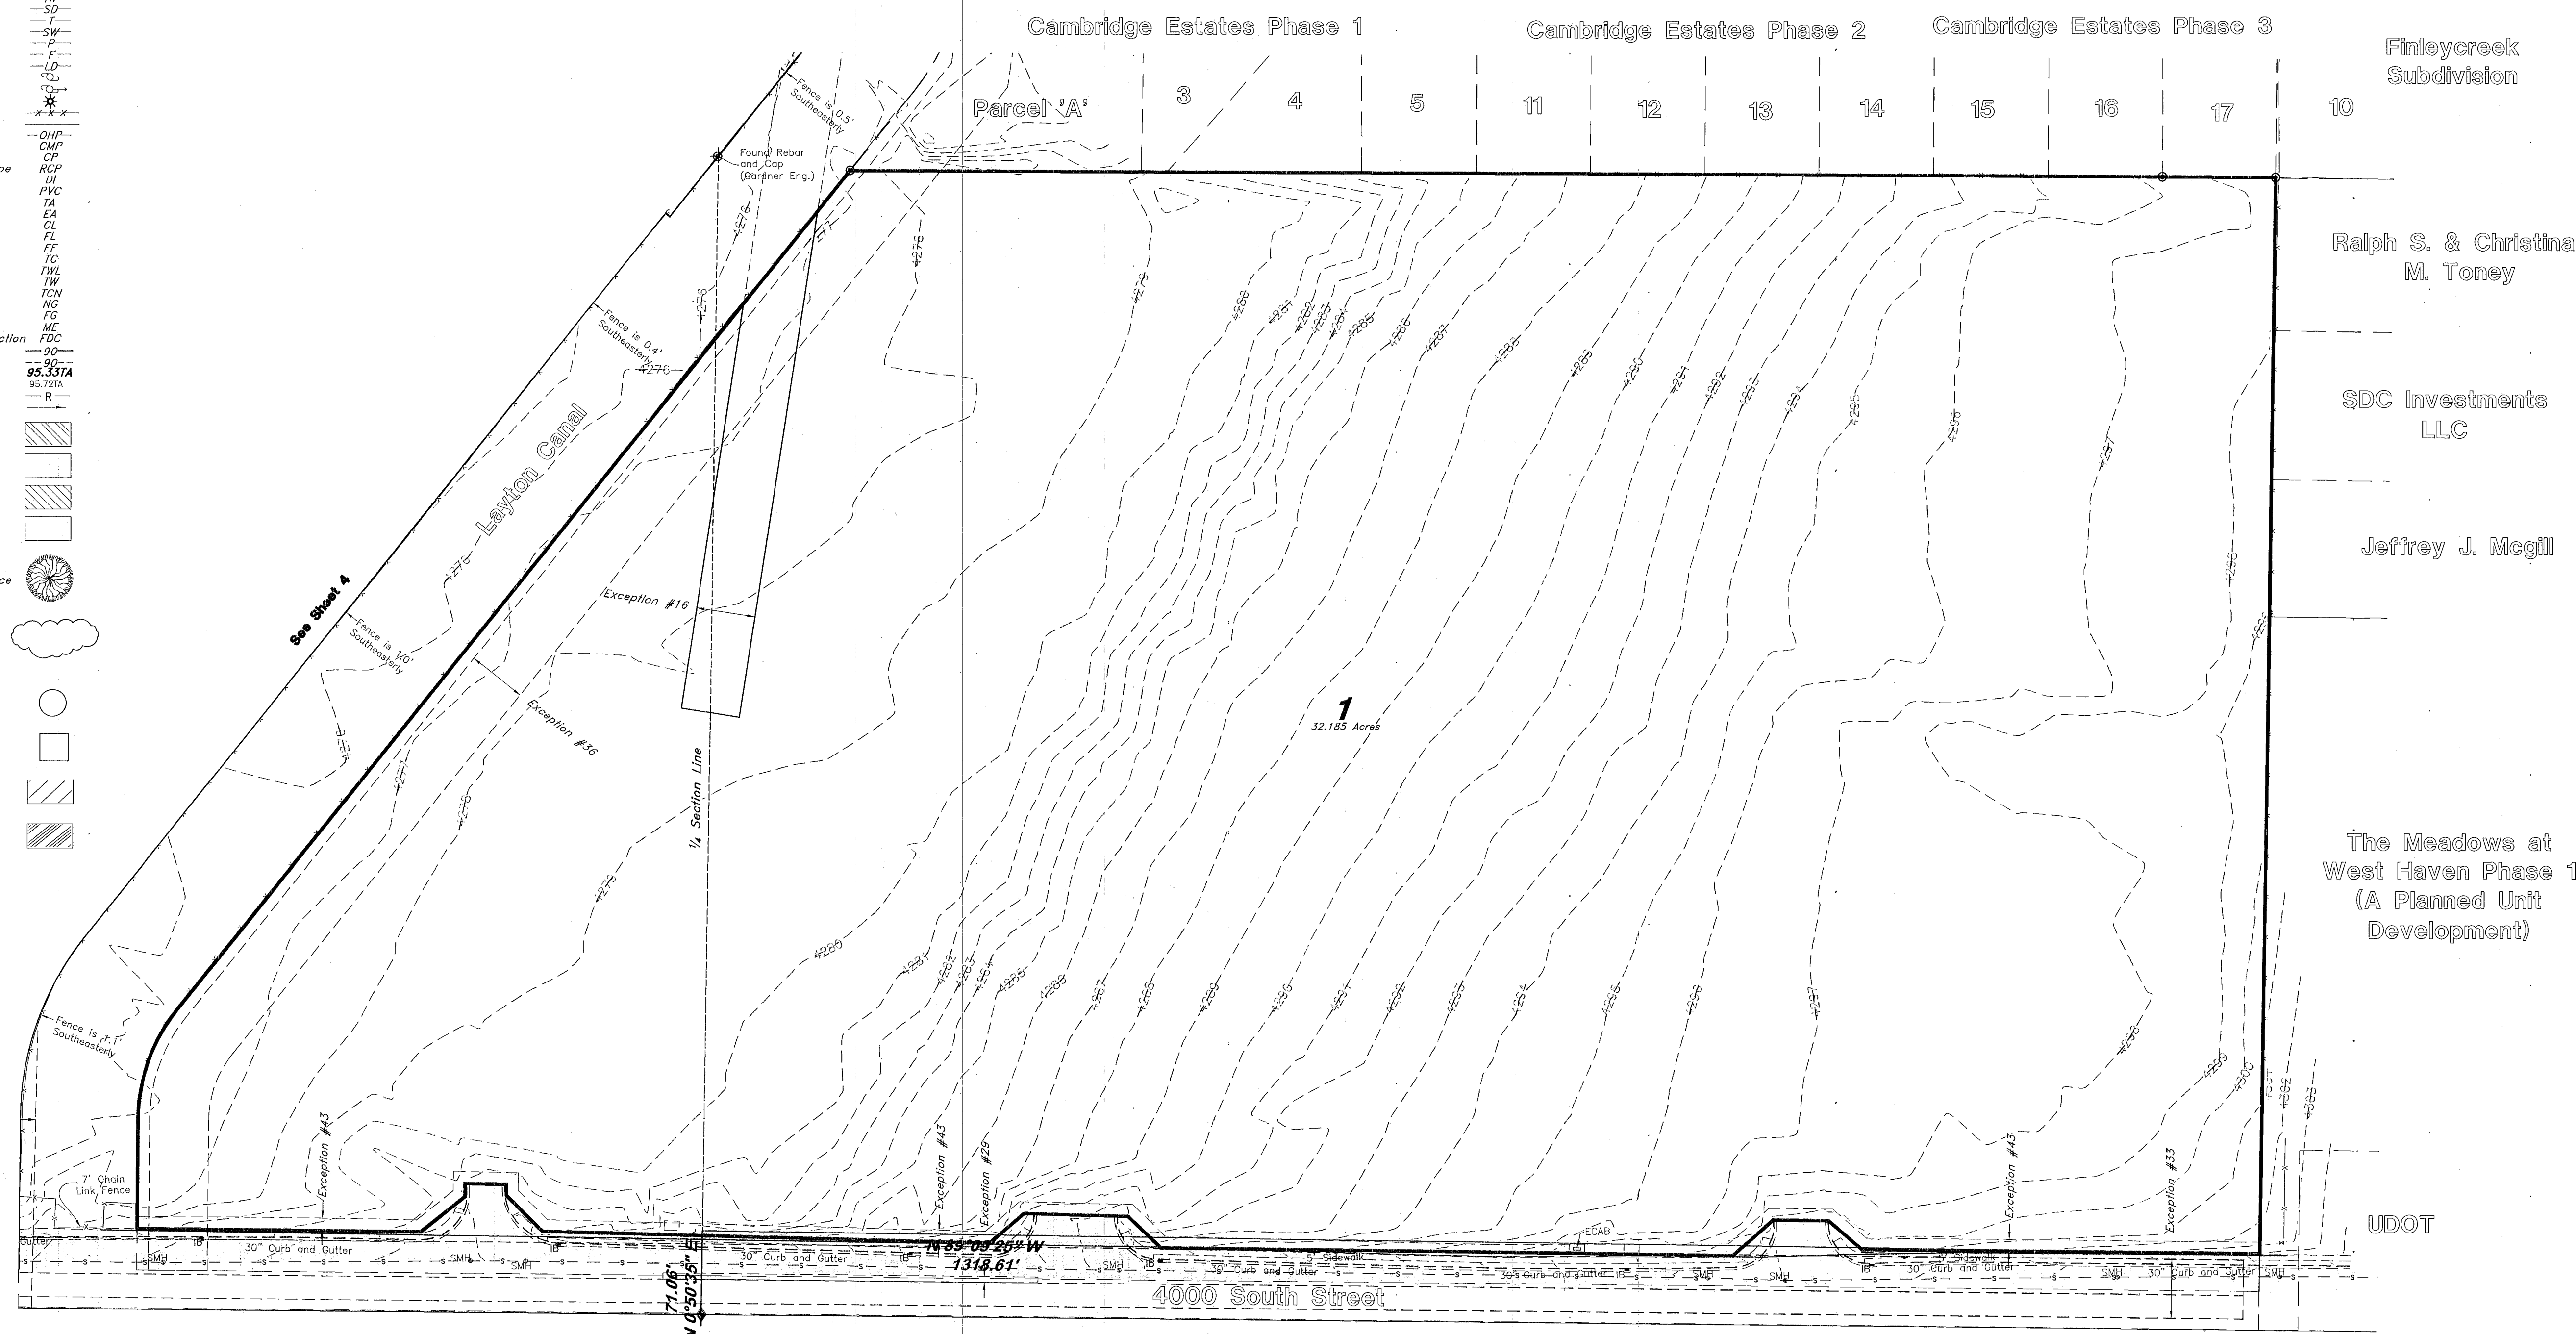


NOTES

1. Utilities shown are from observed evidence on the site and records available at the time of the survey.
2. No encroachments were found other than what is shown on the drawing.
3. There no were delineation markers observed in process of conducting the fieldwork indicating a prior delineation of wellands.
4. This property is approximately 1350 feet from the intersection of 4000 South and Midland Drive.
5. There are no constructed buildings on this site.
6. There are no striped parking stalls on this site.

NOTE

See Sheet 2 for Overall Lot Line Dimensions and Section Monument Information

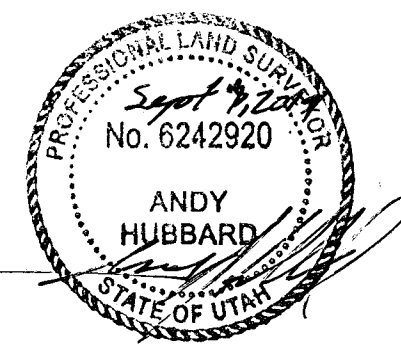

RECEIVED
AUG 11 2018
BY: 6216 C

ALTA/NSPS Land Title Survey

Salt Point - West Haven

Approx. 3950 South 3100 West
West Haven City, Weber County, Utah
A part of Section 3, T5N, R2W, S18&M, U.S. Survey




6 Aug, 2018

SHEET NO.

3

18N737 - ALTA

GREAT BASIN ENGINEERING
 5746 SOUTH 1475 EAST OGDEN, UTAH 84403
 MAIN (801)394-4515 S.A.L.C (801)521-0222 FAX (801)392-7544
 WWW.GREATBASINENGINEERING.COM

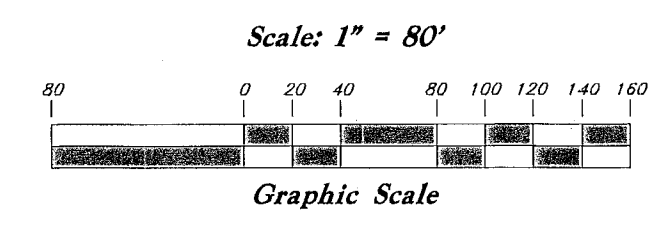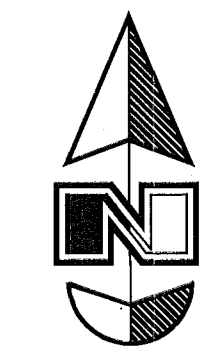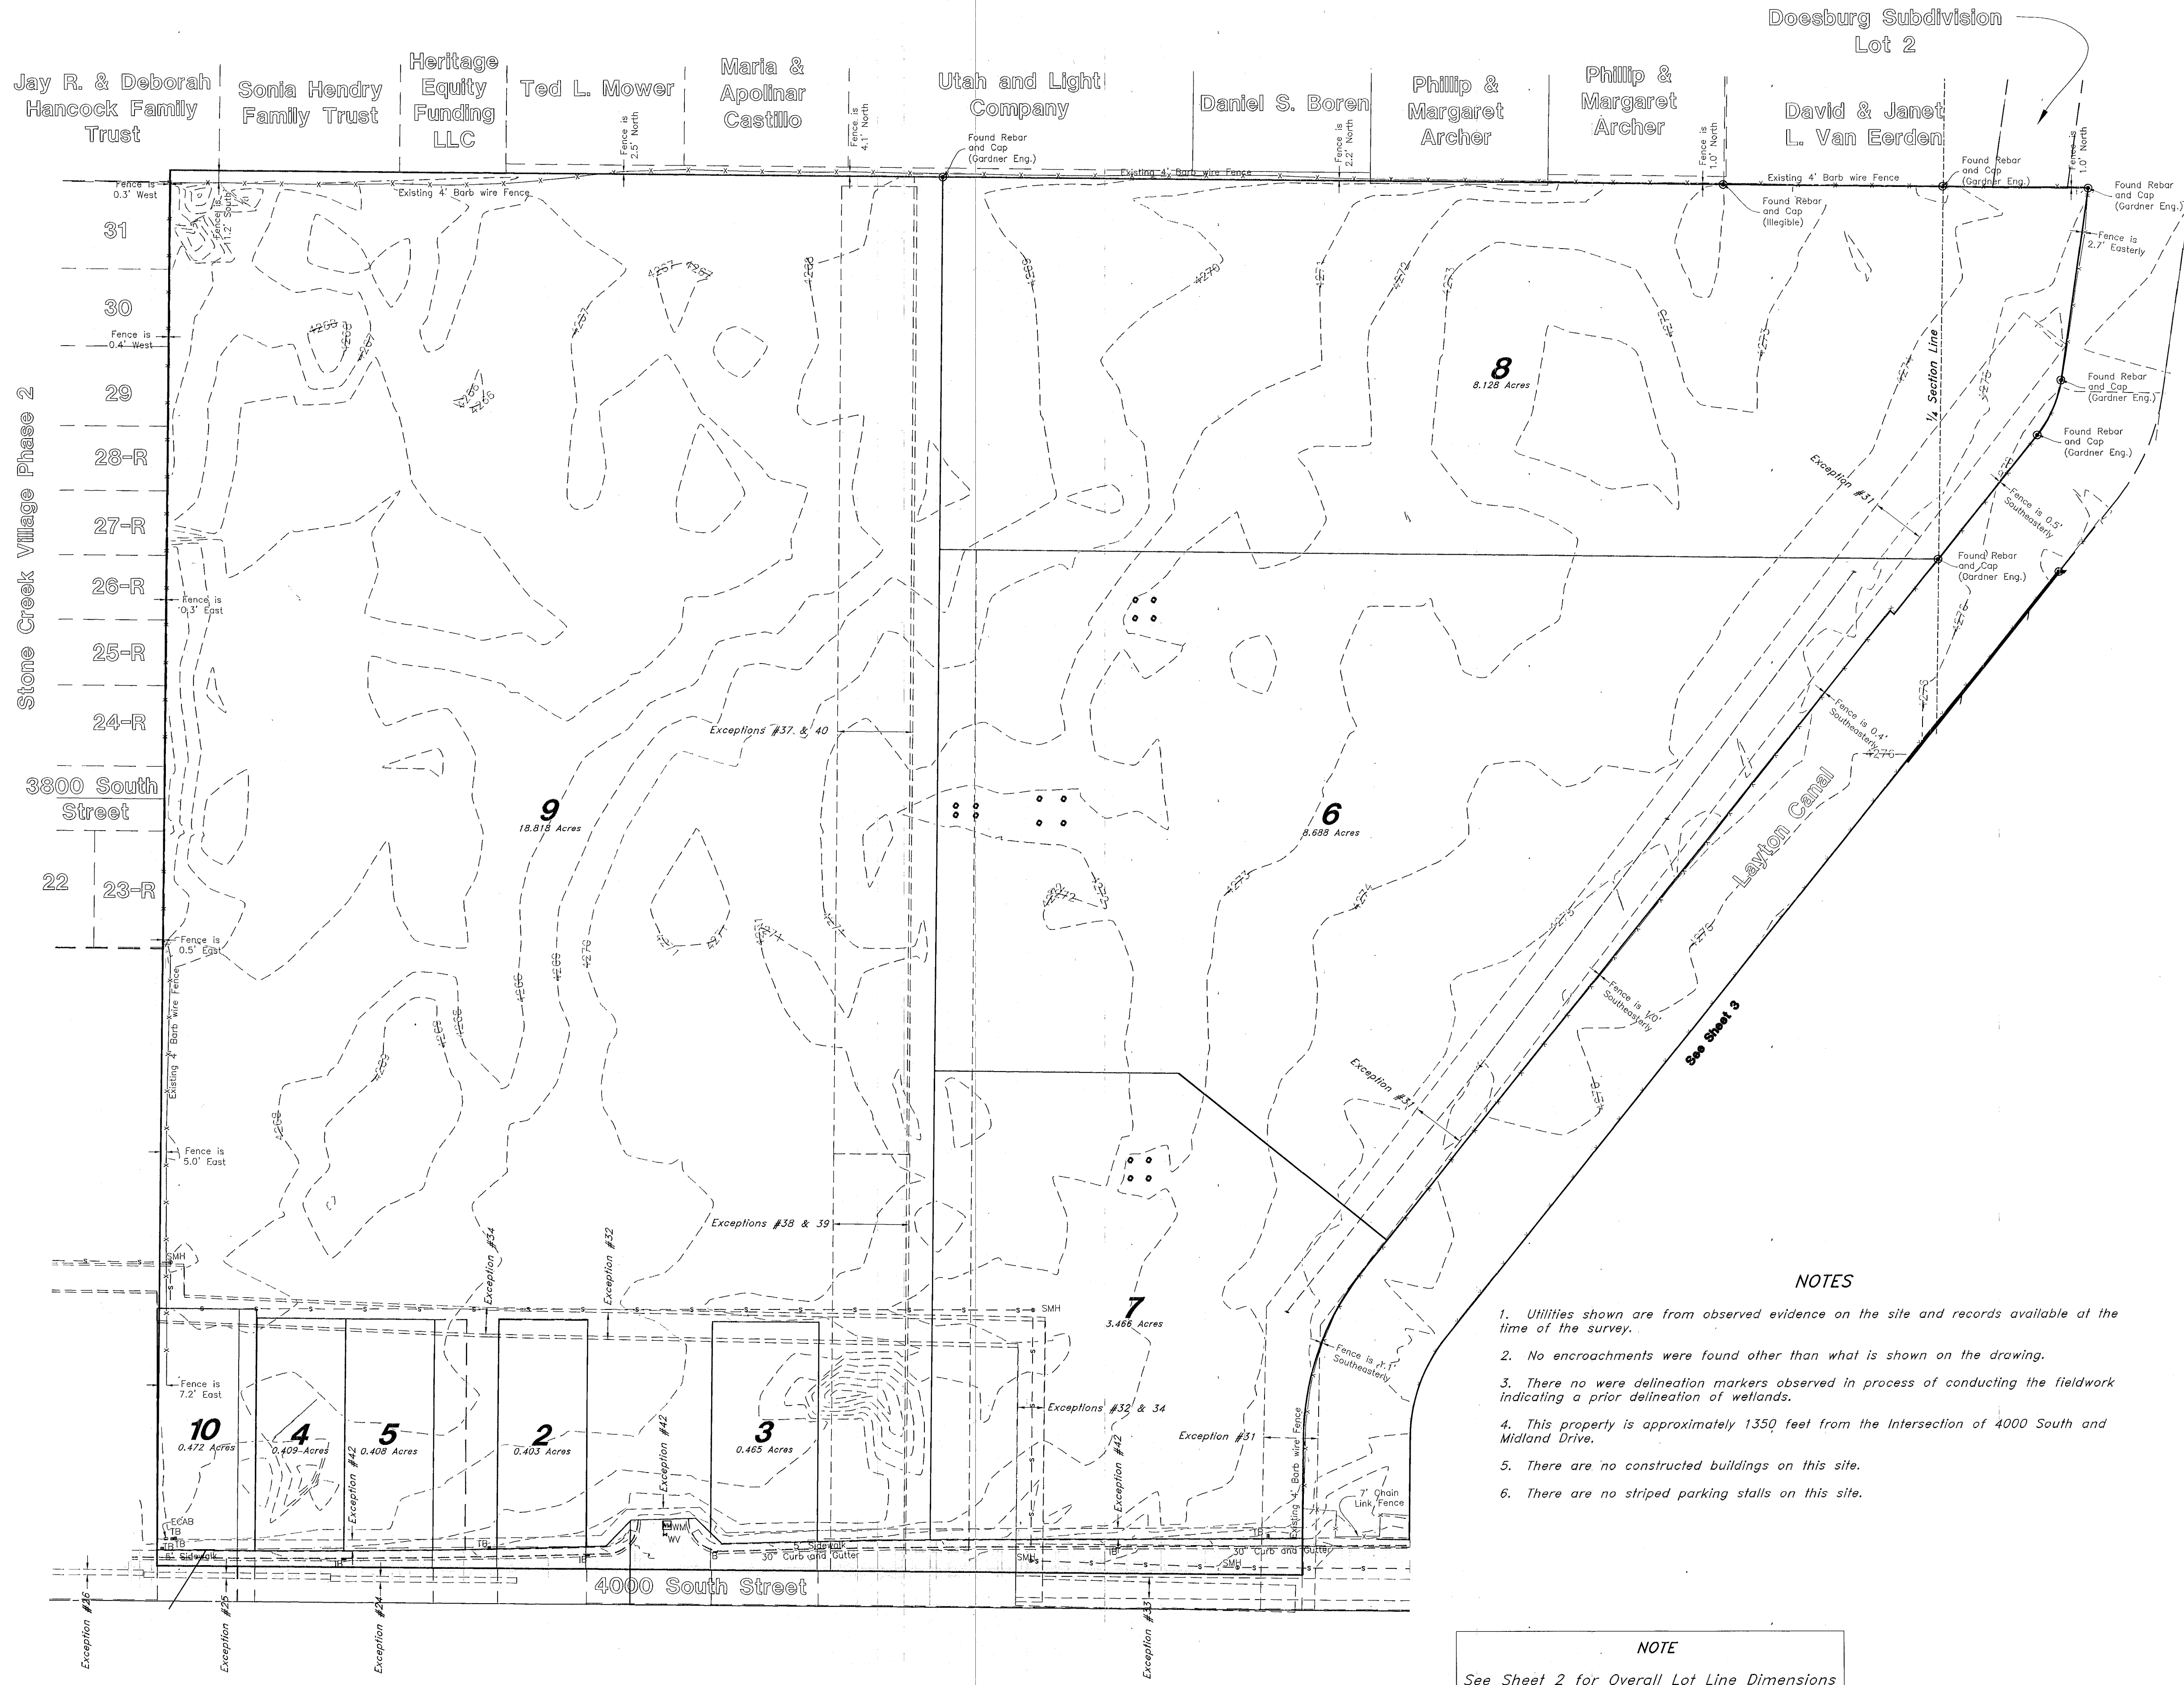

Legend

(Note: All items may not appear on drawing)

- San. Sewer Manhole
- Water Manhole
- Storm Drain Manhole
- Cleanout
- Electrical Manhole
- Catch Basins
- Exist. Fire Hydrant
- Fire Department Connection
- Post Indicator Valve
- Electric Water Valve
- Water Valve
- Sanitary Sewer
- Culinary Water
- Gas Line
- Irrigation Line
- Storm Drain
- Telephone Line
- Secondary Waterline
- Power Line
- Fire Line
- Land Drain
- Power pole
- Power pole w/guy
- Light Pole
- Fence
- Flowline of ditch
- Overhead Power line
- Corrugated Metal Pipe
- Concrete Pipe
- Reinforced Concrete Pipe
- Ductile Iron
- Polyvinyl Chloride
- Top of Asphalt
- Edge of Asphalt
- Centerline
- Flowline
- Finish Floor
- Top of curb
- Top of Wall
- Top of Walk
- Top of Concrete
- Natural Ground
- Finish Grade
- Match Existing
- Fire Department Connection
- Finish Contour
- Exist. Contour
- Finish Grade
- Exist. Grade
- Ridge Line
- Direction of Flow


- Existing Asphalt
- New Asphalt
- Heavy Duty Asphalt
- Existing Concrete
- Tree To Remain in Place
- Cluster of Trees
- Stream Channel (Orange Pins)
- Wetland Boundary (Pink Pins)
- Stream Channel
- Wetlands

NOTES

1. Utilities shown are from observed evidence on the site and records available at the time of the survey.
2. No encroachments were found other than what is shown on the drawing.
3. There no were delineation markers observed in process of conducting the fieldwork indicating a prior delineation of wetlands.
4. This property is approximately 1350 feet from the Intersection of 4000 South and Midland Drive.
5. There are no constructed buildings on this site.
6. There are no striped parking stalls on this site.

NOTE

See Sheet 2 for Overall Lot Line Dimensions and Section Monument Information

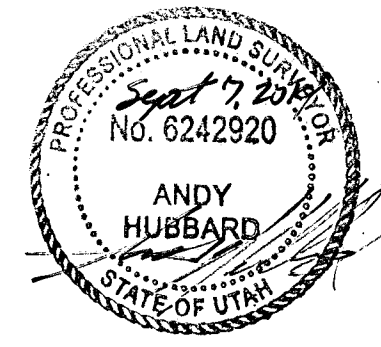

RECEIVED
AUG 11 2018
BY: b316.D

GREAT BASIN ENGINEERING
5746 SOUTH 1475 EAST, GARDEN, UTAH 84403
MAIN (801)594-4515 S.L.C (801)591-0222 FAX (801)399-7544
WWW.GREATBASINENGINEERING.COM

ALTA/NSPS Land Title Survey
Salt Point - West Haven
Approx. 3950 South 3100 West
West Haven City, Weber County, Utah
A part of Section 3, T5N, R2W, S16&M, U.S. Survey