


6399
6399

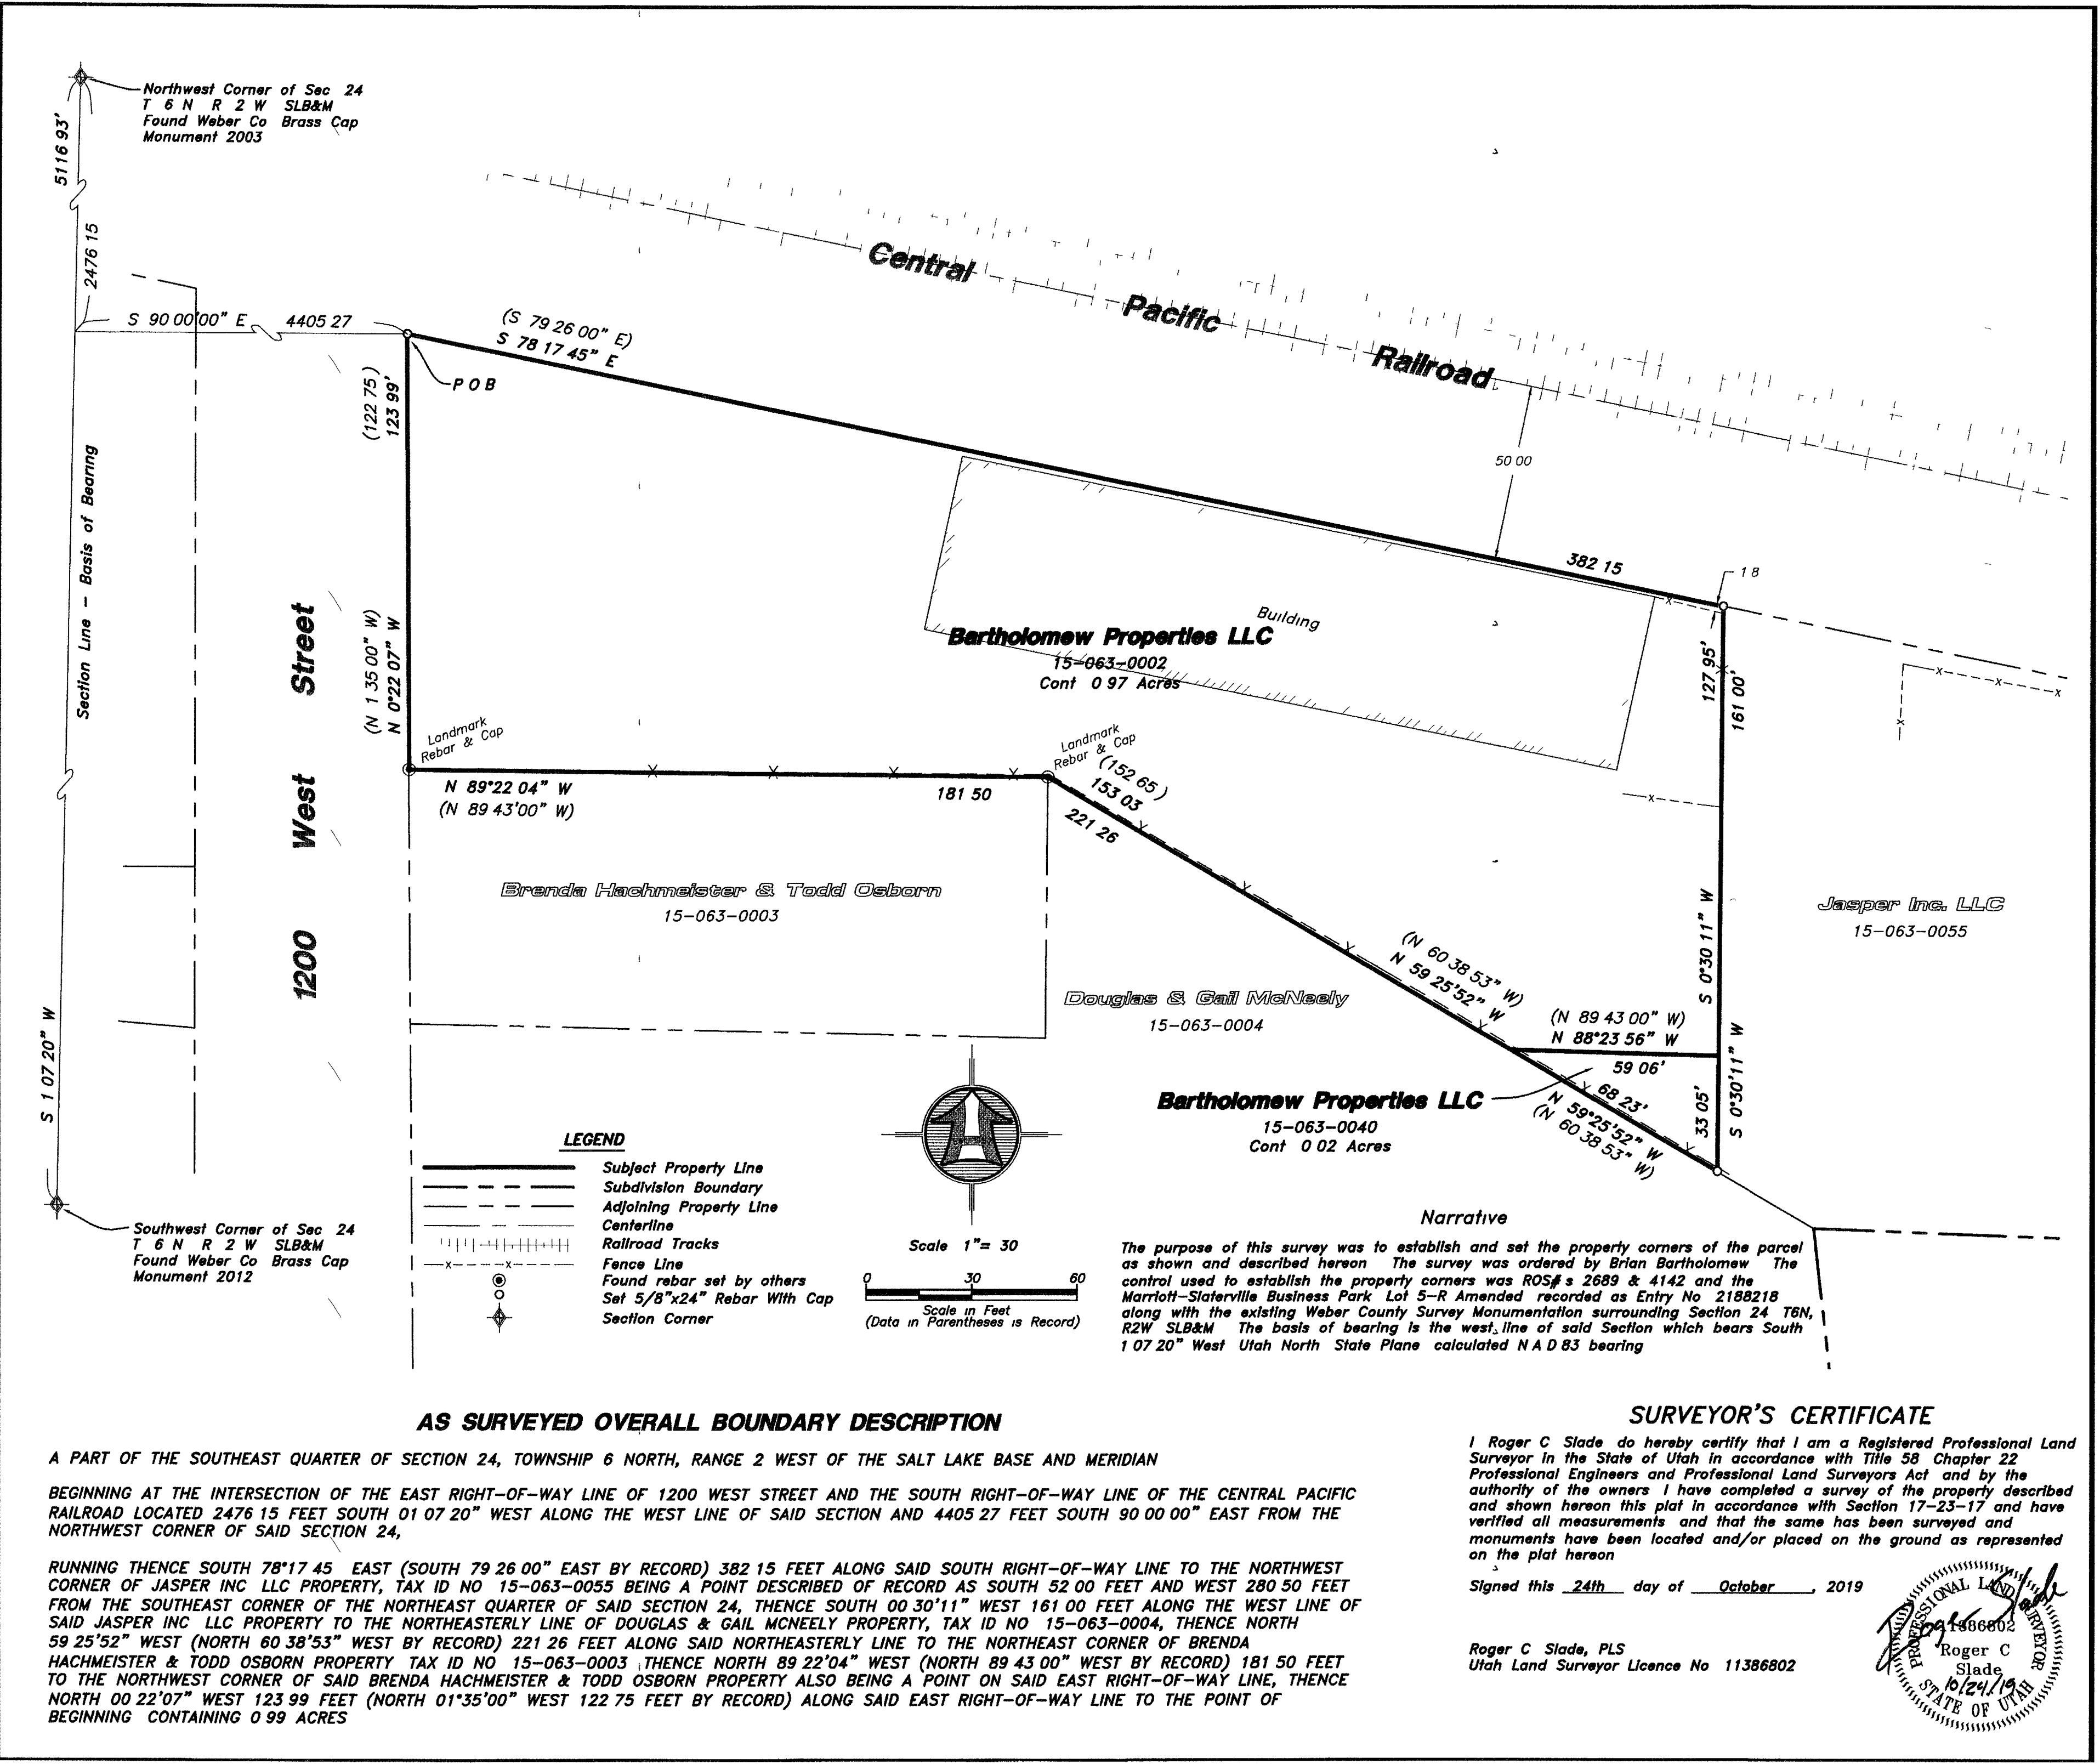

Drawn By	RS	Date	10/11/2019
Designed By	High	Checked By	
Approved By		Scale	1" = 30'
Drawing File	19-3-246r15.dwg		
JOB NUMBER	19-3-246		

Property Survey for
Brian Bartholomew
1394 South 1200 West
Ogden Weber Co., Utah
A Part of the Southeast Quarter of
Section 24, T 6 N., R 2 W., SLB&M

HANSEN & ASSOCIATES, INC.
Consulting Engineers and Land Surveyors
538 North Main Street Bingham Utah 84302
Visit us at www.haes.net
Logan
Ogden
Bingham City
(435) 733-3491 (801) 399-4605 (435) 752-8272
Celebrating over 60 Years of Business

Sheet
1
Of
1
Sheets

RECEIVED
JAN 13 2020
BY 6399