


000649

000649

000649

000649

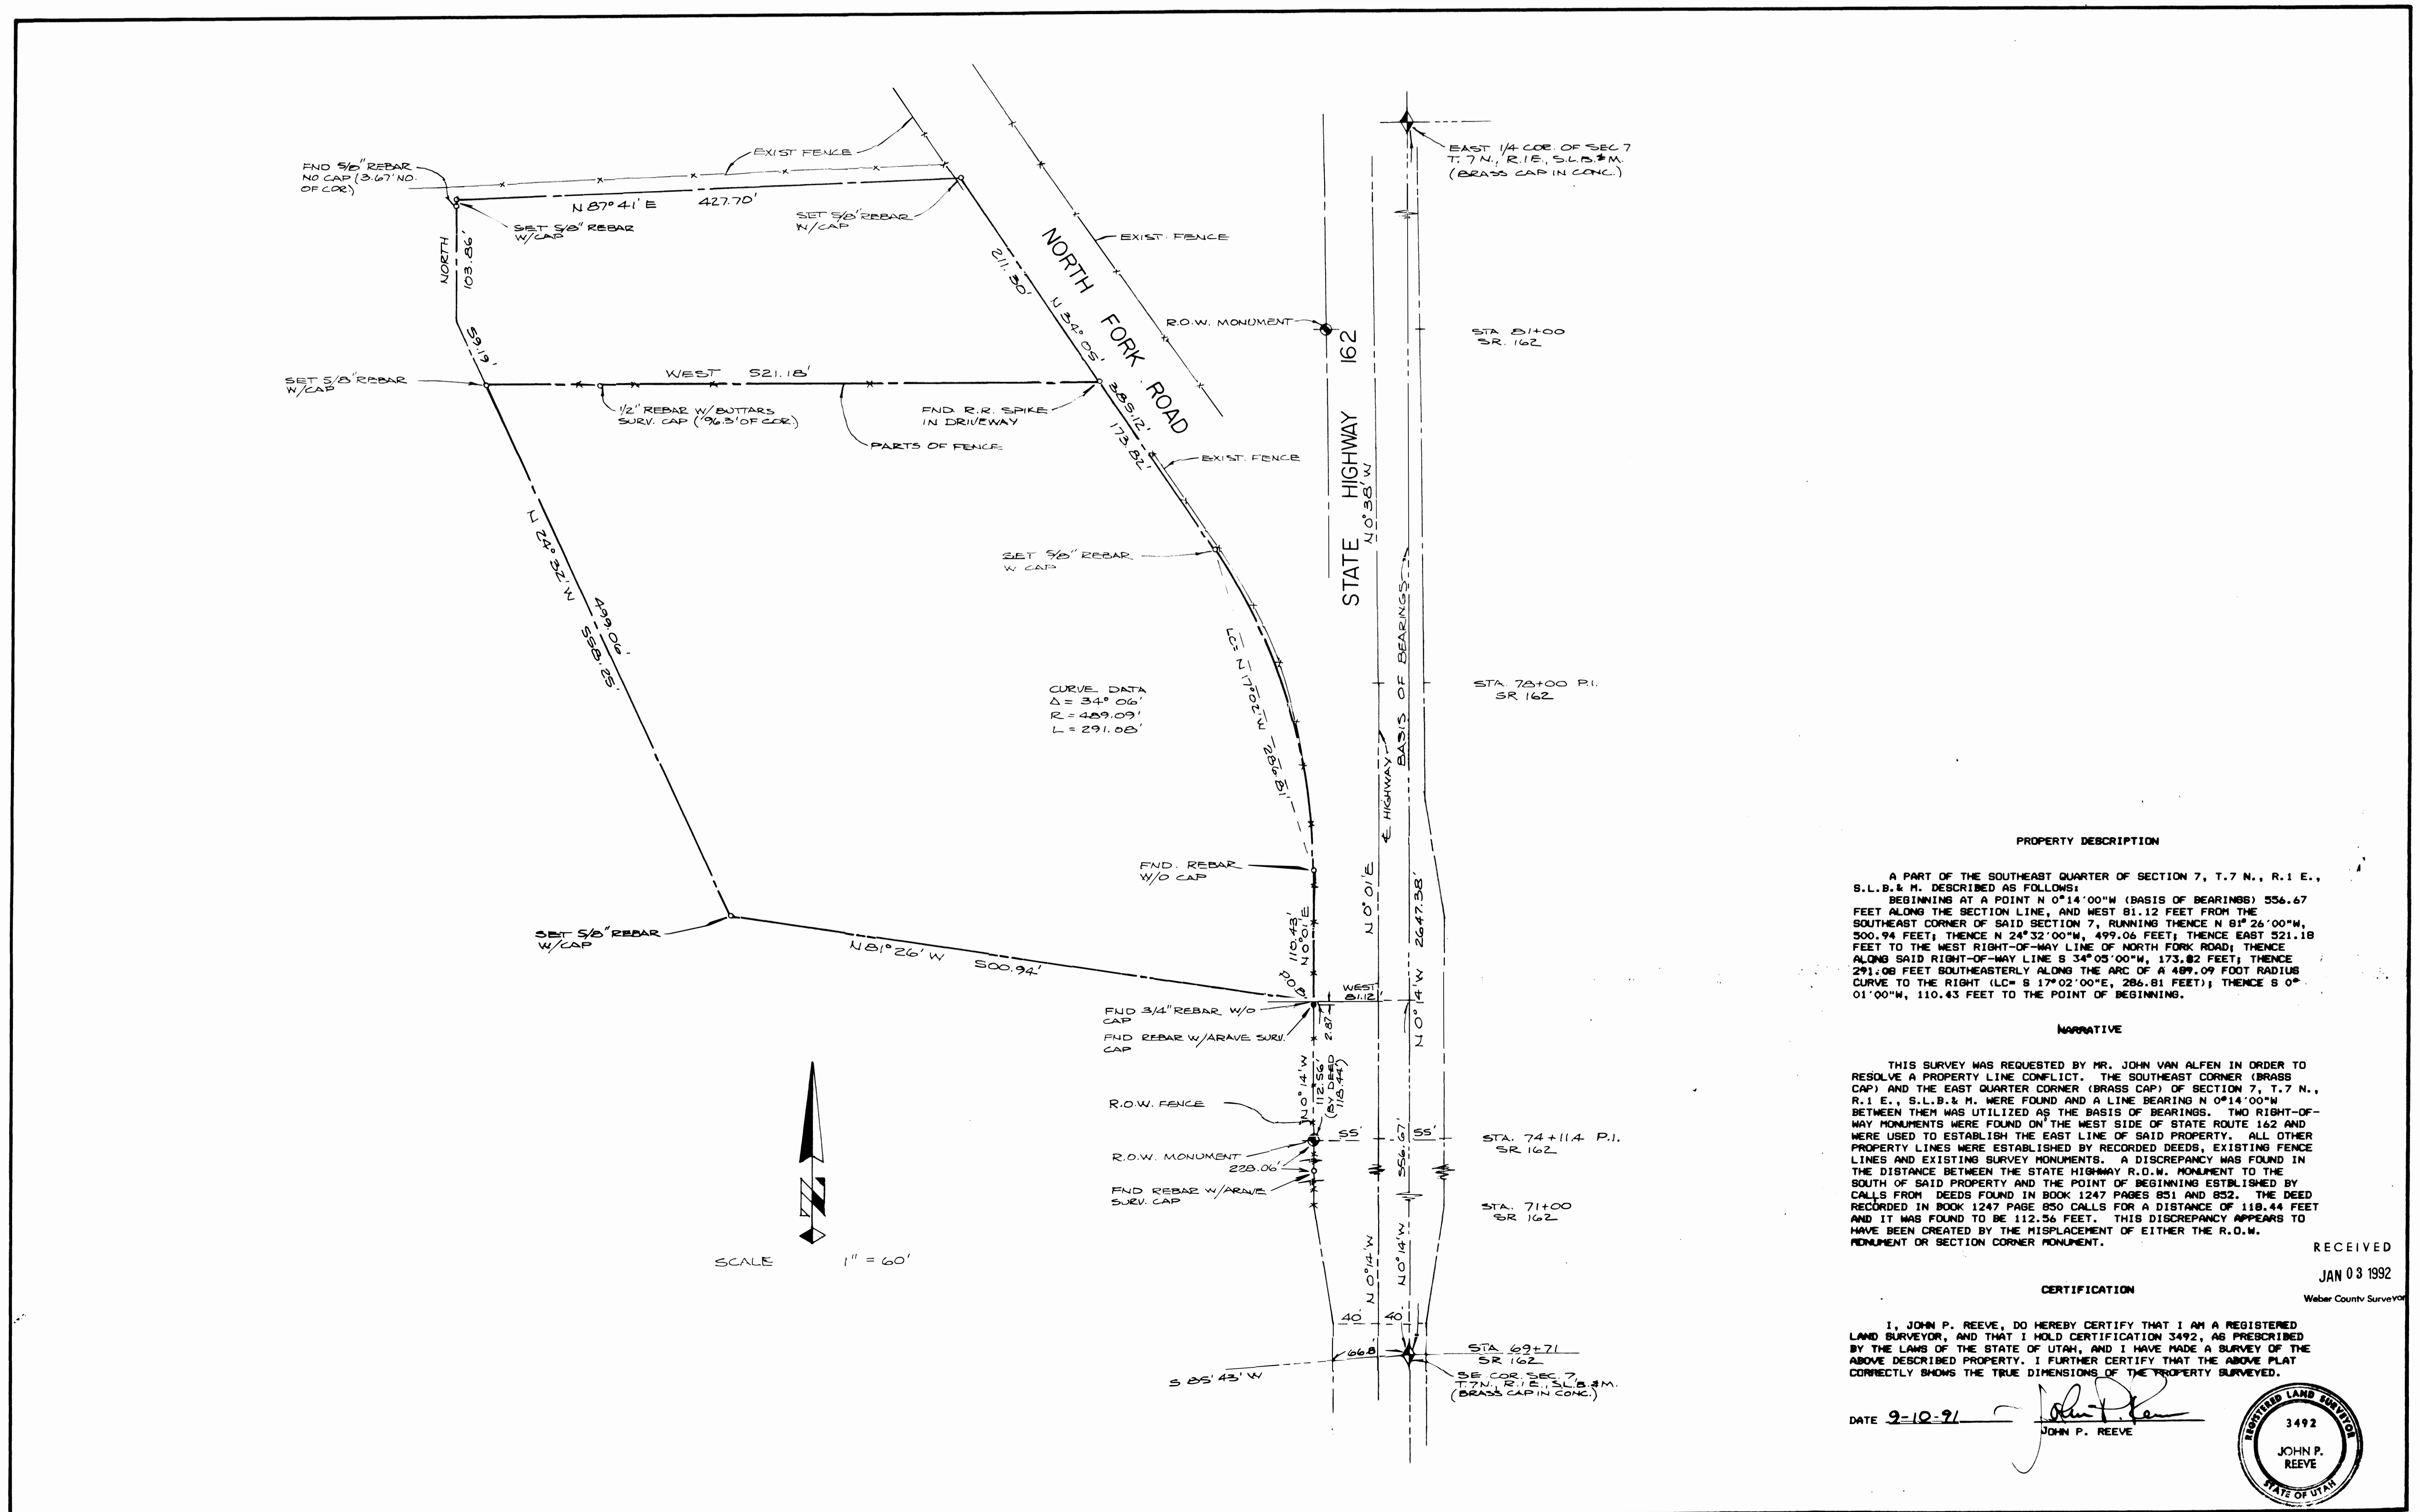

NO.	REVISIONS	DATE
1		
2		
3		
4		

PROJECT NO.	91-1083	DESIGNED	J.P.R.
DATE	9-10-91	DRAWN	J.P.R.
SCALE	1" = 60'	APPROVED	

REEVE & REEVE, INC.
 CIVIL AND ENVIRONMENTAL ENGINEERING
 LAND PLANNING AND SITE DESIGN
 LAND SURVEYING
 OGDEN, UTAH

JOHN VAN ALFEN PROPERTY

RECORD OF SURVEY

SHEET	
SHEETS	