


**Parcel No. 1**  
 LOT 9, MOUNTAIN MEADOW SUBDIVISION, NORTH OGDEN CITY, UTAH SURVEY, FILED AS ENTRY NO. 985423 IN THE FILES OF THE WEBER COUNTY RECORDER BEING SITUATED IN THE NORTHWEST QUARTER OF SECTION 4, TOWNSHIP 6 NORTH, RANGE 1 WEST OF THE SALT LAKE BASE AND MERIDIAN.

**Parcel No. 2**  
 A PART OF THE NORTHWEST QUARTER AND NORTHEAST QUARTER OF SECTION 4, TOWNSHIP 6 NORTH, RANGE 1 WEST OF THE SALT LAKE BASE AND MERIDIAN.

BEGINNING AT THE NORTHEAST CORNER OF LOT 9, MOUNTAIN MEADOW SUBDIVISION, NORTH OGDEN CITY, UTAH SURVEY, FILED AS ENTRY NO. 985423 IN THE FILES OF THE WEBER COUNTY RECORDER, SAID POINT BEING ON THE SOUTH BOUNDARY LINE OF GREENFIELD SUBDIVISION PHASE 1 FILED AS ENTRY NO. 924837 IN THE FILES OF THE WEBER COUNTY RECORDER AND RUNNING THENCE ALONG THE SOUTH BOUNDARY LINE OF SAID GREENFIELD SUBDIVISION THE FOLLOWING TWO (2) COURSES; (1) NORTH 88°33'00" EAST (NORTH 88°11'00" EAST BY RECORD) 78.20 FEET; AND (2) NORTH 85°48'43" EAST (NORTH 85°56'50" EAST BY RECORD) 173.73 FEET TO THE NORTHWEST CORNER OF THE PAUL A. MACKLEY PROPERTY, TAX ID. NO. 10-004-0085; THENCE ALONG THE BOUNDARY LINE OF SAID MACKLEY PROPERTY THE FOLLOWING TWO (2) COURSES; (1) SOUTH 00°24'07" WEST (SOUTH 00°07'34" WEST BY RECORD) 79.00 FEET; AND (2) NORTH 87°23'59" EAST (NORTH 86°52'18" EAST BY RECORD) 67.20 FEET TO THE WEST BOUNDARY LINE OF THE PAUL A. MACKLEY PROPERTY, TAX ID. NO. 11-003-0066, BEING A POINT 2.90 FEET EAST OF THE EAST LINE OF SAID NORTHWEST QUARTER; THENCE ALONG SAID WEST BOUNDARY LINE SOUTH 00°30'50" WEST 337.03 FEET (SOUTH 00°15'00" WEST BY RECORD) TO THE NORTH BOUNDARY LINE OF THE PAUL A. MACKLEY PROPERTY, TAX ID. NO. 11-004-0007; THENCE ALONG SAID NORTH BOUNDARY LINE NORTH 89°23'00" WEST 241.08 FEET (NORTH 00°15' EAST BY RECORD) TO THE NORTHEAST CORNER OF LOT 4 OF SAID MOUNTAIN MEADOW SUBDIVISION; THENCE NORTH 00°37'00" EAST (NORTH 00°15' EAST BY RECORD) 187.63 FEET ALONG THE EAST BOUNDARY LINE OF SAID MOUNTAIN MEADOW SUBDIVISION TO THE SOUTHEAST CORNER OF THE BRANDI LONG AND COLE VEIBELL PROPERTY, TAX ID. NO. 11-205-0007; THENCE ALONG SAID LONG AND VEIBELL BOUNDARY LINE THE FOLLOWING TWO (2) COURSES; (1) NORTH 01°52'16" EAST 64.76 FEET (NORTH 62.47 FEET BY RECORD); AND (2) NORTH 89°23'00" WEST (BY RECORD) 79.59 FEET TO THE EAST BOUNDARY LINE OF SAID MOUNTAIN MEADOW SUBDIVISION; THENCE NORTH 00°37'00" EAST (NORTH 00°15' EAST BY RECORD) 162.51 FEET ALONG SAID EAST BOUNDARY LINE TO THE POINT OF BEGINNING. CONTAINING 105,611 SQUARE FEET OR 2.424 ACRES.


- LEGEND**
- Subject Property Line
  - - - Adjoining Property Line
  - Interior Lot Lines
  - Centerline
  - - - Field Separation Line
  - - - Fence Line (Wire)
  - - - Fence Line (Wood or Vinyl)
  - - - Street Monument
  - - - Found rebar set by others
  - - - Set 5/8"x24" Rebar With Cap
  - Section Corner

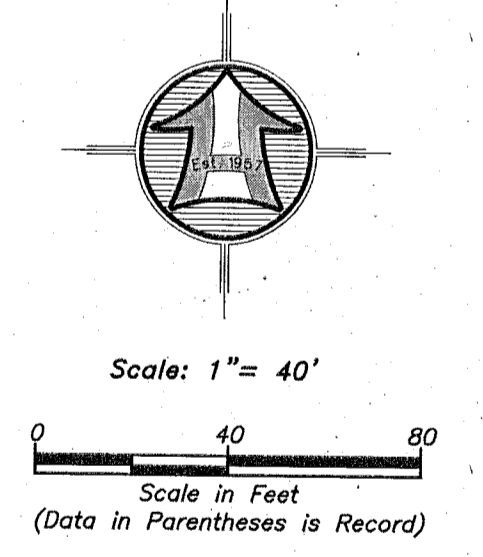

**Narrative**  
 The Purpose of this survey was to prepare this Lot Line Amendment as shown and described hereon. This Survey was ordered by Paul Mackley. This Lot Line Amendment is redefining the boundaries of parcels tax id. no. 112-050-0009 and 11-004-0007. Parcel No. 1 is being returned to its original configuration as Lot 9 of the Mountain Meadow Subdivision. The control used to establish the property corners was the existing Weber County Surveyor Monumentation surrounding Section 4, Township 6 North, Range 1 West, S.L.B.&M. The basis of bearing is the North line of the Northeast Quarter of said Section which bears North 89°42'01" West, Utah North, State Plane, Calculated N.A.D.83 Bearing.

**SURVEYOR'S CERTIFICATE**  
 I, K. Greg Hansen, do hereby certify that I am a Registered Professional Land Surveyor in the State of Utah in accordance with Title 58, Chapter 22, Professional Engineers and Professional Land Surveyors Act and by the authority of the owners, I have completed a survey of the property described and shown hereon this plat in accordance with Section 17-23-17 and have verified all measurements, and that the same has been surveyed and monuments have been located and/or Placed on the ground as represented on the plat hereon.  
 Signed this 18th day of July, 2019.

K. Greg Hansen PLS  
 Utah Land Surveyor Licence No. 167819

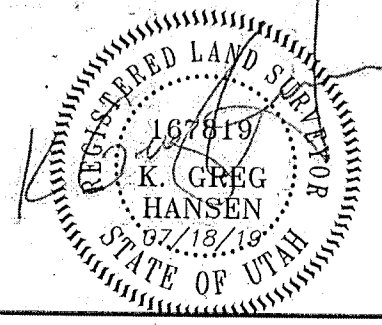

Drawn By: kgh Date: 07/16/19  
 Designed By: rs  
 Checked By: rs  
 Approved By: [Signature]  
 Drawing File: 19-122 v15 lotlineamend  
 Scale: 1" = 40'  
 JOB NUMBER: 19-122

**HANSEN & ASSOCIATES, INC.**  
 Consulting Engineers and Land Surveyors  
 538 North Main Street, Brigham, Utah 84302  
 Visit us at www.hanseninc.com  
 Logan  
 (435) 752-8272  
 (801) 399-1805  
 Celebrating over 60 Years of Business

Lot Line Amendment Survey For  
**Paul A. Mackley**  
 730 East 1750 North  
 North Ogden City, Weber County, Utah  
 A Part of the Northwest & Northeast Quarters of Section 4,  
 Township 6 North, Range 1 West, S.L.B.&M.

Sheet  
**1**  
 of  
**1**  
 Sheets