

SECTION	1
PROJECT NO.	91-1119
DATE	11-21-91
SCALE	1" = 60'
DESIGNED BY	J.P.K.
CHECKED BY	REVEE


REEVE & REEVE, INC.
CIVIL AND ENVIRONMENTAL ENGINEERING
LAND SURVEYING AND SURVEYING DESIGN
COURT HOUSE
COURTEN UTAH

RECORD OF SURVEY

LERoy MILNE PROPERTY

000655

SHEET	1
TOTAL SHEETS	1

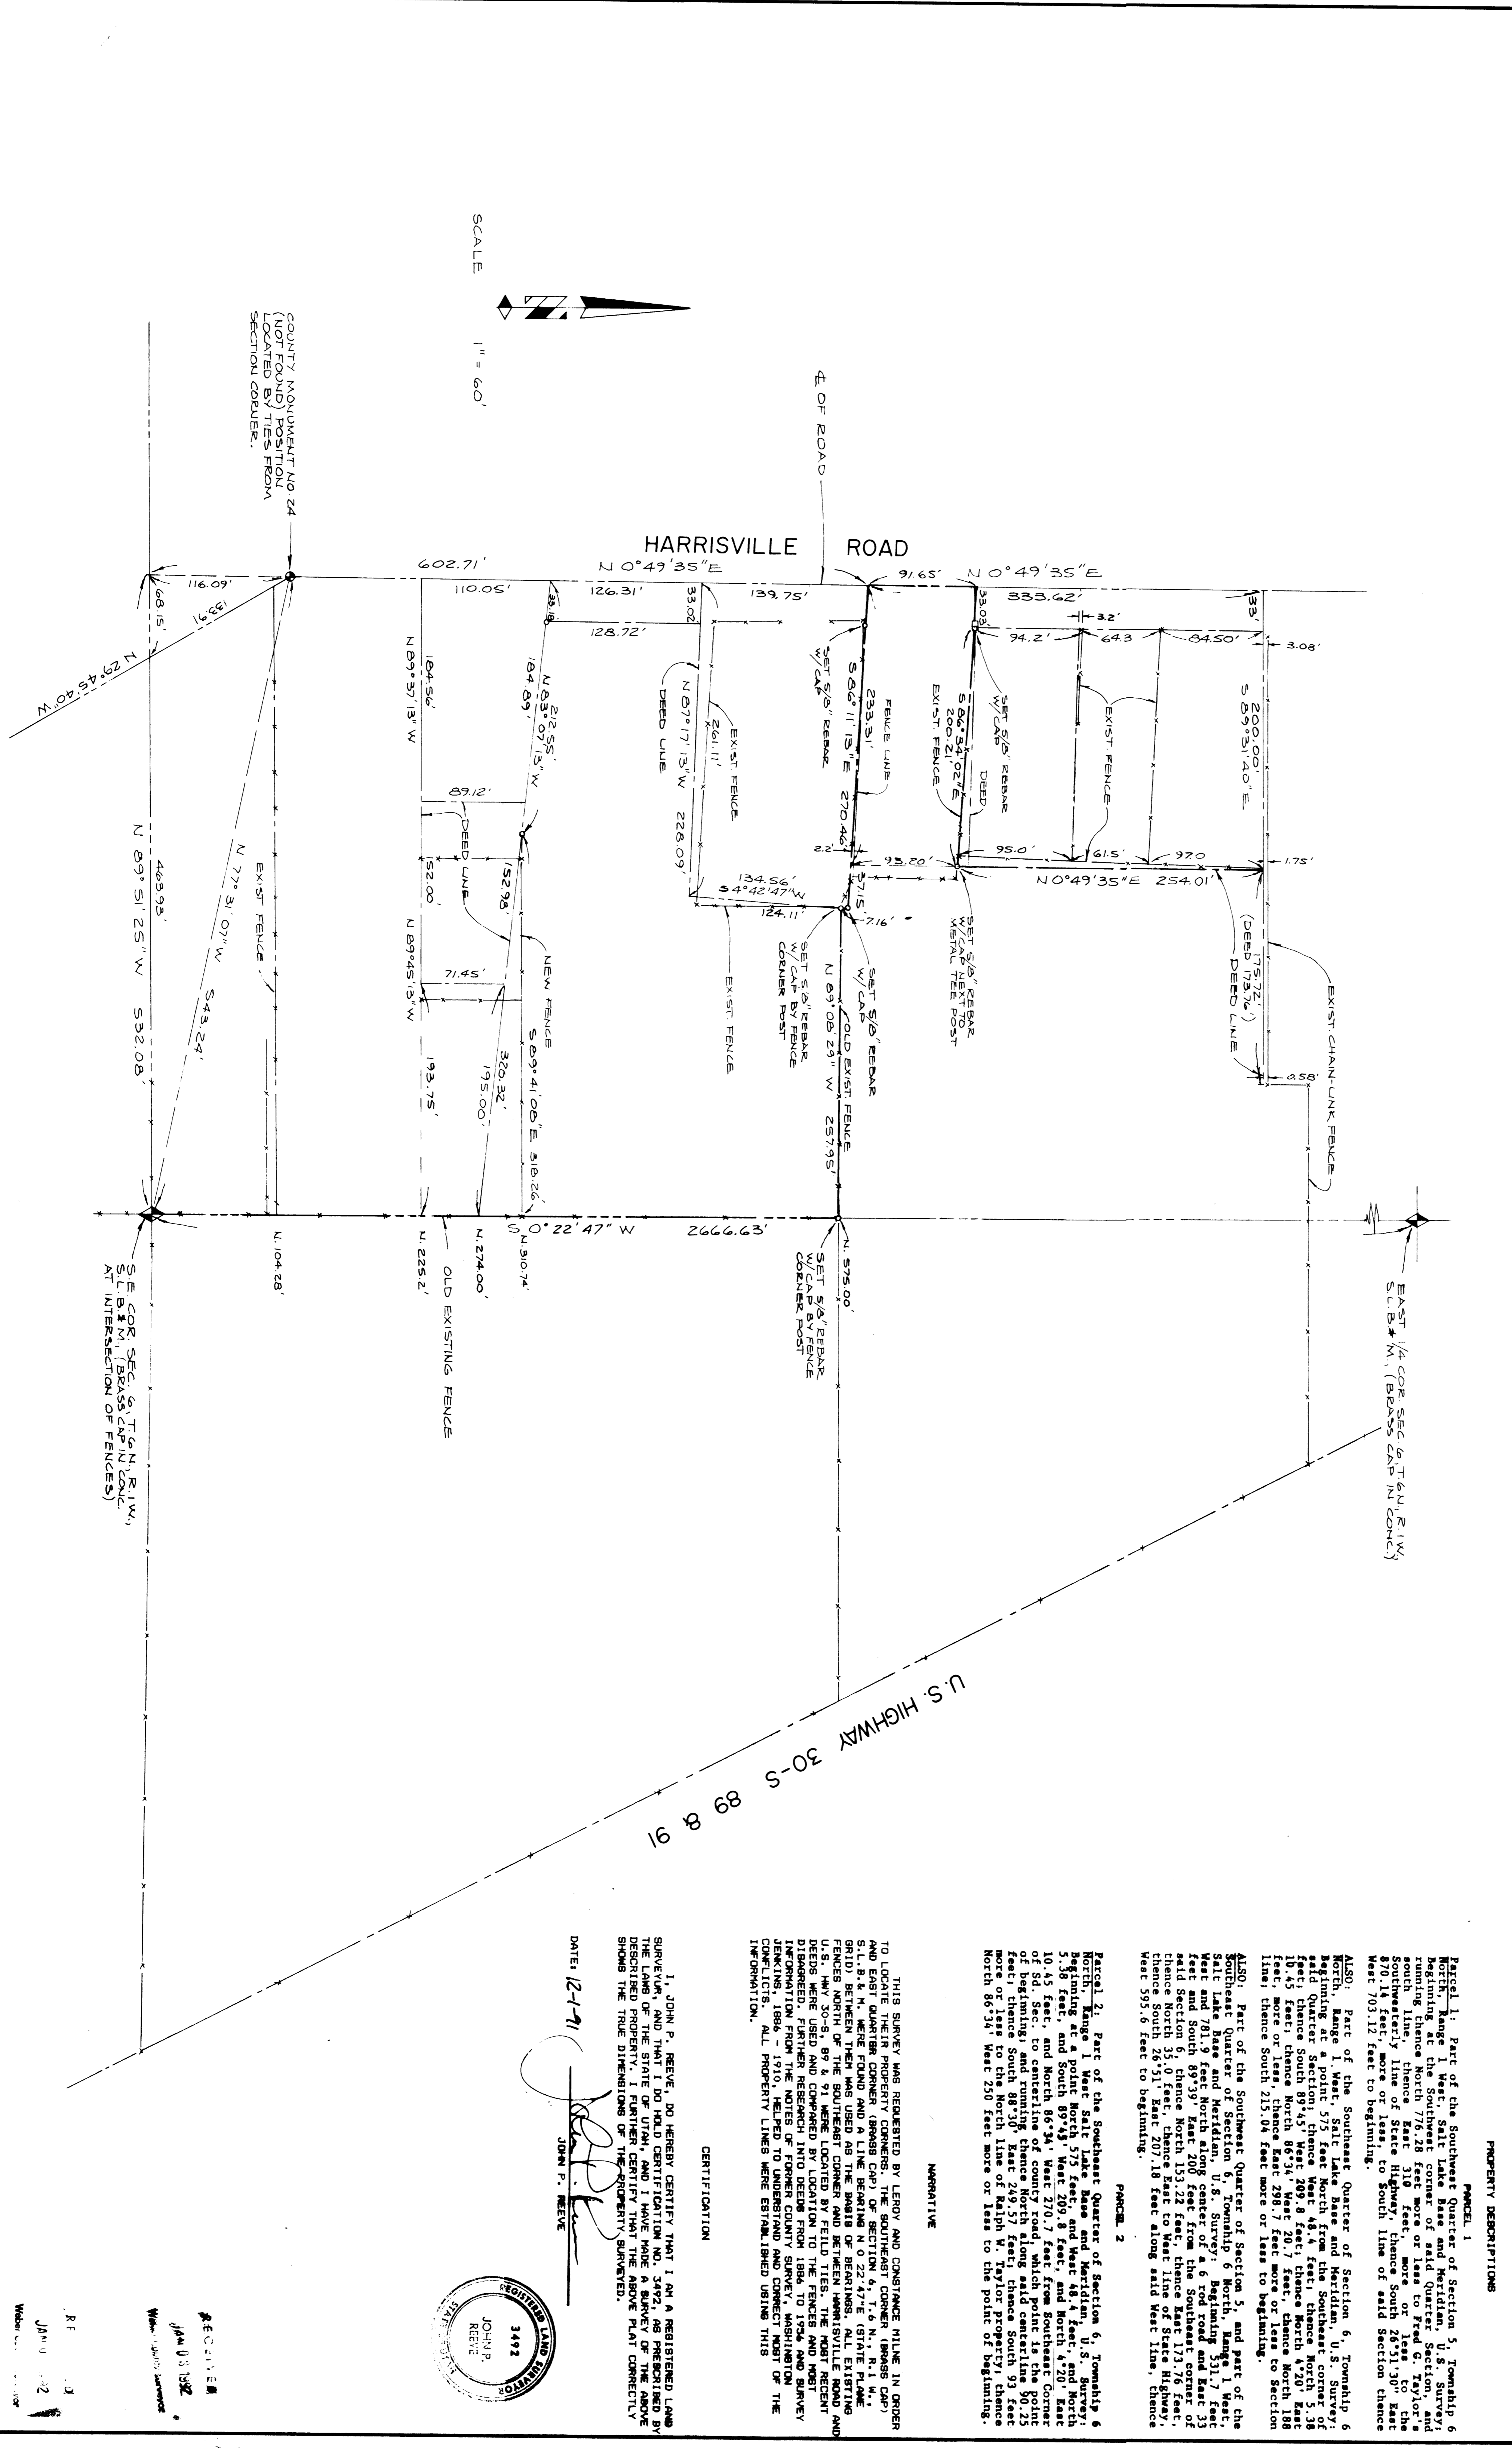

PROPERTY DESCRIPTIONS






NARRATIVE



CERTIFICATION

I, JOHN P. REEVE, DO HEREBY CERTIFY THAT I AM A REGISTERED LAND SURVEYOR OF THE STATE OF UTAH, AND I HAVE MADE A CAREFUL AND ACCURATE SURVEY OF THE ABOVE PROPERTY, AND I FURTHER CERTIFY THAT THE ABOVE PLAT CORRECTLY SHOWS THE TRUE DIMENSIONS OF THE PROPERTY SURVEYED.

DATE: 12-1-91
JOHN P. REEVE

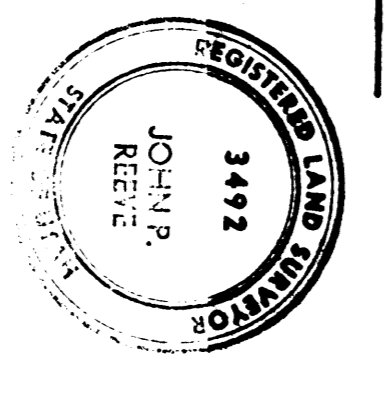

RECORDED
JAN 03 1992
COURT HOUSE
COURTEN UTAH