


NARRATIVE

This Survey was requested by Mr. Art Moore for the purpose of retracing the boundaries of these parcels in preparation for Adjusting the Parcel lines between the Properties.
 Weber County Brass Cap Monuments were found at a witness corner location to the Southeast corner, at the East Quarter Corner and the Northeast corner of Section 14, T5N, R3W, SLB&M.
 A rebar with a melted cap was found at the Northwest corner of Bird's Place Subdivision, its location checks with the information shown on the Recorded Plat (Entry No 1249644, in book 36, at Page 55, of the Weber County Recorders Office).
 Property lines were established along deed lines.
 Property corners were monumented as depicted on this drawing.

Northeast Corner of Section 15, T5N, R3W, SLB&M, U.S. Survey (Found Weber County Brass Cap in Good Condition Dated 1974 Flush with Road Surface)

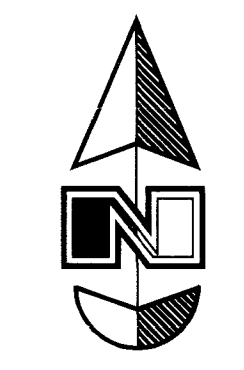

Scale: 1" = 60'

Legend


- ▲ Set Nail & Washer
- Set Rebar & Cap w/ Fencepost
- Set Hub & Tack Monument to be set
- (Rad.) Radial Line
- (N/R) Non-Radial Line
- X-X- Fence

East Quarter Corner of Section 15, T5N, R3W, SLB&M, U.S. Survey (Found Weber County Brass Cap in Good Condition Dated 1974 6" below grade)

Southeast Corner of Section 15, T5N, R3W, SLB&M, U.S. Survey (Not Found Calculated from witness corner)

SURVEYOR'S CERTIFICATE

I, Andy Hubbard do hereby certify that I am a Professional Land Surveyor, and that I hold License No. 6242920, in accordance with Title 58, Chapter 22, of the Professional Engineers and Surveyors Licensing Act, and I have made a survey of the above described property according to Section 17-23-17 and that the above plat correctly shows the true dimensions of the property surveyed.

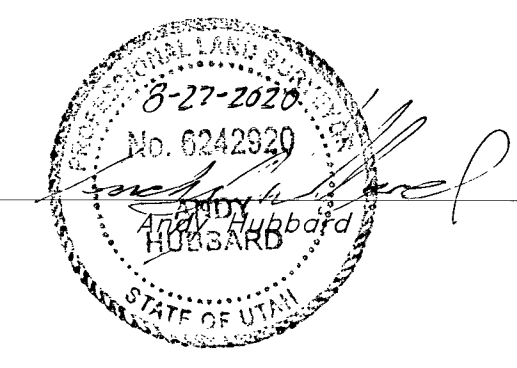

RECEIVED
 BY: G581

Agreed and Final Descriptions of Bunot Properties
 BUNOT (0012)

A part of the Northeast Quarter of Section 15, Township 5 North, Range 3 West, Salt Lake Base and Meridian, U.S. Survey:
 Beginning at a Point 660 feet West and 6 Rods North of the Southeast Corner of said Quarter Section, and running thence North 30 Rods; thence East 20 Rods; thence South 30 Rods; thence South 88°45'11" East 32.78 feet to the Centerline of 7500 West Street; thence South 1°05'35" West 17.92 feet along said Centerline of 7500 West Street to the Extension of an existing fence line; thence North 89°12'50" West 366.29 feet along said extended fence line and the existing fence line; thence North 1°14'49" East 20.84 feet to the Point of Beginning.

BUNOT (0006)

A part of the Northeast Quarter of Section 15, Township 5 North, Range 3 West, Salt Lake Meridian, U.S. Survey:
 Beginning at an existing fence corner said point being 1642.66 feet North 88°45'11" West along the Section line and 69.80 feet North 1°58'27" East from the East Quarter Corner of Section 15 and running thence South 1°58'27" West 149.22 feet along said existing fence line; thence North 88°34'41" West 6.34 feet; thence North 1°14'49" East 79.40 feet; thence North 36 Rods; thence East 60 Rods; thence South 30 Rods; thence South 1°14'49" West 20.84 feet to an existing fence line; thence West along said existing fence line the following five (5) courses: (1) North 89°12'50" West 3.45 feet; (2) South 89°29'37" West 40.16 feet; (3) North 89°22'20" West 345.52 feet (4) North 88°58'17" West 227.10 feet and (5) North 89°08'46" West 365.58 feet to the Point of Beginning.

Final Description of Moore Property and Trustees' Property

A part of the East Half of Section 15, Township 5 North, Range 3 West, Salt Lake Base and Meridian, U.S. Survey, Hooper City, Weber County, Utah:
 Beginning at the intersection of the Section line and the Centerline of 7500 West Street, which is 296.96 feet North 88°45'11" West along said Section line from the East Quarter Corner of Section 15; running thence two (2) courses along said Centerline as follows: (1) South 1°05'35" West 6.94 feet and (2) South 0°36'09" West 76.60 feet; thence North 88°34'41" West 1347.59 feet to an existing fence line; thence North 1°58'27" East 149.22 feet along said existing fence line to an existing fence corner; thence Easterly along an existing fence line the following five (5) courses: (1) South 89°08'46" East 365.58 feet, (2) South 88°58'17" East 227.10 feet, (3) South 89°22'20" East 345.52 feet, (4) North 89°29'37" East 40.16 feet and (5) South 89°12'50" East 366.29 feet to the Center line of said 7500 West Street; thence South 1°05'35" West 88.02 feet along said Centerline to the Point of Beginning.
 Contains 4.8311 Acres

Original Bunot Property Descriptions
 10-020-0012

PART OF THE NORTHEAST QUARTER OF SECTION 15, TOWNSHIP 5 NORTH, RANGE 3 WEST, SALT LAKE BASE AND MERIDIAN, U.S. SURVEY: BEGINNING AT A POINT 660 FEET WEST AND 6 RODS NORTH OF THE SOUTHEAST CORNER OF SAID QUARTER SECTION, RUNNING THENCE NORTH 30 RODS; THENCE EAST 20 RODS; THENCE SOUTH 30 RODS; THENCE WEST 20 RODS TO THE POINT OF BEGINNING.

10-020-0006

PART OF SECTION 15, TOWNSHIP 5 NORTH, RANGE 3 WEST, SALT LAKE MERIDIAN, U.S. SURVEY: BEGINNING AT A POINT 25 CHAINS WEST FROM THE SOUTHEAST CORNER OF THE NORTHEAST QUARTER OF SAID SECTION 15, RUNNING THENCE NORTH 36 RODS; THENCE EAST 60 RODS; THENCE SOUTH 30 RODS; THENCE WEST 40 RODS; THENCE SOUTH 60 RODS; THENCE WEST 20 RODS TO THE PLACE OF BEGINNING.

Original Moore Property Description (10-020-0014)

PART OF THE NORTHEAST QUARTER AND SOUTHEAST QUARTER OF SECTION 15, TOWNSHIP 5 NORTH, RANGE 3 WEST, SALT LAKE BASE AND MERIDIAN, U.S. SURVEY: BEGINNING AT A POINT 660 FEET WEST AND 6 RODS NORTH OF THE SOUTHEAST CORNER OF THE NORTHEAST QUARTER OF SECTION 15; RUNNING THENCE EAST 363 FEET TO THE CENTER OF THE ROAD; THENCE SOUTH IN THE CENTER OF SAID ROAD 2.74 CHAINS; THENCE WEST 363 FEET; THENCE NORTH 2.74 CHAINS TO THE POINT OF BEGINNING.

Original Trustee Property Description (10-020-0007)

PART OF THE NORTHEAST QUARTER AND THE SOUTHEAST QUARTER OF SECTION 15, TOWNSHIP 5 NORTH, RANGE 3 WEST, SALT LAKE BASE AND MERIDIAN, U.S. SURVEY: BEGINNING AT THE SOUTHWEST CORNER OF THE SOUTHEAST QUARTER OF THE NORTHEAST QUARTER OF SECTION 15; RUNNING THENCE NORTH 6 RODS; THENCE EAST 40 RODS; THENCE SOUTH 2.74 CHAINS; THENCE WEST 60 RODS; THENCE NORTH 1.24 CHAINS; THENCE EAST 20 RODS TO THE PLACE OF BEGINNING.

GREAT BASIN ENGINEERING
 5746 SOUTH 1475 EAST, OGDEN, UTAH 84403
 MAIN (801) 394-4515, FAX (801) 392-7544
 WWW.GREATBASINENGINEERING.COM

Parcel Line Adjustment
Art Moore
 Approx. 5261 South 7500 West
 Hooper City, Weber County, Utah
 A part of Section 15, T5N, R3W, SLB&M, U.S. Survey

23 Oct 2019
 SHEET NO. **1**
 18N603 - Moore LLA