

PARCEL 'A' NEW PROPERTY DESCRIPTION

A part of the Northwest Quarter of Section 26, Township 6 North, Range 3 West, Salt Lake Base and Meridian, U.S. Survey; Beginning at a point South 0°30'42" West 969.00 feet and South 88°26'18" East 66.01 feet from the Northwest Corner of said Section 26; and running thence South 88°26'18" East 435.60 feet; thence South 0°30'42" West 200.00 feet; thence North 88°26'18" West 435.60 feet; thence North 0°30'42" East 200.00 feet to the point of beginning. Contains 2.0 Acres

Together with a 10 foot Easement for water line purposes which centerline is described as follows: Beginning at a point South 0°30'42" West 969.00 feet and South 88°26'18" East 87.81 feet from the Northwest Corner of said Section 26; and running thence South 0°16'07" West 200.00 feet.

SURVEY NARRATIVE

The purpose of this survey was to reshape an existing parcel of property.


The monuments used for this project were Weber County monuments representing the Northwest corner and the West quarter corner of Section 26, T6N, R3W, which are without pedigree.

Existing legal descriptions were reviewed and used for the lack of additional information. A survey performed by Chester L. Nelson for Donald Willson in May 16, 1978 was also used.

SURVEYORS CERTIFICATE

I, John P. Reeve, a Registered Land Surveyor in the State of Utah, holding certificate no. 3492, at the request of Mr. Bradley Willson, do hereby certify that this plat and description were prepared from a survey made on the ground by me or under supervision, and is a true and correct representation of the same to the best of my knowledge and belief.

RECEIVED
JAN 03 1992
Weber County Surveyor

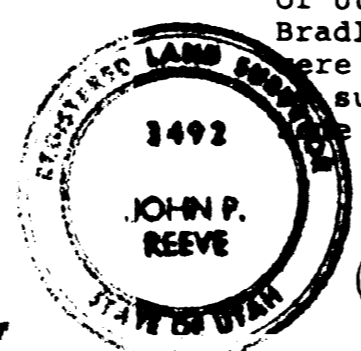


John P. Reeve
John P. Reeve, RLS

2-28-89
Date

LEGEND
O SET 1/2" REBAR W/ PLASTIC CAP MARKED 'REEVE # REEVE, INC.'

SCALE 1" = 50'

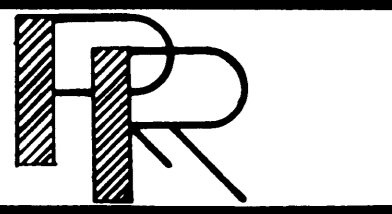

REVISIONS	PROJECT NO.	DESIGNED
1.	2-24-89	J.P.R.
2.		
3.		

DATE 2-24-89 DRAWN J.P.R.
SCALE 1" = 50' APPROVED

REEVE & REEVE, INC.
CIVIL AND ENVIRONMENTAL ENGINEERING
LAND PLANNING AND SITE DESIGN
LAND SURVEYING
OGDEN, UTAH

**PROPERTY SURVEY FOR
P. BRADLEY WILLSON**

000659

SHEET	
SHEETS	

THESE PLANS AND SPECIFICATIONS ARE THE PROPERTY OF REEVE & REEVE, INC., 205 28th STREET, OGDEN, UTAH, 84401 AND SHALL NOT BE COPIED OR REPRODUCED WITHOUT THEIR WRITTEN PERMISSION.