


VICINITY MAP
NO SCALE
LAYTON, DAVIS COUNTY, UTAH

M SURVEYORS CERTIFICATE

I, Trent R. Williams, do hereby represent that I am a Registered Land Surveyor and that I hold Certificate No. 8034679 as prescribed by the laws of the State of Utah and I have made a survey of the following described property, and that it is true and correct based on record information obtained from research and comparing it with survey data collected in the field.

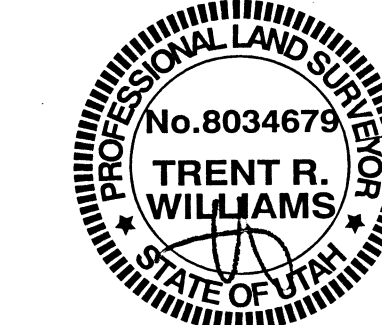

June 22, 2020
Date

Trent R. Williams
License No. 8034679

SURVEY NARRATIVE


The purpose of this survey is to define the boundaries of Lot 13, Oak Forest, for the land owner. Boundaries were established based on record information contained in the recorded plat and evidence found in the field. The rear corners were not set due to tree cover and at the request of the landowners who were not concerned with that area.

PROPERTY DESCRIPTION

All of Lot 13, Oak Forest Subdivision.

LEGEND

SECTION CORNER	ADJACENT RIGHT OF WAY
MONUMENT	RIGHT OF WAY
EXIST REBAR AND CAP	CENTERLINE
SET ENSIGN REBAR AND CAP	PROPERTY LINE
WATER METER	ADJACENT PROPERTY LINE
ELECTRICAL BOX	DEED LINE
CABLE BOX	TANGENT LINE
TELEPHONE BOX	FENCE
	EDGE OF ASPHALT
	CONCRETE
	BUILDING

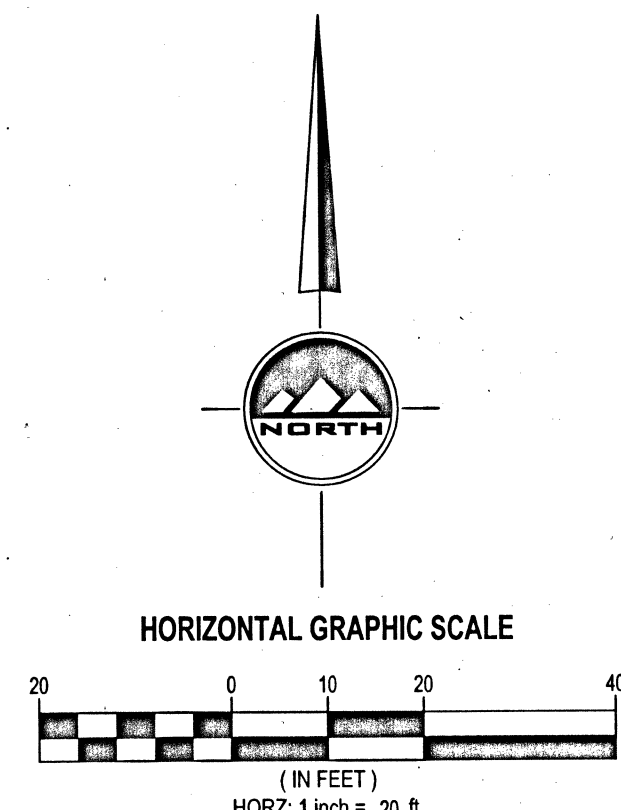

LOCATED IN THE SOUTHEAST
OF SECTION 11
TOWNSHIP 4 NORTH, RANGE 1 WEST
SALT LAKE BASE AND MERIDIAN
LAYTON, DAVIS COUNTY, UTAH



SALT LAKE CITY
45 W. 10000 S., Suite 500
Sandy, UT 84070
Phone: 801.255.0529

LAYTON
Phone: 801.547.1100

TOOELE
Phone: 435.843.3590

CEDAR CITY
Phone: 435.865.1453

RICHFIELD
Phone: 435.896.2983

WWW.ENSGNENG.COM

FOR:
MICHAEL ORME
2782 BRINTON WAY
LAYTON, UTAH 84040
CONTACT:
PHONE: 801-927-7318

ORME PROPERTY SURVEY
2782 BRINTON WAY
LAYTON, UTAH 84040

RECEIVED
BY: 6609

BOUNDARY SURVEY

PROJECT NUMBER: 9888 PRINT DATE: 6/19/20
DRAWN BY: A.SHELBY CHECKED BY: T.WILLIAMS
PROJECT MANAGER: T.WILLIAMS

1 OF 1