


SURVEYORS CERTIFICATE

I, Larry M. Buttars, a registered Land Surveyor as prescribed by the laws of the State of Utah, and holding licence No. 2596, do hereby certify that I made a survey of the below described property and the Plat hereon is a true and correct representation of said survey.

Date: 2-3-92 Sign: Larry M. Buttars

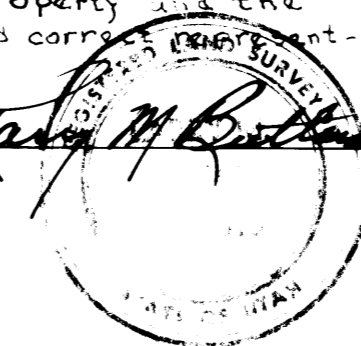

DESCRIPTION

Part of the N.E. 1/4 of Section 25, T. 6 N., R. 2 W., S. 1 B. & M., U.S. Survey: Beginning at a point 150 ft. N. 1° 05' E. along the Section line from the S.W. corner of said 1/4 Section, and running thence N. 1° 05' E. 224.62 ft. along the West line of said 1/4 Section; thence S. 87° 06' E. 132.00 ft., thence S. 1° 05' W. 186.62 ft., thence N. 86° 46' W. 68.00 ft., thence S. 61° 28' 15" W. 73.60 ft. to the point of beginning.

NARRATIVE

The purpose of this Survey was to establish property corners for development of property. Bearing base established from data provided by W.C. Surveyors office and computing the West line of N.E. 1/4 to State plane grid.

LEGEND

- o Set 3/4" x 24" re-bar with plastic cap stamped L. Buttars R.L.S. 2596.
- Set P.K. nail with ribbon

RECEIVED

FEB 14 1992

Weber County Surveyors

BUTTARS SURVEYING	
1815 26 TH STREET	OGDEN, UT. 84401
PHONE	392-5291
CLIENT: RON FUHRIMAN	
SURVEY LOCATION: N. E. 1/4 OF SEC. 25, T. 6 N., R. 2 W. WEBER COUNTY, UTAH	
SURVEY DATE: 2-1-92	

