


**SURVEYORS CERTIFICATE**

I, Larry M. Buttars, a registered Land Surveyor as prescribed by the laws of the State of Utah, and holding licence No. 2596, do hereby certify that I made a survey of the herein described property and the Plat hereon is a true and correct representation of said survey.

Date 1-21-92 Sign Larry M. Buttars

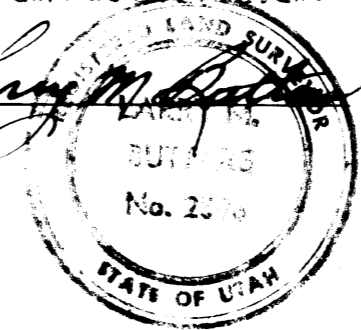

**DESCRIPTION**

Part of the N.E. 1/4 of Section 24, T. 6 N., R. 2 W., S.L.B. & M., U.S. Survey: Beginning at a point on the West line of 1200 West St., N. 0° 25' W. 479.19 ft. and S. 89° 35' W. 33.0 ft. from the Monument at 1200 West St. and 12th Street, said point of beginning having been given as West 10.66 chain, along the Section line and 859.76 ft. S. 0° 30' W. and 35 ft. West from the N.E. cor. of Section 24, T. 6 N., R. 2 W. and running thence S. 0° 25' E. 161.0 ft., thence N. 88° 20' W. 258.54 ft., thence N. 0° 25' W. 161.0 ft., thence S. 88° 20' E. 258.54 ft. to the Point of beginning.  
Containing 0.965 Ac.

**NARRATIVE**

The purpose of this Survey was to establish corners for purchaser of property to re-fence.  
Ogden City Bearings were used for this Survey.  
The description of record gives ties to the Section corner which cannot be rectified. The property corners were located by physical evidence and the "Marriott Country Estates" Condominium Record of Survey Plat.

**LEGEND**

- Set 3/4" x 24" re-bar with plastic cap, stamped L. Buttars, R.L.S. 2596.
- Set 1/2" x 1/2" iron nail

RECORDED  
FEB 14 1992  
Weber County Surveys

<b>BUTTARS SURVEYING</b>	
1815 26th STREET	OGDEN, UT. 84401
PHONE	392-5291
CLIENT: CAROL EDDY	
SURVEY LOCATION: N.E. 1/4 SEC. 24, T. 6 N., R. 2 W., S.L.B. & M. WEBER COUNTY, UTAH	
SURVEY DATE: 12-1-91	