


(LIVING SCRIPTURES)  



NARRATIVE  
 THIS SURVEY WAS DONE TO LOCATE THE BOUNDARIES OF THE ABOVE DESCRIBED PARCEL AND TO PROVIDE THE TOPOGRAPHY REQUIRED FOR REVISION OF THE PROPERTY.

I, CLAREN SANDERS, DO HEREBY CERTIFY THAT I AM A REGISTERED LAND SURVEYOR AND THAT I HOLD CERTIFICATE NO. 3815, AS PRESCRIBED BY THE STATE OF UTAH, AND I HAVE MADE A SURVEY OF THE ABOVE DESCRIBED PROPERTY. I FURTHER CERTIFY THAT ABOVE PLAT CORRECTLY SHOWS THE TRUE DIMENSIONS OF THE PROPERTY SURVEYED.

NOV. 13, 1991  
 Claren Sanders  
 DEED SURVEYOR

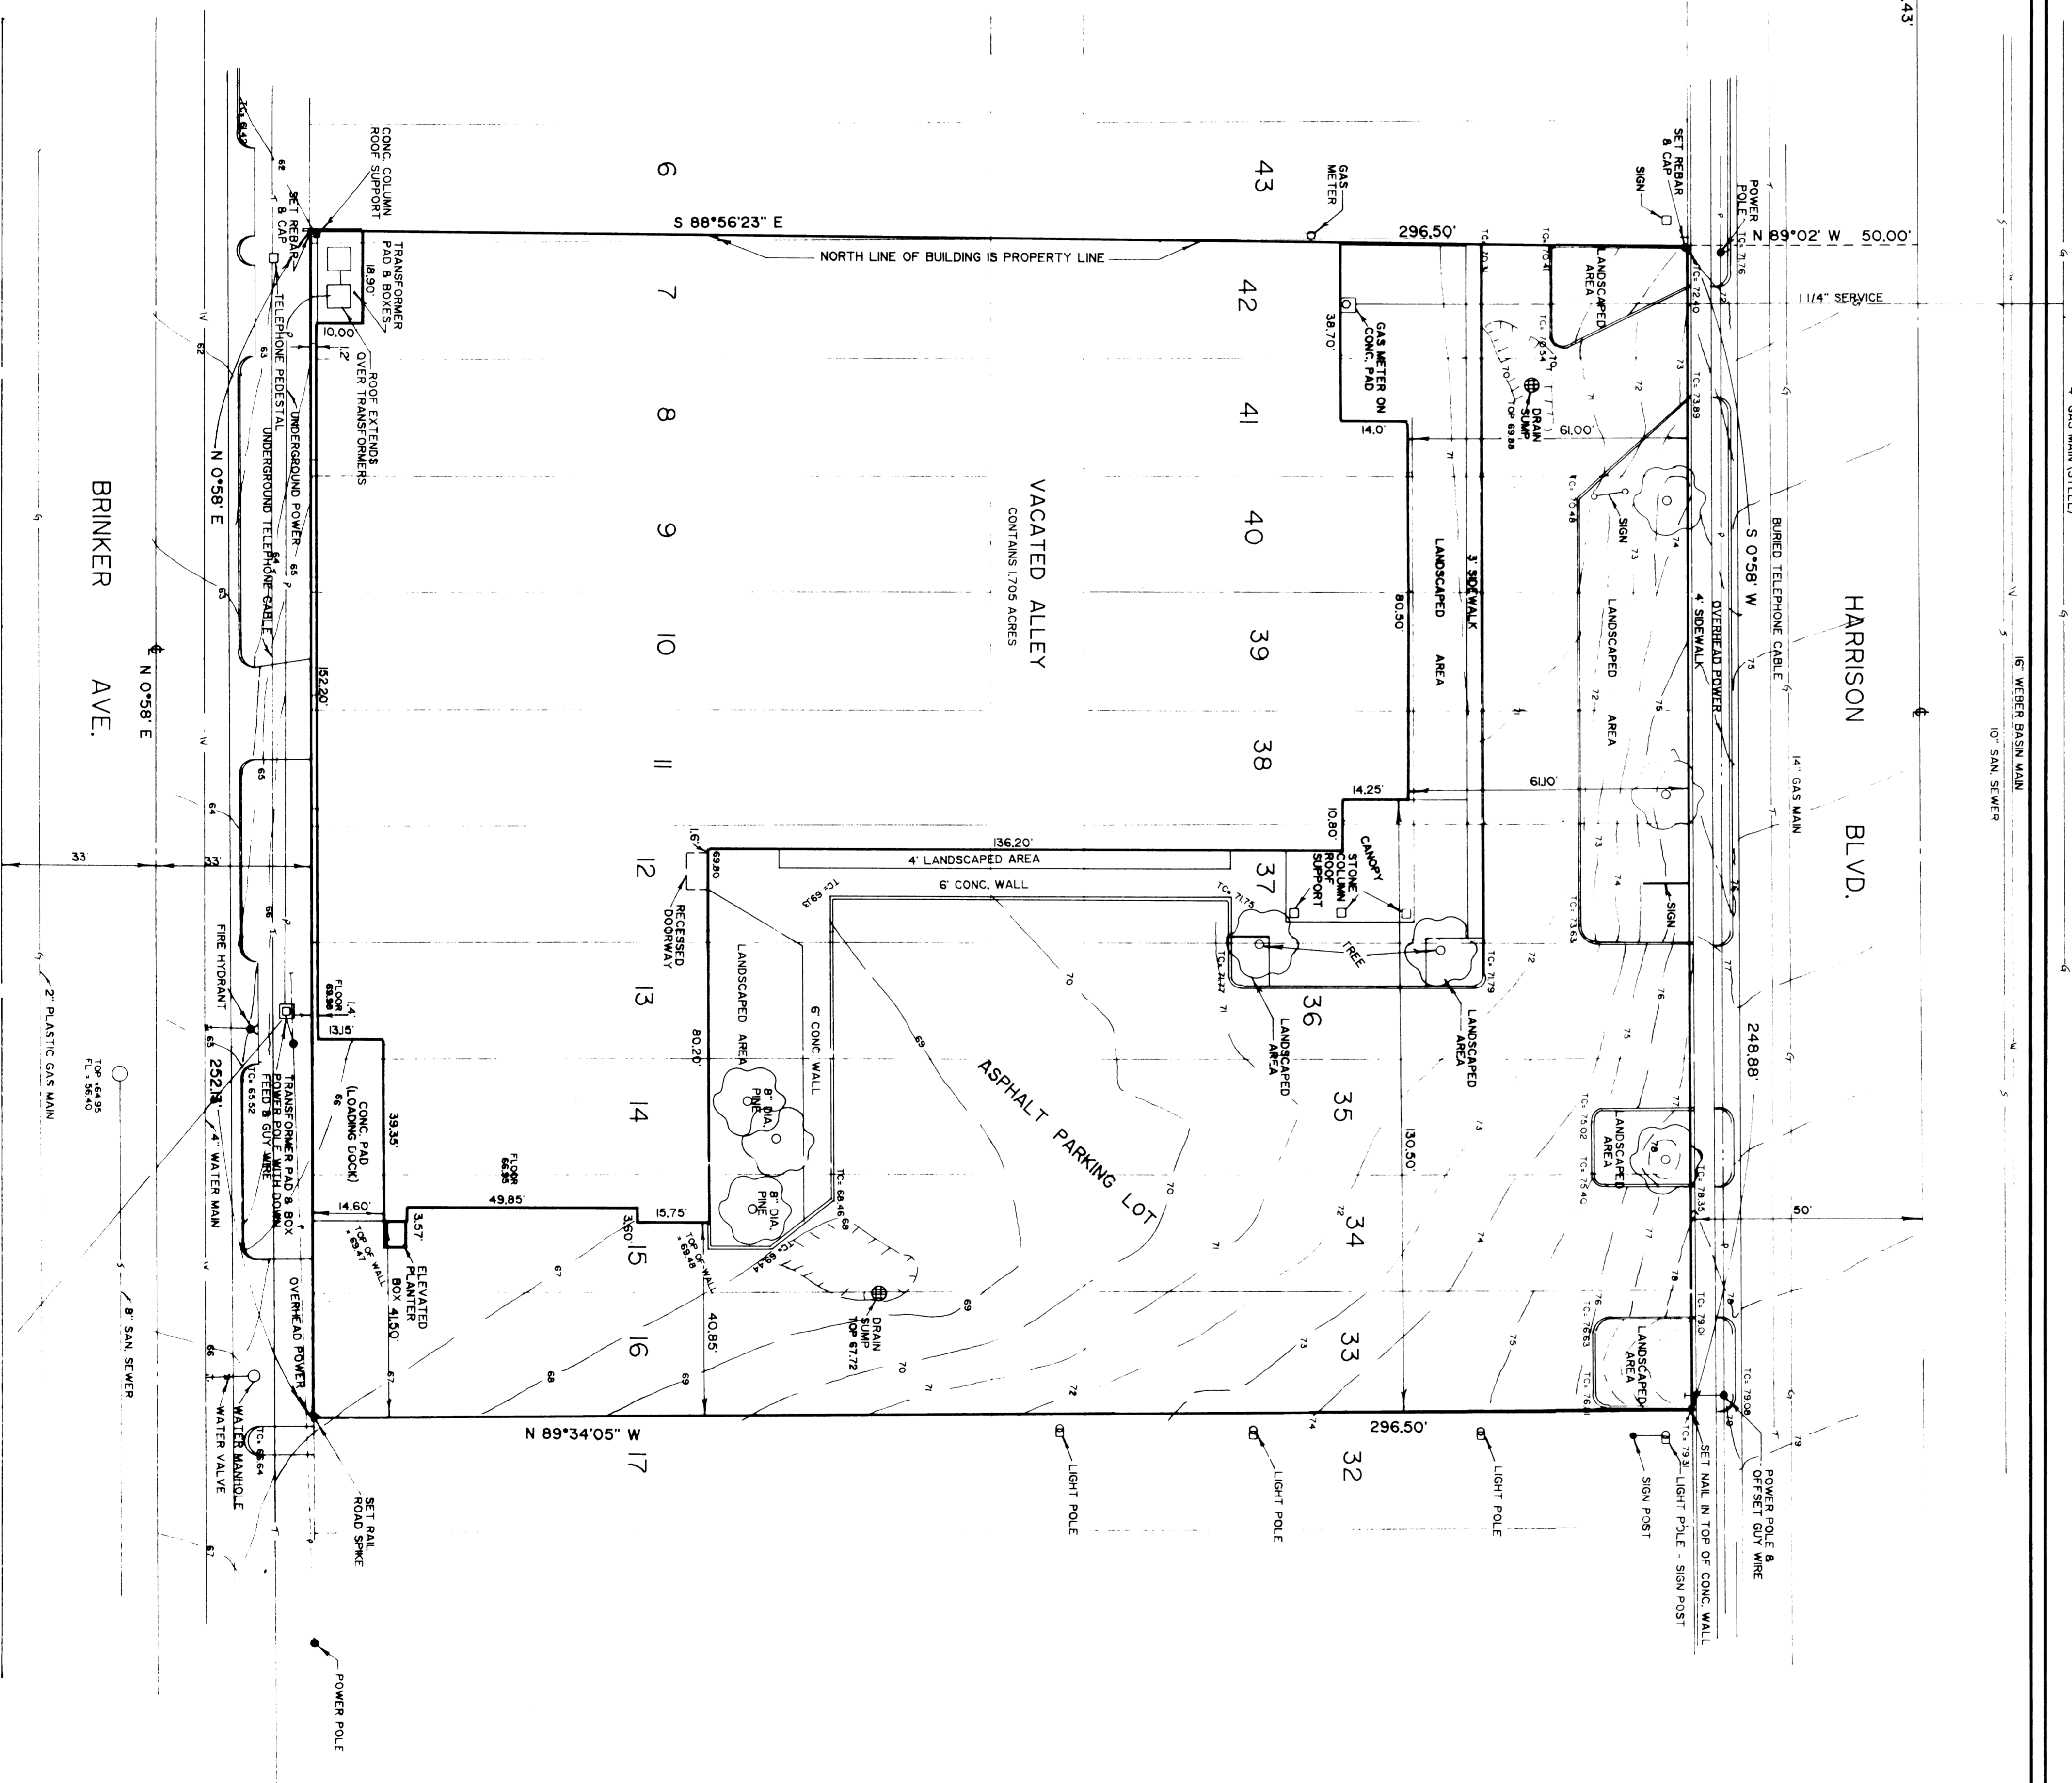

SCALE 1" = 20'



PART OF THE SE 1/4 OF SEC. 4, T3N, 30W, S18BN  
 INTERMOUNTAIN SURVEYING  
 5450 S. 1000 E. SUITE 200  
 SALT LAKE CITY, UTAH 84115  
 PROPERTY SURVEY & TOPO  
 FOR  
 MIKE SANDERS  
 PART OF BLOCK 42, NELSON PARK ADDITION  
 NOV. 13, 1991  
 1" = 20'  
 PS, 81-19

R.E.C. : L.D.  
 MAR 0 1992  
 WEBER COUNTY SURVEYOR