

ORIGINAL PARCEL 240190007 BOUNDARY DESCRIPTION

THAT PORTION OF THE FOLLOWING DESCRIBED PROPERTY LYING EAST OF THE HUNTSVILLE TOWN BOUNDARY, PART OF THE NORTHEAST QUARTER OF SECTION 18, TOWNSHIP 6 NORTH, RANGE 2 EAST, SALT LAKE BASE & MERIDIAN, U S SURVEY, DESCRIBED AS FOLLOWS: BEGINNING AT THE INTERSECTION OF AN EXISTING FENCE AND THE WEST RIGHT OF WAY LINE OF 7800 EAST STREET OR STATE HIGHWAY 39, SAID POINT BEING NORTH 00D22'07" EAST ALONG THE SECTION LINE 342.58 FEET AND NORTH 89D37'53" WEST 791.46 FEET FROM THE EAST 1/4 CORNER OF SAID SECTION 18; THENCE ALONG SAID FENCE SOUTH 85D48'40" WEST 407.65 FEET TO THE EAST RIGHT OF WAY LINE OF 7700 EAST STREET; THENCE ALONG SAID LINE NORTH 01D03'54" WEST 291.95 FEET TO A FENCE; THENCE ALONG SAID FENCE NORTH 87D53'23" EAST 406.84 FEET TO THE WEST RIGHT OF WAY LINE OF 7800 EAST OR STATE HIGHWAY 39; THENCE ALONG SAID LINE SOUTH 01D07'17" EAST 277.16 FEET TO THE POINT OF BEGINNING.

ORIGINAL PARCEL 2401900015 BOUNDARY DESCRIPTION



THAT PORTION OF THE FOLLOWING DESCRIBED PROPERTY LYING WITHIN THE HUNTSVILLE TOWN BOUNDARY, PART OF THE NORTHEAST QUARTER OF SECTION 18, TOWNSHIP 6 NORTH, RANGE 2 EAST, SALT LAKE BASE & MERIDIAN, U S SURVEY, DESCRIBED AS FOLLOWS: BEGINNING AT THE INTERSECTION OF AN EXISTING FENCE AND THE WEST RIGHT OF WAY LINE OF 7800 EAST STREET OR STATE HIGHWAY 39, SAID POINT BEING NORTH 00D22'07" EAST ALONG THE SECTION LINE 342.58 FEET AND NORTH 89D37'53" WEST 791.46 FEET FROM THE EAST 1/4 CORNER OF SAID SECTION 18; THENCE ALONG SAID FENCE SOUTH 85D48'40" WEST 407.65 FEET TO THE EAST RIGHT OF WAY LINE OF 7700 EAST STREET; THENCE ALONG SAID LINE NORTH 01D03'54" WEST 291.95 FEET TO A FENCE; THENCE ALONG SAID FENCE NORTH 87D53'23" EAST 406.84 FEET TO THE WEST RIGHT OF WAY LINE OF 7800 EAST OR STATE HIGHWAY 39; THENCE ALONG SAID LINE SOUTH 01D07'17" EAST 277.16 FEET TO THE POINT OF BEGINNING.

ADJUSTED PARCEL 240190007 BOUNDARY DESCRIPTION

A PART OF THE NORTHEAST QUARTER OF SECTION 18, TOWNSHIP 6 NORTH, RANGE 2 EAST, OF THE SALT LAKE BASE AND MERIDIAN, BEGINNING AT A POINT ON THE WEST RIGHT-OF-WAY LINE OF STATE HIGHWAY 39 BEING LOCATED NORTH 0°22'13" EAST 347.63 FEET AND NORTH 90°00'00" WEST 792.01 FEET FROM THE EAST QUARTER CORNER OF SAID QUARTER SECTION 18, RUNNING THENCE SOUTH 85°48'40" WEST 108.00 FEET; THENCE NORTH 50°38'27" WEST 134.02 FEET; THENCE NORTH 50°33'46" WEST 59.45 FEET; THENCE ALONG THE ARC OF A 50.00 FOOT RADIUS CURVE TO THE RIGHT 6.49 FEET, HAVING A CENTRAL ANGLE OF 07°26'03"; CHORD BEARS NORTH 50°22'26" WEST 6.48 FEET; THENCE ALONG THE ARC OF A 30.00 FOOT RADIUS CURVE TO THE LEFT 23.


ADJUSTED PARCEL 240190015 BOUNDARY DESCRIPTION

A PART OF THE NORTHEAST QUARTER OF SECTION 18, TOWNSHIP 6 NORTH, RANGE 2 EAST, OF THE SALT LAKE BASE AND MERIDIAN, BEGINNING AT A POINT ON THE WEST RIGHT-OF-WAY LINE OF STATE HIGHWAY 39 BEING LOCATED NORTH 0°22'13" EAST 347.63 FEET AND NORTH 90°00'00" WEST 792.01 FEET AND SOUTH 85°48'40" WEST 108.00 FEET FROM THE EAST QUARTER CORNER OF SAID QUARTER SECTION 18, RUNNING THENCE SOUTH 85°48'40" WEST 301.10 FEET TO THE EAST RIGHT-OF-WAY LINE OF 7700 EAST STREET; THENCE ALONG SAID EAST RIGHT-OF-WAY LINE NORTH 01°10'44" WEST 152.13 FEET; THENCE NORTH 87°46'12" EAST 141.35 FEET; THENCE ALONG THE ARC OF A 30.00 FOOT RADIUS CURVE TO THE RIGHT 23.86 FEET, HAVING A CENTRAL ANGLE OF 45°34'23"; CHORD BEARS SOUTH 69°26'37" EAST 23.24 FEET; THENCE ALONG THE ARC OF A 50.00 FOOT RADIUS CURVE TO THE LEFT 6.49 FEET, HAVING A CENTRAL ANGLE OF 07°26'03"; CHORD BEARS SOUTH 50°22'26" EAST 6.48 FEET; THENCE SOUTH 50°33'46" EAST 59.45 FEET; THENCE SOUTH 50°38'27" EAST 134.02 FEET TO THE POINT OF BEGINNING, CONTAINING 32,671 SQUARE FEET.

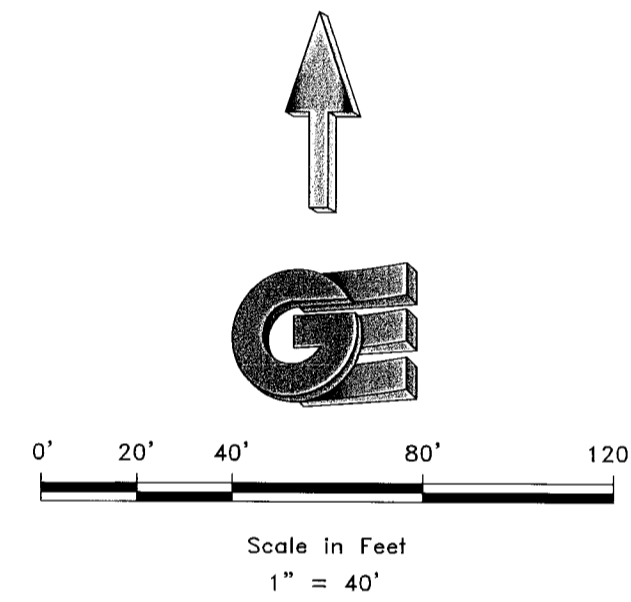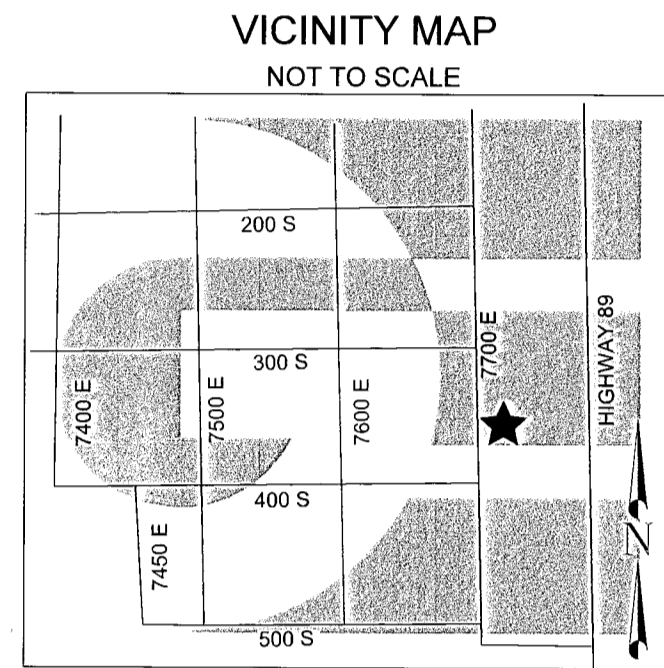

LEGEND

- ◆ WEBER COUNTY MONUMENT AS NOTED
- SET 24" REBAR AND CAP MARKED GARDNER ENGINEERING
- SUBJECT PROPERTY BOUNDARY
- LOT LINE
- ADJACENT PARCEL
- SECTION LINE
- EASEMENT
- EXISTING FENCE LINE
- SETBACK LINE
- 5' CONTOURS
- 1' CONTOURS
- EXISTING CONCRETE
- EXISTING ASPHALT
- ⊙ EXISTING TREE
- ⊕ EXISTING POWER POLE
- EXISTING POWER LINE

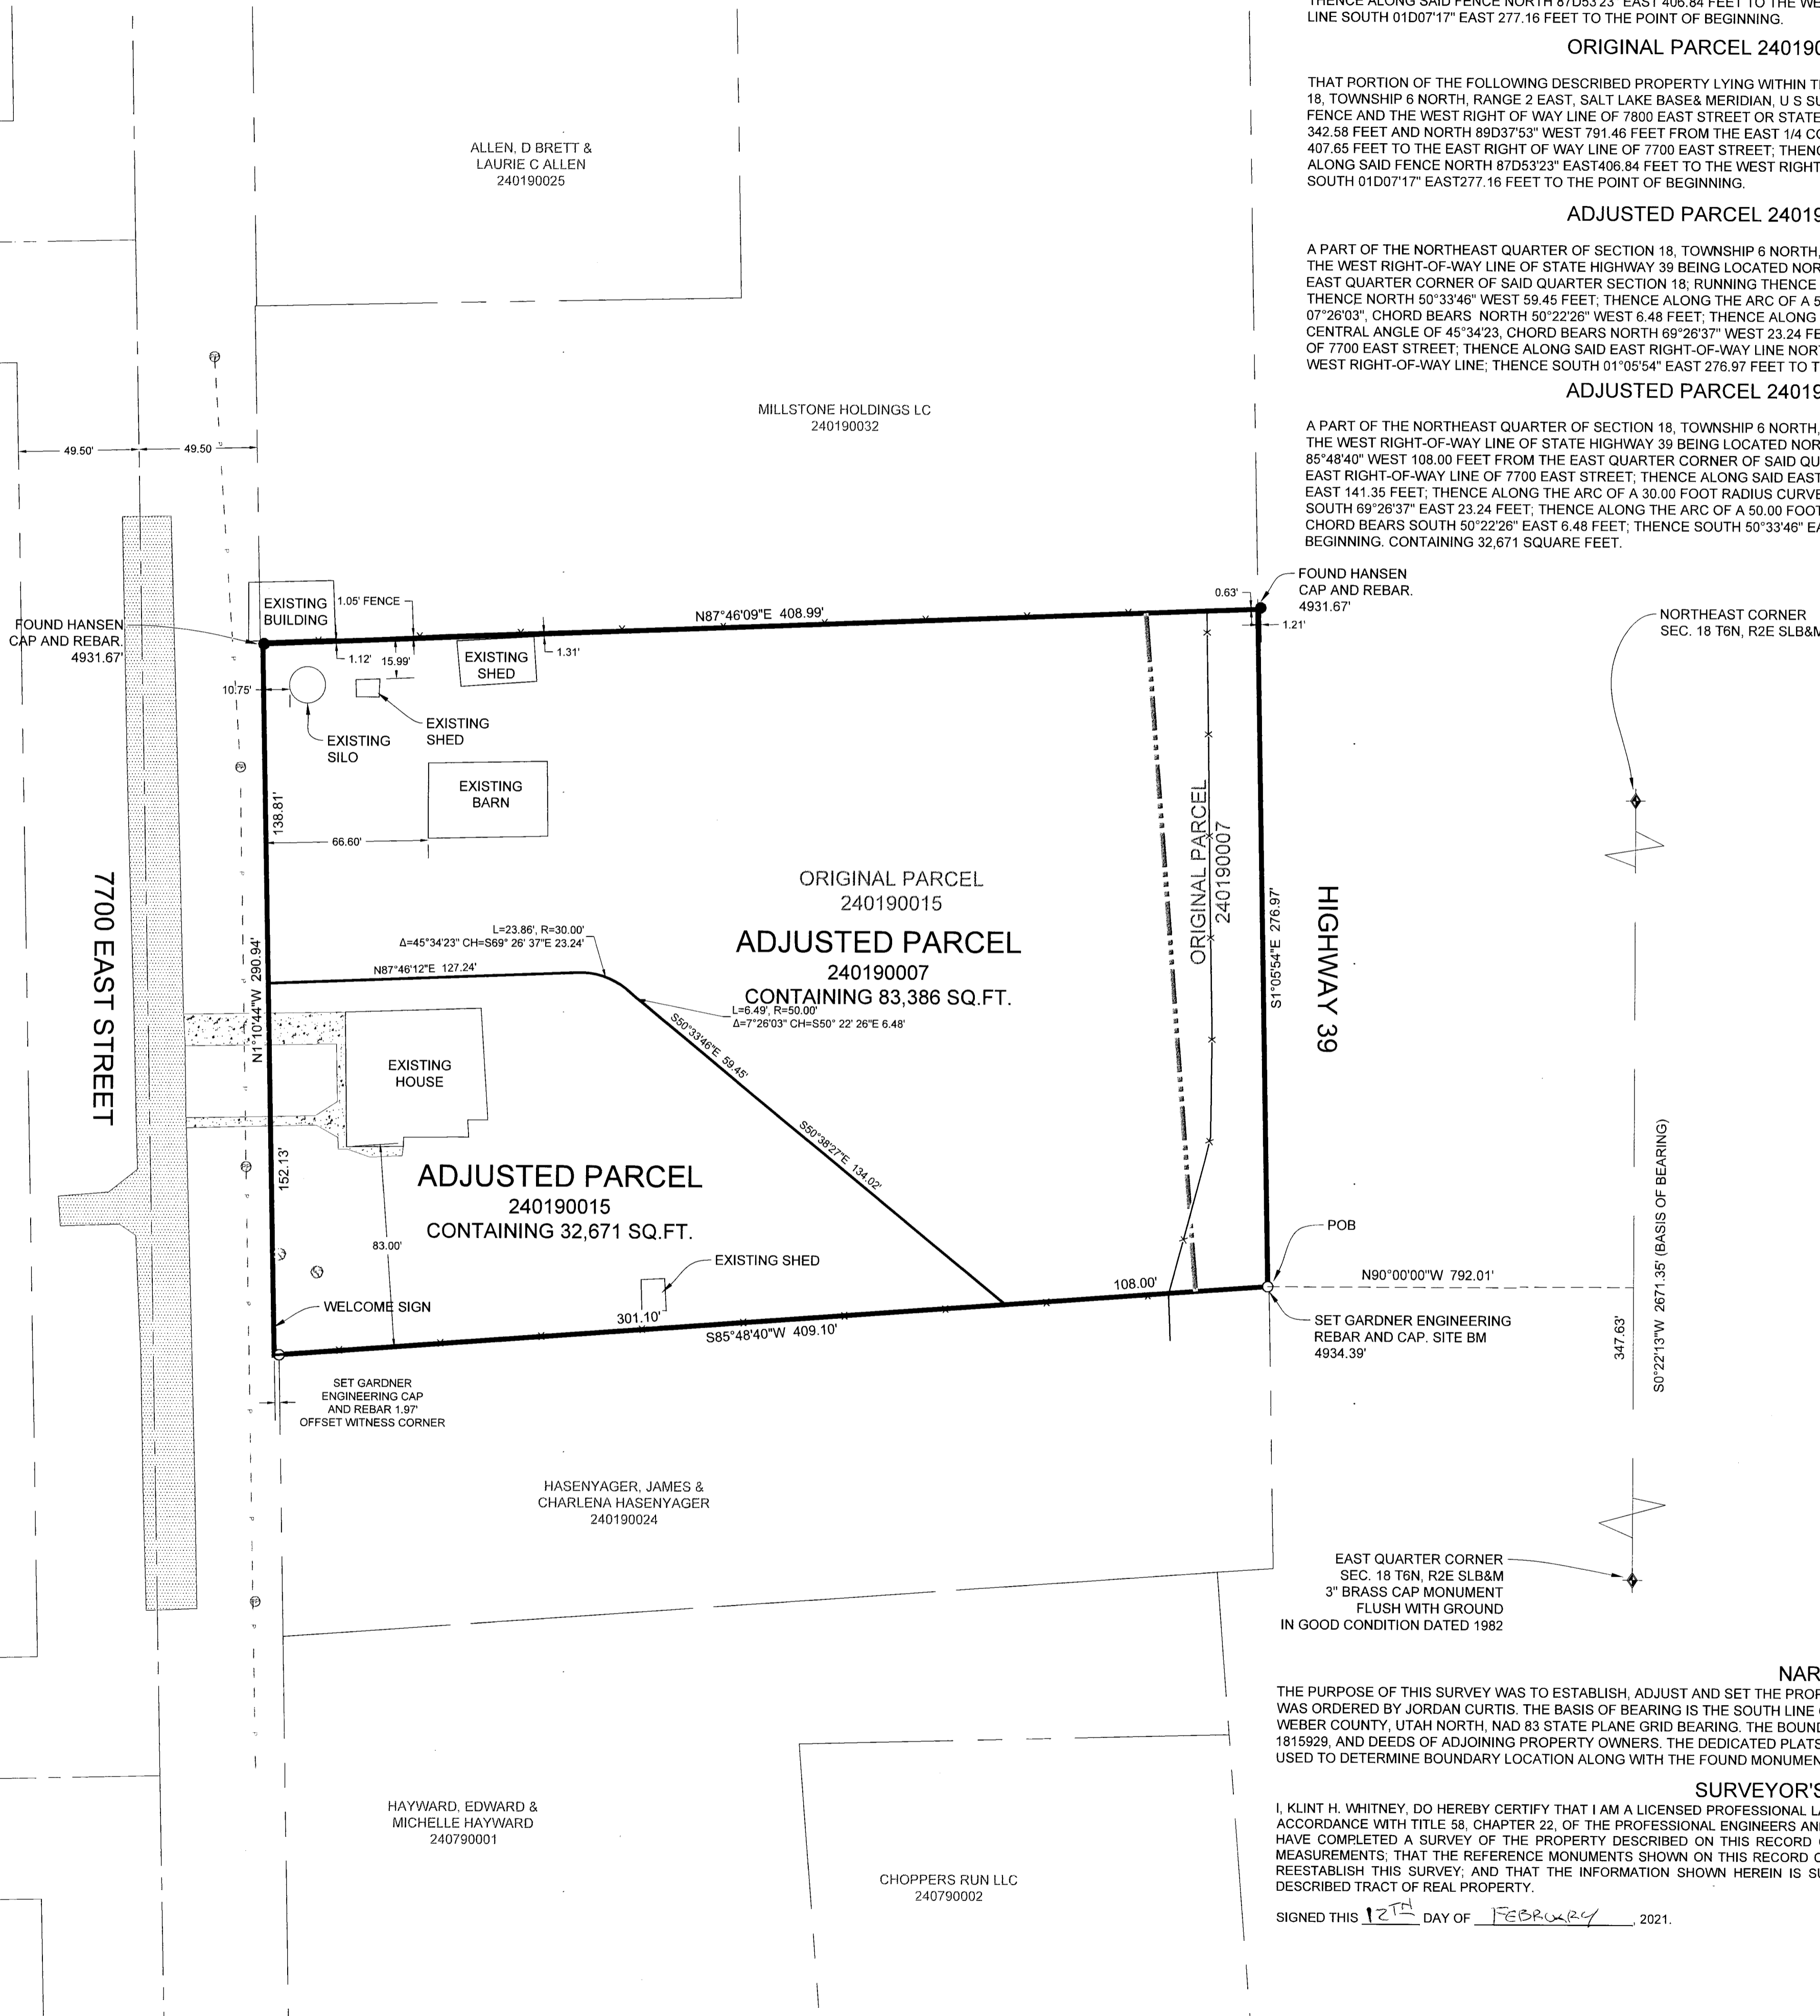

SCALE: 1" = 40'	DATE: 7/1/20	DESIGN: KHV	CHECKED: KHV
REVISIONS	DESCRIPTION	DATE	

REGISTERED PROFESSIONAL LAND SURVEYOR  
 FEB 16 2021  
 BY: J. CURTIS

BOUNDARY ADJUSTMENT SURVEY FOR JORDAN CURTIS  
 HUNTSVILLE, UTAH  
 LOCATED IN THE NORTHEAST QUARTER OF SECTION 18,  
 TOWNSHIP 6 NORTH, RANGE 2 EAST, S.L.B. AND M.

**GARDNER ENGINEERING**  
 CIVIL, LAND PLANNING  
 MUNICIPAL, LAND SURVEYING  
 5710 SOUTH 575 EAST, OGDEN, UT  
 OFFICE: 801.476.0202 FAX: 801.476.0066

S1  
 1

NARRATIVE

THE PURPOSE OF THIS SURVEY WAS TO ESTABLISH, ADJUST AND SET THE PROPERTY CORNERS OF THE PARCEL AS SHOWN AND DESCRIBED HEREON. THE SURVEY WAS ORDERED BY JORDAN CURTIS. THE BASIS OF BEARING IS THE SOUTH LINE OF THE NORTHEAST QUARTER OF SECTION 18, WHICH BEARS NORTH 0°22'13" WEST, WEBER COUNTY, UTAH NORTH, NAD 83 STATE PLANE GRID BEARING. THE BOUNDARY WAS DETERMINED BY WARRANTY DEED RECORDED AS ENTRY NUMBER 1815929, AND DEEDS OF ADJOINING PROPERTY OWNERS. THE DEDICATED PLATS OF BILL WHITE MINOR SUBDIVISION AND GIL WANGSGARD SUBDIVISION WERE ALSO USED TO DETERMINE BOUNDARY LOCATION ALONG WITH THE FOUND MONUMENTS AS SHOWN AND DESCRIBED HEREON.

SURVEYOR'S CERTIFICATE

I, KLINT H. WHITNEY, DO HEREBY CERTIFY THAT I AM A LICENSED PROFESSIONAL LAND SURVEYOR IN THE STATE OF UTAH AND THAT I HOLD CERTIFICATE NO. 8227228 IN ACCORDANCE WITH TITLE 58, CHAPTER 22, OF THE PROFESSIONAL ENGINEERS AND LAND SURVEYORS ACT; I FURTHER CERTIFY THAT BY AUTHORITY OF THE OWNERS I HAVE COMPLETED A SURVEY OF THE PROPERTY DESCRIBED ON THIS RECORD OF SURVEY PLAT IN ACCORDANCE WITH SECTION 17-23-20 AND HAVE VERIFIED ALL MEASUREMENTS, THAT THE REFERENCE MONUMENTS SHOWN ON THIS RECORD OF SURVEY PLAT ARE LOCATED AS INDICATED AND ARE SUFFICIENT TO RETRACE OR REESTABLISH THIS SURVEY; AND THAT THE INFORMATION SHOWN HEREIN IS SUFFICIENT TO ACCURATELY ESTABLISH THE LATERAL BOUNDARIES OF THE HEREIN DESCRIBED TRACT OF REAL PROPERTY.

SIGNED THIS 12<sup>TH</sup> DAY OF FEBRUARY, 2021.

