

REORDER BY NUMBER 0758
FOR THE USE OF PLAN HOLD CORP.

REORDER BY NUMBER 0758
FOR THE USE OF PLAN HOLD CORP.

REORDER BY NUMBER 0758
FOR THE USE OF PLAN HOLD CORP.

**BOISE CASCADE

This survey was ordered by The Home Abstract and Title Company for Boise Cascade for the purpose of establishing property lines. Ogden City bearing base and existing Ogden City monuments were used to establish the boundaries of the Block and Lots (Notes: No State Plane Grid Bearings Had Been Established in This Area At The Time of The Survey).

PARCEL 1: (#01-043-0003)

A part of Lot 1 in Block 53, Plat A, OGDEN CITY SURVEY, in the City of Ogden, Weber County, Utah, described as follows:
or 5,460 Square Feet

PARCEL 2: (#01-043-0005)



A part of Lot 1 in Block 53, Plat A, OGDEN CITY SURVEY, in the City of Ogden, Weber County, Utah, described as follows:
Beginning 105 feet North of the southeast corner of said Lot 1, running thence North 60 feet; thence West 264 feet; thence South 60 feet; thence East 264 feet to the place of beginning.
Contains 0.364 Acres
or 15,840 Square Feet

CERTIFICATE


TO BOISE CASCADE CORPORATION AND THE HOME ABSTRACT AND TITLE COMPANY:
This is to certify that this map or plat and the survey on which it is based were made in accordance with Minimum Standard Detail Requirements for ATRATION Land Title Surveys, jointly established and adopted by ALTA and ACSM in 1986.



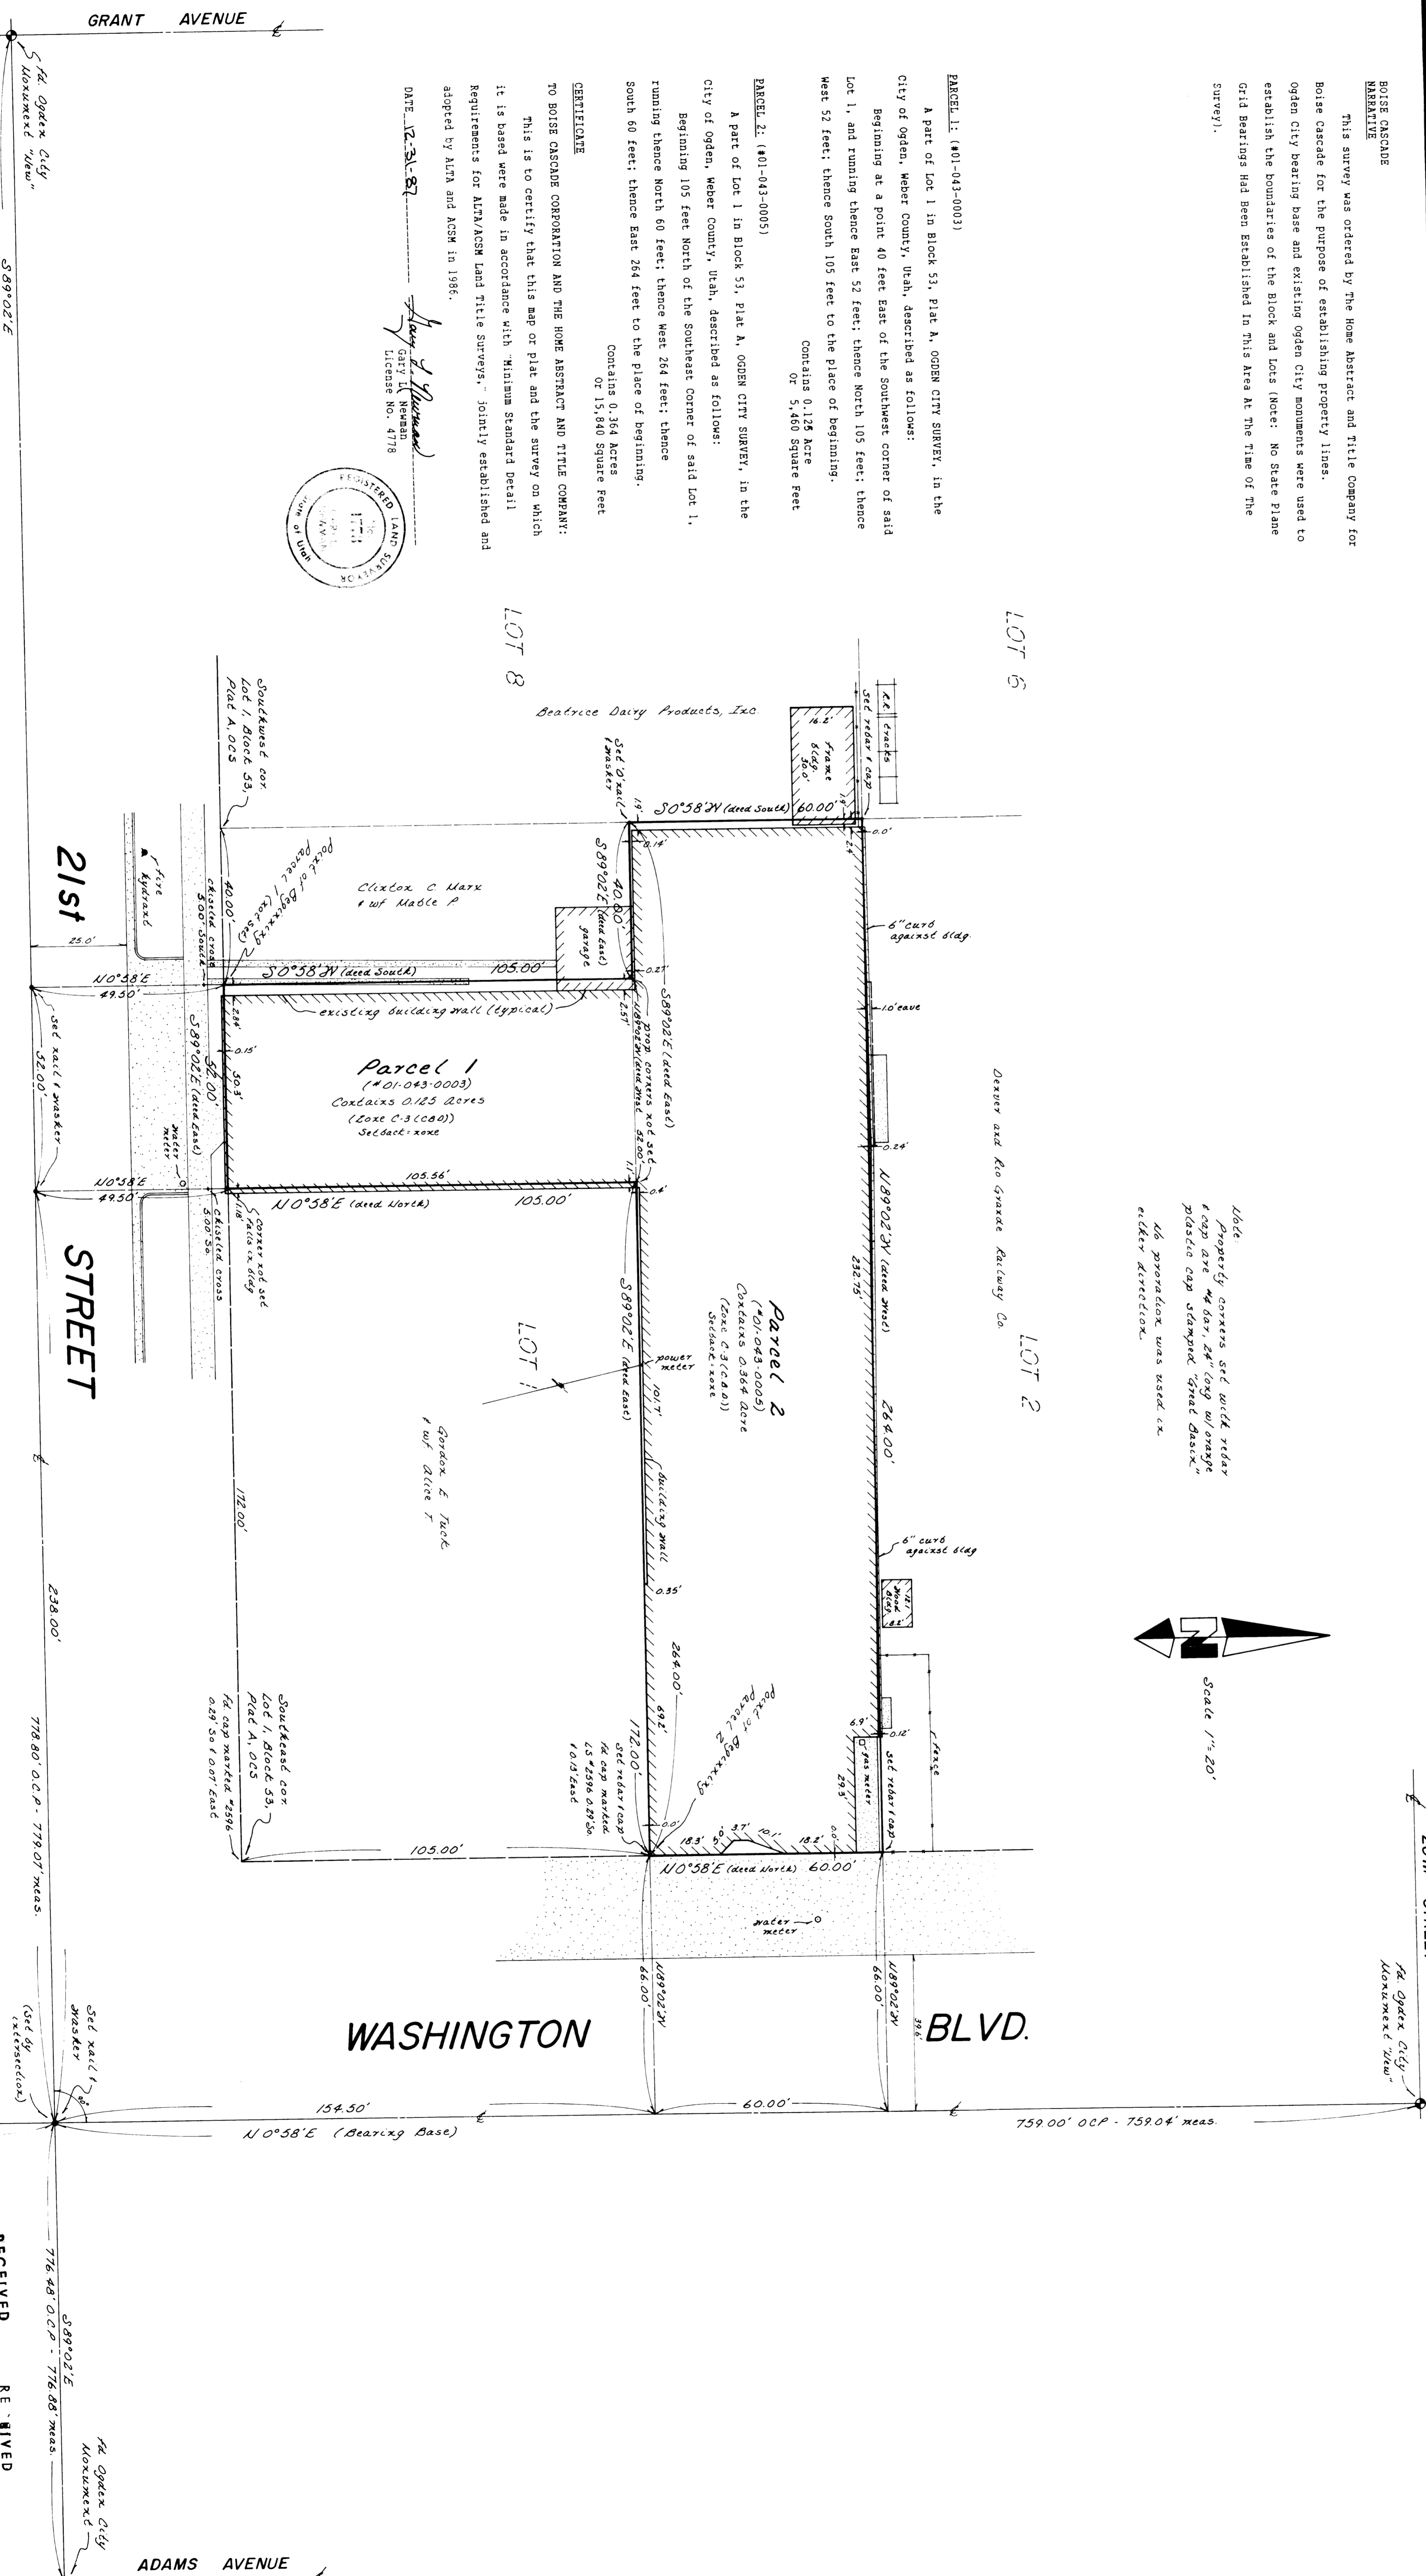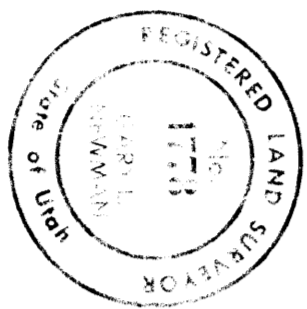

Note:

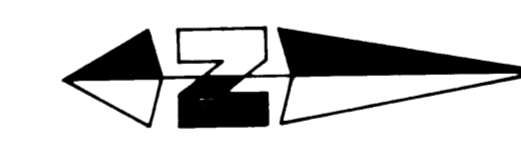

Scale 1\"/>


RECEIVED
FEB 02 1988

RECEIVED
02 1988

Walter County Surveyor
Walter County Surveyor

GREAT BASIN ENGINEERING, INC.
CONSULTING ENGINEERS & SURVEYORS
OGDEN & SALT LAKE CITY, UTAH

Boise Cascade
for
Property Survey

