


NARRATIVE

This Survey was requested by Mr. Larry Moore for the purpose of retracing the boundaries of these parcels in preparation for Adjusting the Parcel lines between the Properties and to revise the prior Survey prepared showing the 4 parcels consolidated into 3 parcels. (see Weber County Surveyor filing # 6581) By re-establishing the 2 parcels previously combined from parcel 0007 and 0014. Weber County Brass Cap Monuments were found at a Witness corner location to the Southeast corner, at the East Quarter Corner and the Northeast Corner of Section 15, T5N, R3W, SLB&M, U.S. Survey. Basis of bearing being N 1°05'41" E measured between the East Quarter corner and the Northeast Corner of said Section. A rebar with a melted cap was found at the Northwest corner of Bird's Place Subdivision, its location checks with the information shown on the Recorded Plat (Entry No 1249644, in book 36, at Page 55, of the Weber County Recorder's Office). Property lines were established along deed lines. Property corners were monumented as depicted on this drawing.

Northeast Corner of Section 15, T5N, R3W, SLB&M, U.S. Survey (Found Weber County Brass Cap in Good Condition Dated 1974 Flush with Road Surface)

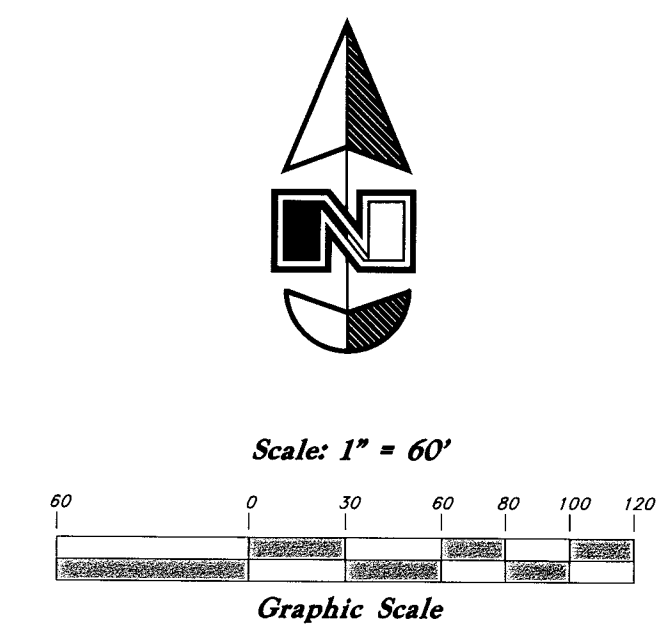


Legend
 ▲ Set Nail & Washer
 ● Set Rebar & Cap w/ Fencepost
 ⊙ Set Hub & Tack Monument to be set
 (Rad.) Radial Line
 (N/R) Non-Radial Line
 --- Fence

East Quarter Corner of Section 15, T5N, R3W, SLB&M, U.S. Survey (Found Weber County Brass Cap in Good Condition Dated 1974 6" below grade)

SURVEYOR'S CERTIFICATE

I, Andy Hubbard do hereby certify that I am a Professional Land Surveyor, and that I hold License No. 6242920, in accordance with Title 58, Chapter 22, of the Professional Engineers and Surveyors Licensing Act, and I have made a survey of the above described property according to Sections 17-23-17 and that the above plat correctly shows the true dimensions of the property surveyed.

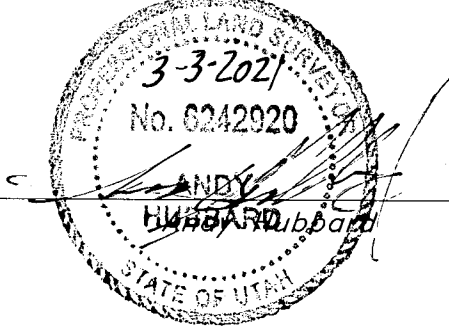

RECEIVED
 MAR 03 2021
 BY: 6815

GREAT BASIN ENGINEERING
 5746 SOUTH 1475 EAST, OGDEN, UTAH 84403
 MAIN (801) 394-4515, S.L.C. (801) 392-7544
 WWW.GREATBASINENGINEERING.COM

Clair Heslop/Art Moore
 Corrected Record of Survey
 A part of Section 15, T5N, R3W, SLB&M, U.S. Survey

AGREED AND FINAL DESCRIPTIONS

AGREED AND FINAL DESCRIPTION FOR BUNOT (0012)
 A part of the Northeast Quarter of Section 15, Township 5 North, Range 3 West, Salt Lake Base and Meridian, U.S. Survey:
 Beginning at a Point 660.00 feet North 88°45'11" West along the Section line and 78.16 feet North 1°14'49" East from the East Quarter Corner of said Section 15; and running thence North 1°14'49" East 20.84 feet to a point described as 660 feet West and 6 Rods North of the Southeast Corner of said Northeast Quarter; thence North 30 Rods; thence East 20 Rods; thence South 30 Rods (South 0°00'32" West 502.18 feet to Close); thence South 88°45'11" East 32.78 feet to the Centerline of 7500 West Street; thence South 1°05'35" West 17.92 feet along said Centerline of 7500 West Street to the Extension of an existing fence line; thence North 89°12'50" West 362.84 feet along said extended fence line and the existing fence line to the Point of Beginning.

AGREED AND FINAL DESCRIPTION FOR BUNOT (0006)
 A part of the Northeast Quarter of Section 15, Township 5 North, Range 3 West, Salt Lake Meridian, U.S. Survey:
 Beginning at an existing fence corner said point being 1642.66 feet North 88°45'11" West along the Section line and 79.41 feet South 1°58'27" West from the East Quarter Corner of Section 15 and running thence North 88°34'41" West 6.34 feet; thence North 1°14'49" East 79.40 feet the Quarter Section line; thence North 36 Rods; thence East 60 Rods; thence South 30 Rods to a point described as 660 feet West and 6 Rods North of the Southeast Corner of said Northeast Quarter (South 0°28'20" West 510.10 feet to Close); thence South 1°14'49" West 20.84 feet to an existing fence line; thence West along said existing fence line the following five (5) courses: (1) North 89°12'50" West 3.45 feet; (2) South 89°29'37" West 40.16 feet, (3) North 89°22'20" West 345.52 feet and (4) North 88°58'17" West 227.10 feet and (5) North 89°08'46" West 365.58 feet to a fence corner; thence South 1°58'27" West 149.22 feet along an existing fence line to the Point of Beginning.

AGREED AND FINAL DESCRIPTION FOR TRUSTEE (0007)
 A part of the East Half of Section 15, Township 5 North, Range 3 West, Salt Lake Base and Meridian, U.S. Survey, Hooper City, Weber County Utah:
 Beginning at a point on the Hooper Water Improvement District Boundary said point being 660.00 feet North 88°45'11" West along the Section line and 78.16 feet North 1°14'49" East from the East Quarter Corner of Section 15; and running thence along said Water District Boundary South 1°14'49" West 160.58 feet; thence North 88°34'41" West 983.67 feet to an existing fence line; thence along said fence North 1°58'27" East a distance of 149.22 feet to an existing fence corner; thence Easterly along an existing fence line the following five (5) courses: (1) South 89°08'46" East 365.58 feet (2) South 88°58'17" East 227.10 feet (3) South 89°22'20" East 345.52 feet and (4) North 89°35'45" East 40.16 feet and (5) South 89°12'50" East 3.45 feet to said Water Improvement Boundary and the point of beginning. Contains 3.472 Acres.

AGREED AND FINAL DESCRIPTION FOR MOORE (0014)
 A part of the East Half of Section 15, Township 5 North, Range 3 West, Salt Lake Base and Meridian, U.S. Survey, Hooper City, Weber County Utah:
 Beginning at a point on the Centerline of 7500 West Street, which is 296.96 feet North 88°45'11" West along the Section line and North 1°05'35" East 81.08 feet along said Centerline from the East Quarter Corner of said Section 15; and running thence two (2) courses along said Centerline as follows: 1) South 1°05'35" West 81.08 feet and 2) South 0°38'35" West 83.54 feet; thence North 88°34'41" West 363.92 feet more or less, to the Hooper Water Improvement District Boundary; thence North 1°14'49" East 160.58 feet along said Hooper Water Improvement Boundary to a fence; thence South 89°12'50" East along said fence 362.84 feet to the centerline of said 7500 West and to the Point of Beginning. Contains 59,054 square feet or 1.356 Acres.

ORIGINAL DESCRIPTIONS

Original Bunot Property Descriptions
 10-020-0012
 PART OF THE NORTHEAST QUARTER OF SECTION 15, TOWNSHIP 5 NORTH, RANGE 3 WEST, SALT LAKE BASE AND MERIDIAN, U.S. SURVEY; BEGINNING AT A POINT 660 FEET WEST AND 6 RODS NORTH OF THE SOUTHEAST CORNER OF SAID QUARTER SECTION, RUNNING THENCE NORTH 30 RODS; THENCE EAST 20 RODS; THENCE SOUTH 30 RODS; THENCE WEST 20 RODS TO THE POINT OF BEGINNING.

10-020-0006
 PART OF SECTION 15, TOWNSHIP 5 NORTH, RANGE 3 WEST, SALT LAKE MERIDIAN, U.S. SURVEY; BEGINNING AT A POINT 25 CHAINS WEST FROM THE SOUTHWEST CORNER OF THE NORTHEAST QUARTER OF SAID SECTION 15, RUNNING THENCE NORTH 36 RODS; THENCE EAST 60 RODS; THENCE SOUTH 30 RODS; THENCE WEST 40 RODS; THENCE SOUTH 6 RODS; THENCE WEST 20 RODS TO THE PLACE OF BEGINNING.

Original Moore Property Description
 10-020-0014
 PART OF THE NORTHEAST QUARTER AND SOUTHEAST QUARTER OF SECTION 15, TOWNSHIP 5 NORTH, RANGE 3 WEST, SALT LAKE BASE AND MERIDIAN, U.S. SURVEY; BEGINNING AT A POINT 660 FEET WEST AND 6 RODS NORTH OF THE SOUTHWEST CORNER OF THE NORTHEAST QUARTER OF SECTION 15; RUNNING THENCE EAST 363 FEET TO THE CENTER OF THE ROAD; THENCE SOUTH IN THE CENTER OF SAID ROAD 2.74 CHAINS; THENCE WEST 363 FEET; THENCE NORTH 2.74 CHAINS TO THE POINT OF BEGINNING.

Original Trustee Property Description
 10-020-0007
 PART OF THE NORTHEAST QUARTER AND THE SOUTHEAST QUARTER OF SECTION 15, TOWNSHIP 5 NORTH, RANGE 3 WEST, SALT LAKE BASE AND MERIDIAN, U.S. SURVEY; BEGINNING AT THE SOUTHWEST CORNER OF THE SOUTHEAST QUARTER OF THE NORTHEAST QUARTER OF SECTION 15; RUNNING THENCE NORTH 6 RODS; THENCE EAST 40 RODS; THENCE SOUTH 2.74 CHAINS; THENCE WEST 60 RODS; THENCE NORTH 1.24 CHAINS; THENCE EAST 20 RODS TO THE PLACE OF BEGINNING.

Center Corner of Section 15, T5N, R3W, SLB&M, U.S. Survey (Not Found Calculated)

Brent D. and Maralyn J. Bunot
 10-020-0005

Vijaya L. Sharma Revocable Trust
 10-021-0048

Brent D. and Maralyn J. Bunot
 10-020-0006

Brent D. and Maralyn J. Bunot
 10-020-0012

Myron D. Fair
 10-020-0015

Christine Horrocks
 10-020-0029

Moore (0014)
 59054 SQ.FT. or 1.356 Acres

Duane and Nay Michael Family Trust
 10-021-0040

Duane and Nay Michael Family Trust
 10-021-0037