


**SURVEYORS CERTIFICATE**

I, Larry M. Buttars, a registered Land Surveyor as prescribed by the laws of the State of Utah, and holding licence No. 2596 do hereby certify that I made a survey of the below described property and the Plat hereon is a true and correct representation of said survey.

Date: 7-17-90 Sign: *Larry M. Buttars*

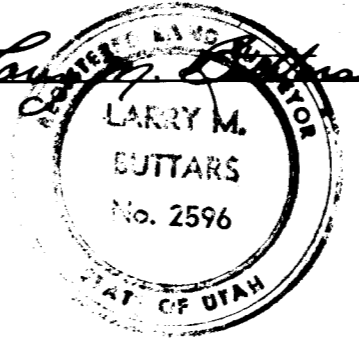

**DESCRIPTION**

Part of the Southwest Quarter of Sec. 19, T. 7 N., R. 1 W., S. 1 B. & M., U.S. Survey: Beginning at a point East 6.31 ft., North 953.81 ft., and N. 23° 28' E. 362.95 ft. from the S.W. corner of said Quarter Section; and running thence N. 23° 28' E. 100.00 ft.; thence S. 65° 55' 14" E. 238.77 ft. to the West line of 1100 West St., thence S. 29° 04' 46" W. 100.00 ft., along said West line; thence N. 65° 55' 14" W. 237.70 ft. to the point of beginning.

**NARRATIVE**

The purpose of this survey was to establish property corners for improvements. Weber County bearing base was used for this survey. bearings given on description not rotated. Evidence found on this, and adjacent properties show the intended location of property's. Old deeds; and Road dedication plat give calls from the section corner as North and East.

**LEGEND**

- Set 3/4" x 24" re-bar with plastic cap stamped L. Buttars R.L.S. 2596
- Set P.K. nail with ribbon

RECEIVED

APR 08 1992

Weber County Surveyor

<b>BUTTARS SURVEYING</b>	
1815 26 <sup>TH</sup> STREET	OGDEN, UT. 84401
PHONE 392-5291	
CLIENT: KIM HOOKER	
SURVEY LOCATION:	
S.W. 1/4 Sec. 19, T. 7 N., R. 1 W., S. 1 B. & M.	
Pleasant View, Weber County, Utah	
SURVEY DATE: 7-14-90	