


SURVEYORS CERTIFICATE

I, Larry M. Buttars, a registered Land Surveyor as prescribed by the laws of the State of Utah, and holding licence No. 2596 do hereby certify that I made a survey of the below described property and the Plat hereon is a true and correct representation of said survey.

Date: 11-27-90 Sign: *Larry M. Buttars*

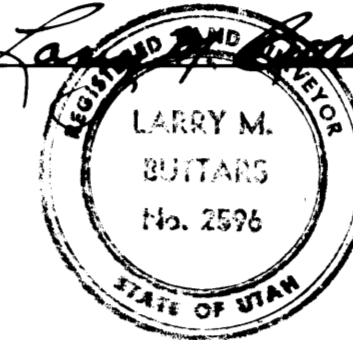

DESCRIPTION

All of Lot 28, EDEN HILLS SUBDIVISION NO. 3, WEBER CO., UTAH, ACCORDING TO THE OFFICIAL PLAT THEREOFF.

NARRATIVE

The purpose of this survey was to establish Lot boundaries for the sale of property. Subdivision plat bearings as recorded were used as basis of bearings.

LEGEND

- Set 3/4" x 24" re-bar with plastic cap stamped L. Buttars R.L.S. 2596
- Set P.K. nail with ribbon
- Set 2"x2" Hub & Tack

RECEIVED
APR 08 1992

BUTTARS SURVEYORS
 215 S. 1000 W. ST. GEORGE, UT 84001
 (435) 633-8881

LANSON MASON TRUST
 PROPERTY LOCATION:
 EDEN HILLS SUBDIVISION NO. 3
 WEBER COUNTY, UTAH
 DATE: 11-24-90