


**SURVEYORS CEPTIFICATE**

I, Larry M. Buttars, a registered Land Surveyor as prescribed by the laws of the State of Utah, and holding licence No. 2596, do hereby certify that I made a survey of the herein described property and the Plat hereon is a true and correct representation of said survey.

Date: 3-20-92 Sign: *Larry M. Buttars*

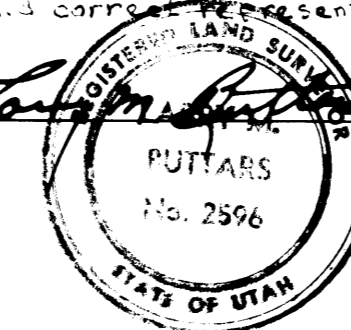

**SURVEY DESCRIPTION**

Part of the East half of the South-west Quarter of Section 36, T.8N., R.1W., S.L.B. & M., U.S. Survey: Beginning at a point 1561.16 ft. North and 1153.40 ft. West of the S.E. corner of the S.W. 1/4 of said Section 36, said corner location changed as recorded in BK. 927, P. 542 (court order recorded in BK. 1020, P. 509, decree recorded in BK. 1040, P. 521) and running thence N. 8°00' E. 298.10 ft., thence N. 70°00' W. 221.44 ft., thence North 235.15 ft., thence S. 56°22'43" E. 216.33 ft., thence S. 38°31' E. 243.27 ft., thence S. 8°00' W. 260.00 ft., thence N. 82°00' W. 60.00 ft., thence S. 56°00' W. 83.77 ft. to the point of beginning.

Contains 1.934 Ac.

**NARRATIVE**

Basis of bearings: South line of the S.E. 1/4 of Sec. 36.  
 The purpose of this Survey was to establish property corners and new description for sale of land. The description surveyed was established using court decrees description for parcels labeled as tax J.D. numbers 17-092-0005, 17-092-0007 and 17-092-0010. The court decreed description, (0010) refers to the Westerly line of property on the 1/4, 1/4 sec. line, computes 1320 ft. West of 1/4 section, this was used as the West line of this Survey.

**LEGEND**

- o Set 3/4" x 24" re-bar with plastic cap stamped L. Buttars R.L.S. 2596
- 5/8" P.K. nail with ribbon

RECEIVED

APR 08 1992

Weber County Surveyor

**BUTTARS SURVEYING**  
 1815 26<sup>TH</sup> STREET OGDEN, UT. 84401  
 PHONE 392-5291

CLIENT: BAPTIST CHURCH

SURVEY LOCATION:  
 S.W. 1/4 SEC. 36, T.8N., R.1W., S.L.M.  
 WEBER COUNTY, UTAH

SURVEY DATE: 3-14-92