


**SURVEYORS CERTIFICATE**

I, Larry M. Buttars, a registered Land Surveyor in the State of Utah, holding license No. 2596, hereby certify that I have caused a Survey to be made under my direction, on the within described property, and this plat is a true and correct representation of said Survey.

*Larry M. Buttars*

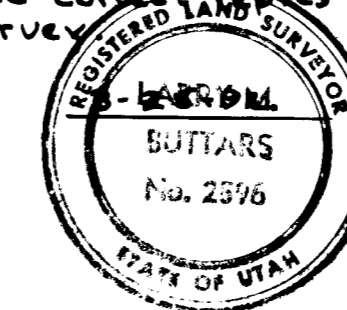

**DESCRIPTION**

Part of Lot 19, Liberty Meadows Subdivision, Weber County, Utah described as beginning at a point N. 5° 26' 33" E. 144.60 ft. from the South-east corner of lot 19, thence N. 71° 29' 06" W. 261.29 ft., thence N. 21° 25' 21" E. 382.09 ft., thence N. 89° 58' E. 150.00 ft. thence S. 5° 26' 33" W. 440.74 ft. to the point of beginning. Cont. 1.90 Ac.

**NARRATIVE**

The purpose of this Survey was to establish property corners for lot improvements.

Basis of Bearings: Platted Subdivision, bearings of record, and Subdivision corners found in place.

**LEGEND**

- Set 3/4" x 24" re-bar with plastic cap stamped L. Buttars R.L.S. 2596
- Set P.K. nail with ribbon

RECEIVED

APR 08 1992

Weber County Surveyor

**BUTTARS SURVEYING**  
 1815 26<sup>TH</sup> STREET OGDEN, UT. 84401  
 PHONE 392-5221

CLIENT: JOHN C. MCKAY

SURVEY LOCATION:  
 LIBERTY MEADOWS SUBDIV., WEBER CO.  
 S.E. 1/4 SEC. 20, T.1N., R.1E.

SURVEY DATE: 3-21-92