

Non-patent utility lines and other features shown on this plan are shown as indicated. The location of the centerline of the street is shown as indicated.

Mon. not pat. utility lines and other features shown on this plan are shown as indicated. The location of the centerline of the street is shown as indicated.

N89 34 48 W 2718.86' per WCS
2718.86'

N89 34 48 W 2718.86' per WCS
2718.86'


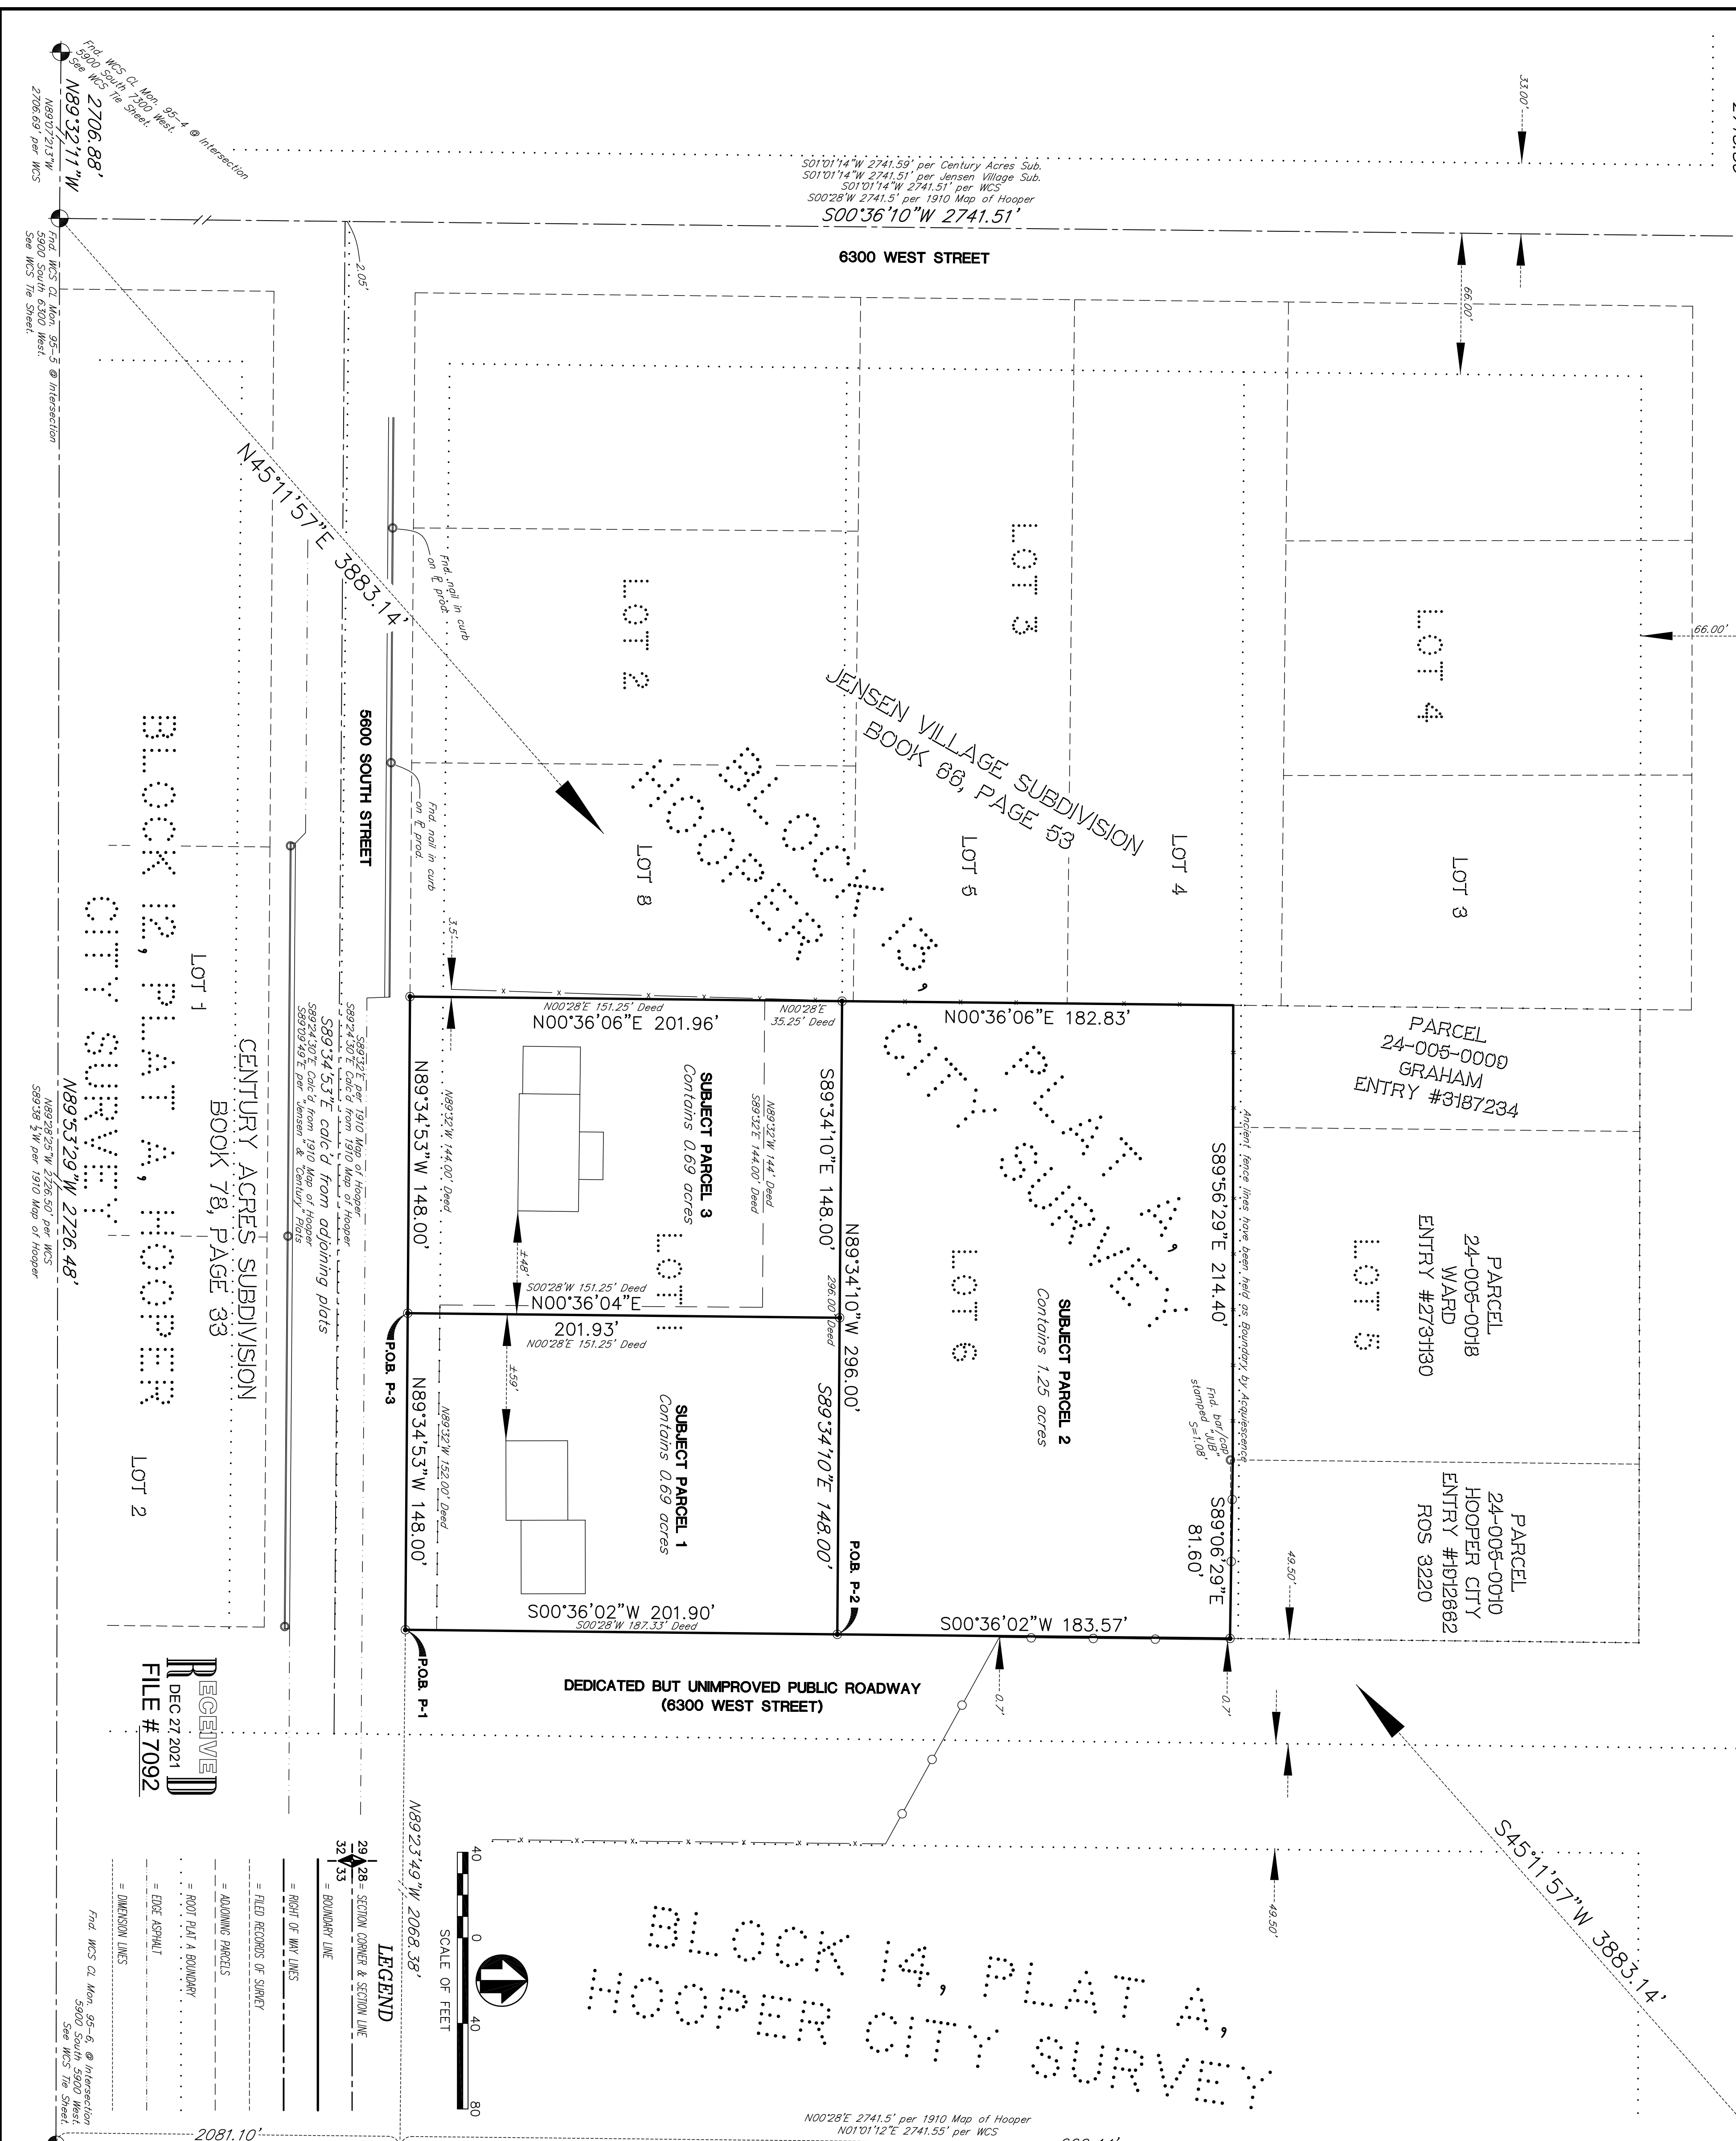

ADJUSTED DESCRIPTIONS:

SUBJECT PARCEL 1:

ADJUSTED DESCRIPTIONS:

SUBJECT PARCEL 1 AND 2, QUIT CLAIM DEED ENTRY #2610892:

EXPLANATORY DESCRIPTIONS:

SUBJECT PARCELS 1 AND 2, QUIT CLAIM DEED ENTRY #2610892:


SUBJECT PARCEL 1:

SUBJECT PARCEL 2:

SUBJECT PARCEL 3:

SUBJECT PARCEL 1:

DESIGNED	DEH	<p>Boundary Consultants Professional Land Surveyors</p> <p>5554 West 2425 North, Hooper, Utah 801-792-1569 dave@boundaryconsultants.biz</p>	DATE:	12-27-21
DRAFTED	DEH		PLOT DATE:	
CHECKED	DEH		SCALE:	1" = 40'
DRAWN	DEH		PROJECT NUMBER:	2176001

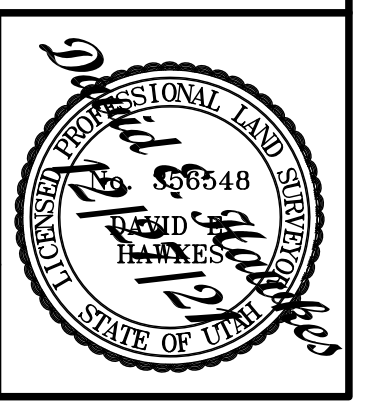

SHEET	DESIGNED	1
	DRAFTED	1
	CHECKED	1

RECORD OF SURVEY AND PARCEL ADJUSTMENT
TAX PARCELS 24-005-0007, -0011, -0013
ELAINE J. FOWERS TRUST
PART OF LOT 1, BLOCK 13, PLAT A, HOOPER CITY SURVEY
LYING AND SITUATE IN THE SOUTHEAST QUARTER OF SECTION 13,
TOWNSHIP 5 NORTH, RANGE 3 WEST, SALT LAKE BASE AND MERIDIAN