

## BOUNDARY DESCRIPTION PARCEL NUMBER 140840001

STARTING AT THE CENTERLINE MONUMENT ON BEVERLY DRIVE RUNNING SOUTH 84°25'15" EAST 322.77 FEET THENCE; SOUTH 88°54'04" EAST 14 FEET THENCE; SOUTH 0°42'49" WEST 105.23 FEET THENCE; NORTH 67°42'55" WEST 15.05 FEET; THENCE NORTH 0°42'49" EAST 99.79 FEET TO POINT OF BEGINNING.

# PARCEL NUMBER 140940003

A PART OF THE SOUTHEAST QUARTER OF SECTION 27, TOWNSHIP 7 NORTH, RANGE 1 EAST, OF THE SALT LAKE BASE AND MERIDIAN. BEGINNING AT THE CENTERLINE MONUMENT ON BEVERLY DRIVE RUNNING SOUTH 84°25'15" EAST 322.77 FEET THENCE; SOUTH 0°41'03" 57.69 WEST FEET THENCE; SOUTH 0°42'32" WEST 42.09 FEET THENCE; NORTH 67°42'55" WEST 12.87 FEET THENCE; NORTH 0°39'51" EAST 37.65 FEET THENCE; SOUTH 87°55'16" EAST 12.00 FEET TO POINT OF BEGINNING

#### PARCEL NUMBER 140940019

A PART OF THE SOUTHEAST QUARTER OF SECTION 27, TOWNSHIP 7 NORTH, RANGE 1 EAST, OF THE SALT LAKE BASE AND MERIDIAN. BEGINNING AT THE CENTERLINE MONUMENT ON BEVERLY DRIVE RUNNING SOUTH 84°25'15" EAST 322.77 FEET THENCE; SOUTH 88°54'04" EAST 43.04 FEET THENCE; NORTH 0°43'45" EAST 14.50 FEET THENCE; SOUTH 88°54'04" EAST 66.80 FEET THENCE; NORTH 0°43'45" EAST 134.00 FEET THENCE; SOUTH 88°54'04" EAST 279.50 FEET THENCE; SOUTH 1°18'01" WEST 148.50 FEET THENCE; NORTH 88°54'03" WEST 344.82 FEET TO THE POINT OF BEGINNING

#### PARCEL NUMBER 140940017

A PART OF THE SOUTHEAST QUARTER OF SECTION 27, TOWNSHIP 7 NORTH, RANGE 1 EAST, OF THE SALT LAKE BASE AND MERIDIAN. BEGINNING AT THE CENTERLINE MONUMENT ON BEVERLY DRIVE RUNNING SOUTH 84°25'15" EAST 322.77 FEET THENCE; SOUTH 88°54'04" EAST 14.00 FEET THENCE; SOUTH 88°54'04" EAST 72.86 FEET THENCE; SOUTH 88°54'03" EAST 301.30 FEET THENCE; SOUTH 1°18'23" WEST 101.37 FEET THENCE; SOUTH 17°07'57" EAST 30.01 FEET THENCE; SOUTH 88°01'02" WEST 132.66 FEET THENCE; SOUTH 67°35'53" WEST 27.55 FEET THENCE; NORTH 55°40'28" WEST 65.45 FEET THENCE; NORTH 40°00'28" WEST 148.81 FEET TO THE POINT OF BEGINNING

### PARCEL NUMBER 140940010


A PART OF THE SOUTHEAST QUARTER OF SECTION 27, TOWNSHIP 7 NORTH, RANGE 1 EAST, OF THE SALT LAKE BASE AND MERIDIAN. BEGINNING AT THE CENTERLINE MONUMENT ON BEVERLY DRIVE RUNNING SOUTH 84°25'15" EAST 322.77 FEET THENCE; SOUTH 88°54'04" EAST 14.00 FEET THENCE; SOUTH 88°54'04" EAST 72.86 FEET THENCE; SOUTH 88°54'03" EAST 301.30 FEET THENCE; SOUTH 1°18'23" WEST 101.37 FEET THENCE; SOUTH 17°07'57" EAST 30.01 FEET THENCE; SOUTH 17°03'52" EAST 280.25 FEET THENCE; NORTH 88°40'21" WEST 64.83 FEET THENCE; NORTH 62°51'21" WEST 225.08 FEET THENCE; NORTH 38°20'21" WEST 135.05 FEET THENCE NORTH 66°36'51" EAST 51.41 FEET THENCE; SOUTH 71°42'21" EAST 30.71 FEET THENCE; NORTH 53°40'12" EAST 71.64 FEET THENCE; NORTH 88°01'02" EAST 132.66 FEET TO THE POINT OF BEGINNING

#### PARCEL NUMBER 140940018

A PART OF THE SOUTHEAST QUARTER OF SECTION 27, TOWNSHIP 7 NORTH, RANGE 1 EAST, OF THE SALT LAKE BASE AND MERIDIAN. BEGINNING AT THE CENTERLINE MONUMENT ON BEVERLY DRIVE RUNNING SOUTH 67°41'56" EAST 333.00 FEET THENCE; SOUTH 67°42'55" EAST 98.75 FEET THENCE; SOUTH 38°20'21" EAST 148.14 FEET THENCE; NORTH 88°40'21" WEST 144.82 FEET THENCE; NORTH 1°49'51" EAST 56.69 FEET THENCE; NORTH 8°07'40" WEST 18.69 FEET THENCE; NORTH 64°38'02" WEST 11.66 FEET THENCE; NORTH 86°57'25" WEST 28.04 FEET THENCE; NORTH 0°44'26" EAST 68.64 FEET TO THE POINT OF BEGINNING.

## PARCEL NUMBER 140940008

A PART OF THE SOUTHEAST QUARTER OF SECTION 27, TOWNSHIP 7 NORTH, RANGE 1 EAST, OF THE SALT LAKE BASE AND MERIDIAN. BEGINNING AT THE CENTERLINE MONUMENT ON BEVERLY DRIVE RUNNING SOUTH 84°25'15" EAST 322.77 FEET THENCE; SOUTH 88°54'04" EAST 14 FEET THENCE; SOUTH 88°54'04" EAST 14 FEET THENCE; SOUTH 88°54'04" EAST 65.45 FEET THENCE; SOUTH 40°00'28" EAST 148.81 FEET THENCE; SOUTH 55°40'28" EAST 65.45 FEET THENCE; NORTH 67°35'53" EAST 27.55 FEET THENCE; SOUTH 53°40'12" WEST 71.64 FEET THENCE; NORTH 71°42'21" WEST 30.71 FEET THENCE; SOUTH 66°36'51" WEST 51.41 FEET THENCE; NORTH 38°20'21" WEST 80.22 FEET THENCE; NORTH 67°42'55" WEST 70.82 FEET THENCE; NORTH 0°42'49" EAST 105.23 FEET TO THE POINT OF BEGINNING.

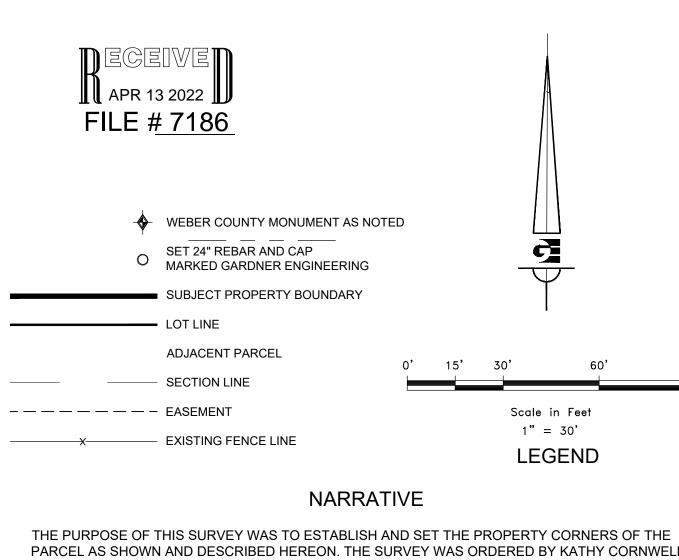

PARCEL AS SHOWN AND DESCRIBED HEREON. THE SURVEY WAS ORDERED BY KATHY CORNWELL. THE BASIS OF BEARING IS THE CENTERLINE OF BEVERLY DRIVE, WHICH BEARS SOUTH 58°41'34" EAST, WEBER COUNTY, UTAH NORTH, NAD 83 STATE PLANE GRID BEARING. THE BOUNDARY WAS DETERMINED BUY WARRANTY DEED RECORDED AS ENTRY NUMBER 3091979, 2685576, BLA 2876760, AND DEEDS OF ADJOINING PROPERTY OWNERS. RECORD OF SURVEY NUMBERS 07-065, 09-009, 2743 WERE ALSO USED TO DETERMINE BOUNDARY LOCATION ALONG WITH THE FOUND MONUMENTS AS SHOWN AND DESCRIBED HEREON.

#### SURVEYOR'S CERTIFICATE

I, KLINT H. WHITNEY, DO HEREBY CERTIFY THAT I AM A LICENSED PROFESSIONAL LAND SURVEYOR IN THE STATE OF UTAH AND THAT I HOLD CERTIFICATE NO. 8227228 IN ACCORDANCE WITH TITLE 58, CHAPTER 22, OF THE PROFESSIONAL ENGINEERS AND LAND SURVEYORS ACT; I FURTHER CERTIFY THAT BY AUTHORITY OF THE OWNERS I HAVE COMPLETED A SURVEY OF THE PROPERTY DESCRIBED ON THIS RECORD OF SURVEY PLAT IN ACCORDANCE WITH SECTION 17-23-20 AND HAVE VERIFIED ALL MEASUREMENTS; THAT THE REFERENCE MONUMENTS SHOWN ON THIS RECORD OF SURVEY PLAT ARE LOCATED AS INDICATED AND ARE SUFFICIENT TO RETRACE OR REESTABLISH THIS SURVEY; AND THAT THE INFORMATION SHOWN HEREIN IS SUFFICIENT TO ACCURATELY ESTABLISH THE LATERAL BOUNDARIES OF THE HEREIN DESCRIBED TRACT OF REAL PROPERTY.

2	DAY OF	APRIL	, 2022.	ANNIHILLI III
2	_ DAT OF		, 2022.	TAL LAND STATE
				DATE
				Klint H. S
			1/1	10 John TEhren Star
			KLINT H. WI	HITNEY, PLS NO. 8227228

		•					
			PROPERTY SURVEY FOR KATHY CORNWELL		REVISIONS	SCALE: 1:30_XREF	
	S			DATE	DESCRIPTION	DATE: 4/12/22	
	1		BEVERLY DRIVE, OGDEN, UTAH			DESIGN:	
			I OCATED IN THE NORTHEAST OUARTER OF SECTION 34			DRAWN: KHW	
1		MINICIPAL - LAND FLANNING				CHECKED: KHW	
		5150 SOUTH 375 EAST OGDEN, UT	I OWNSHIP 6 NOKIH, KANGE 1 WESI, S.L.B. AND M.		DWG · R:2601 - MISC SURVEY:240 - KATHY CORNWELL BEVERLY DRIVE/SURVEY/DWG/BEVERLY DRIVE.DWG	LY DRIVE/SURVEYDWG/BEVERLY DRIVE.DWG	
		OFFICE: 801.476.0202 FAX: 801.476.0066					