


- LEGEND**
- ⊕ EXISTING WEBER COUNTY SURVEYORS BRASS CAP.
 - ⊙ SECTION CORNER PER PLAT, NO MONUMENT IN PLACE.
 - EXISTING FENCE.
 - SET 5/8" REBAR W/CBL'S CAP.

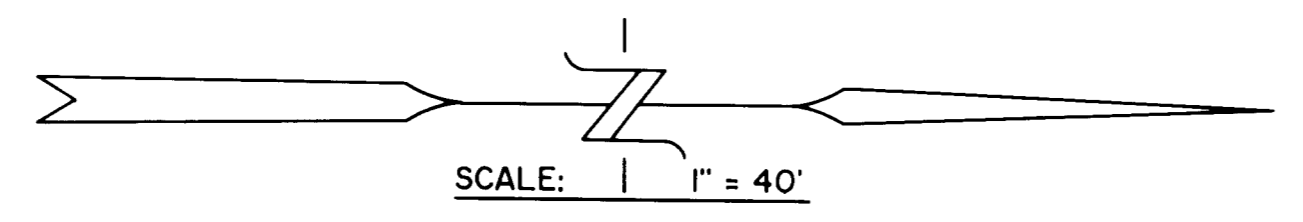

WEST 1/4 CORN. SEC. 16,
T. 6 N., R. 2 E., S. 18 BM,
WEBER COUNTY SURVEYORS
BRASS CAP.

3720.61
BASIS OF BEARING S. 43° 16' 14" W.

NORTH 1/4 CORN. SEC. 16,
T. 6 N., R. 2 E., S. 18 BM,
WEBER COUNTY SURVEYORS
BRASS CAP.


STATE
STATE R.O.-W MON
V. 81° 49' 03" W.

S. 89° 22' 00" E. 2955.30' PLAT


N.E. CORN. SEC. 16,
T. 6 N., R. 2 E., S. 18 BM,
PER PLAT BOOK 6, PAGE 64.

WEBER COUNTY SURVEYORS BRASS CAP
REPRESENTING N. E. CORN.


HIGHWAY
U-39
S. 81° 47' 00" E. 444.35'

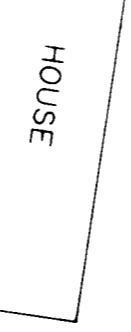

HOUSE

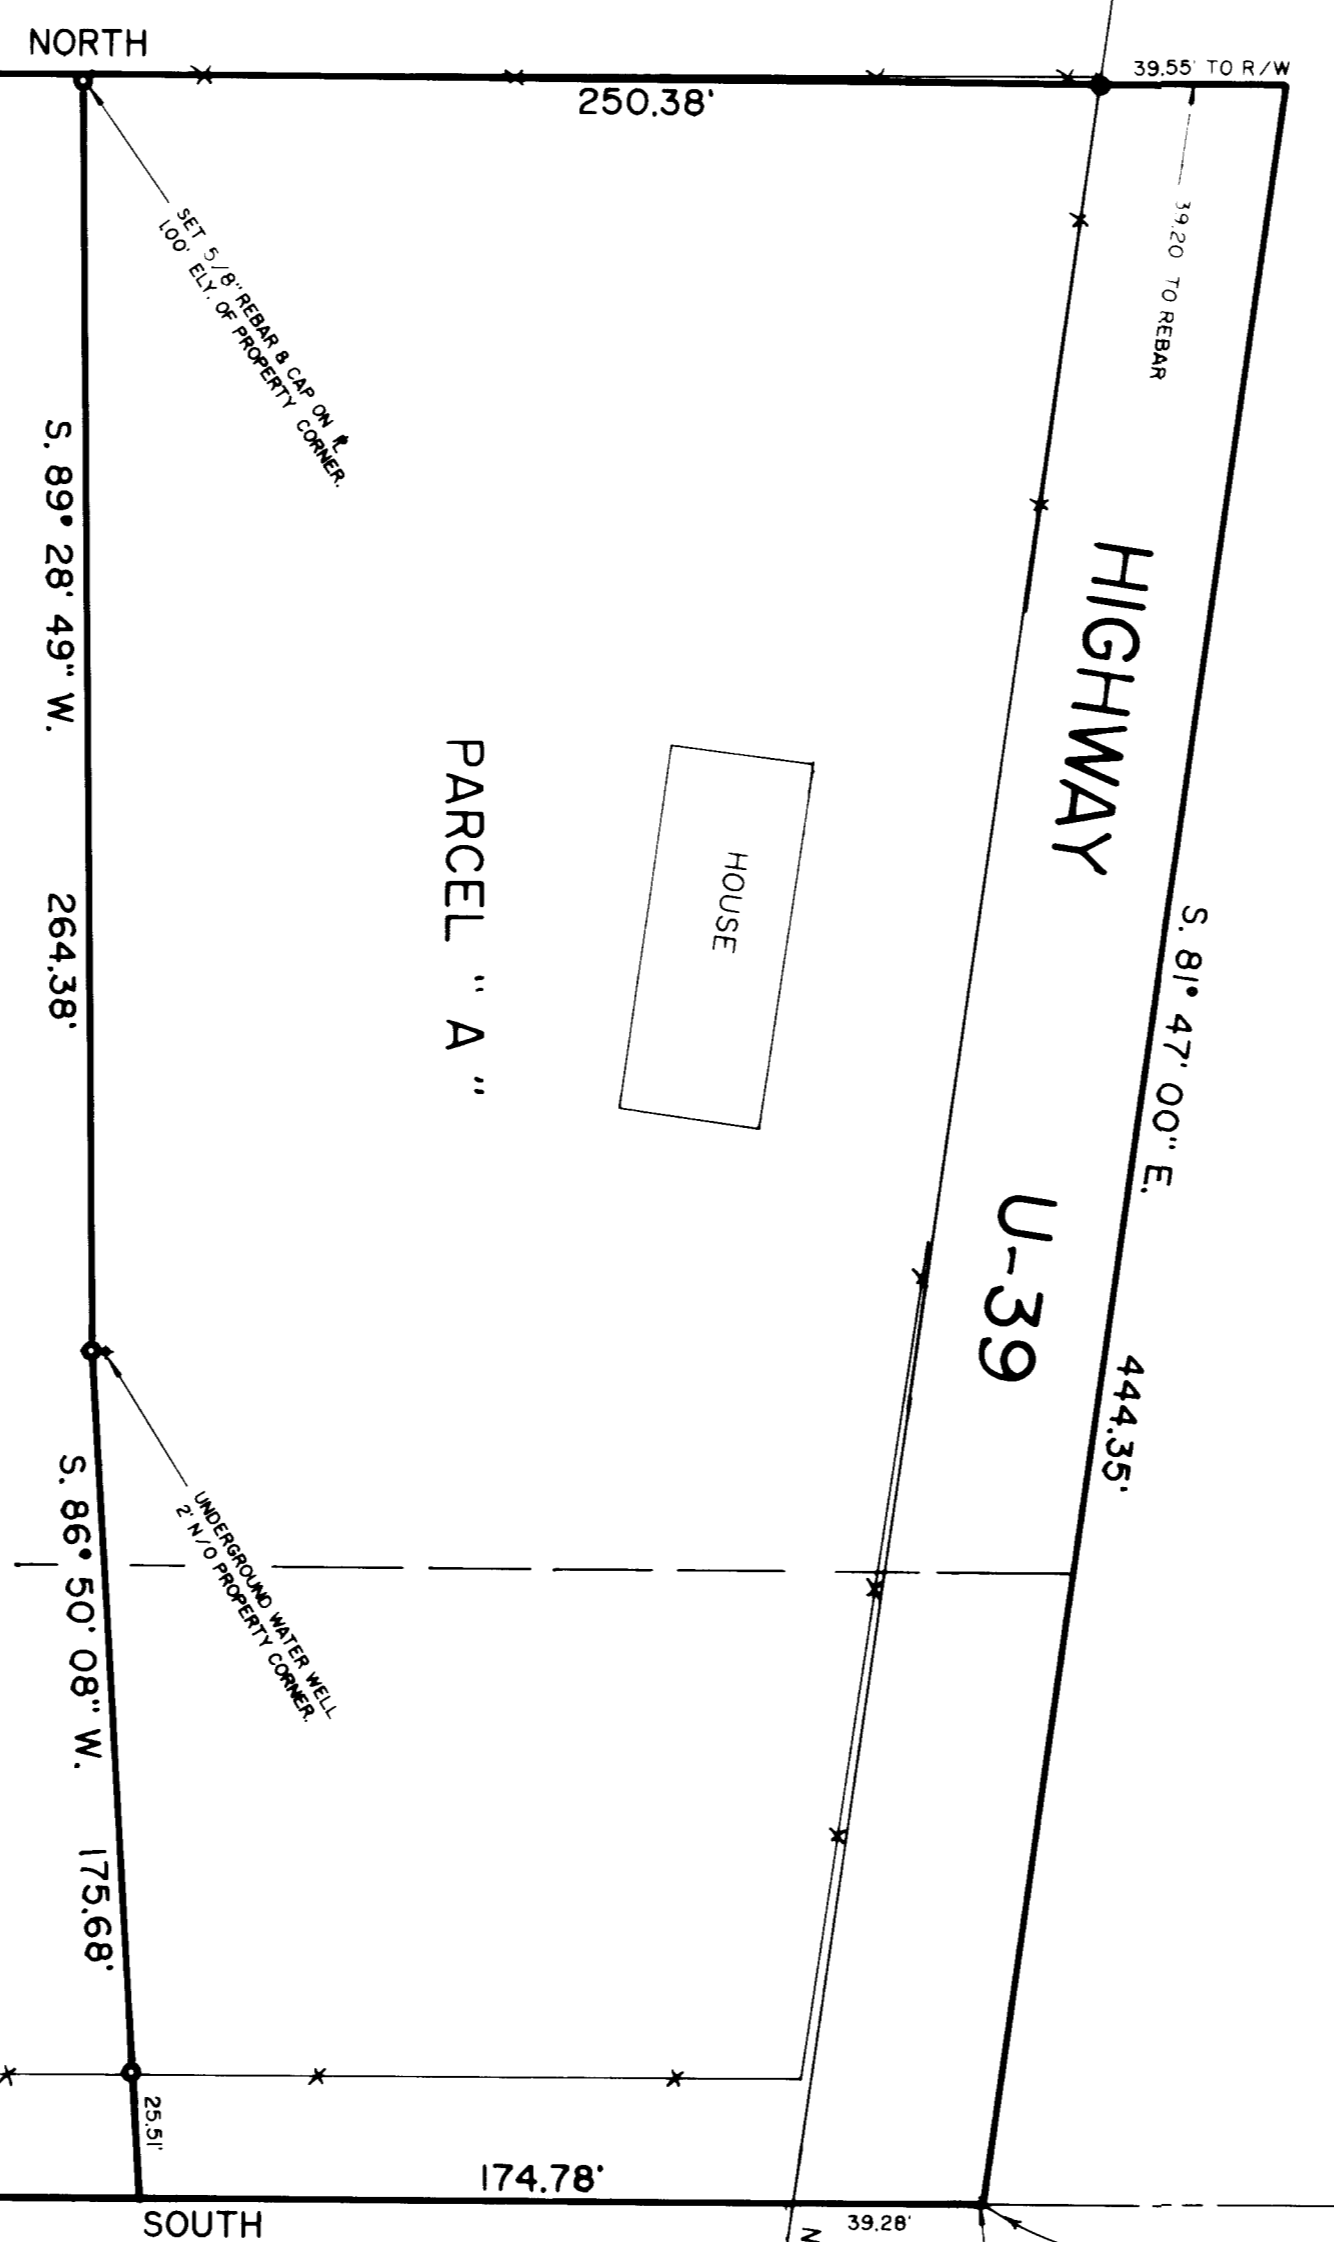

143.72' 250.38' 39.55' TO R.W.
S. 89° 28' 49" W. 264.36' S. 81° 47' 00" E. 444.35'
S. 89° 28' 49" W. 439.81' S. 86° 50' 08" W. 175.68'
143.64' DEED 140' 151.82' 174.78' SOUTH 1152.00'

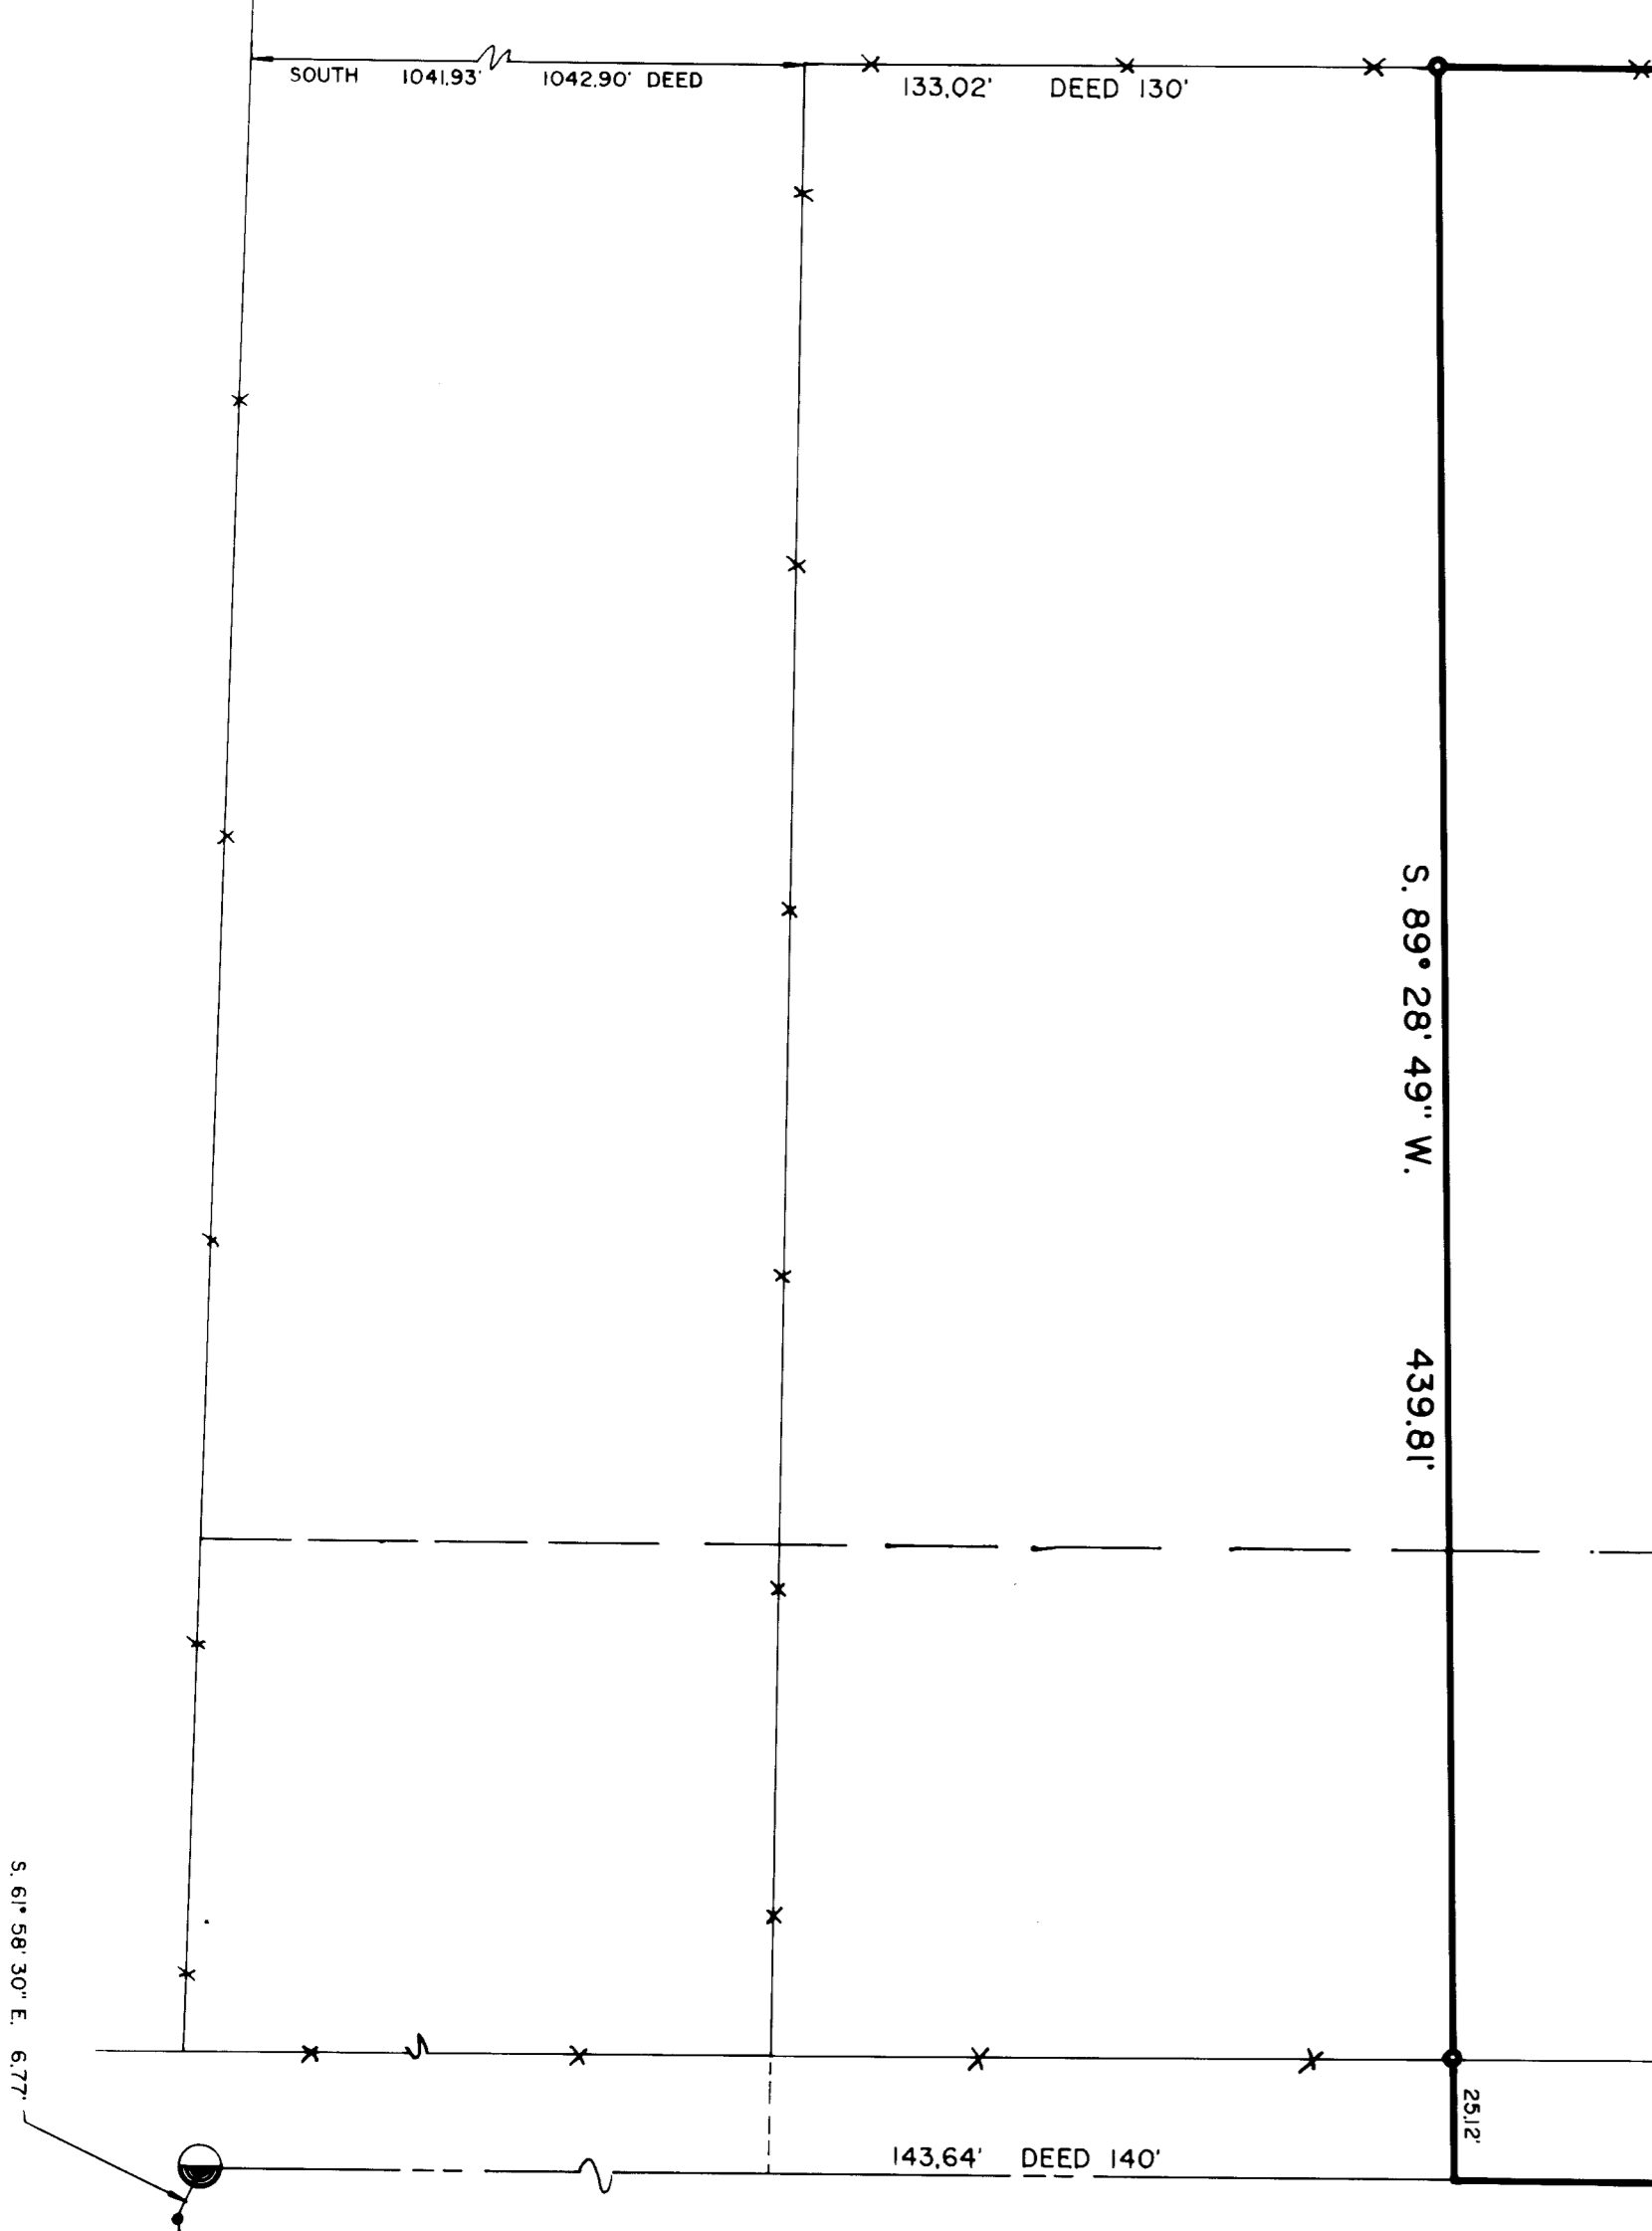

WEST 1/4 CORN. SEC. 16,
T. 6 N., R. 2 E., S. 18 BM,
PER PLAT BOOK 6, PAGE 64.
R. R. 3RD. REPRESENTING E. 1/4 CORN.

BOUNDARY DESCRIPTIONS


PARCEL "A"




SURVEYOR'S CERTIFICATE


CHESTER L. NELSON
DATE 7/24/92

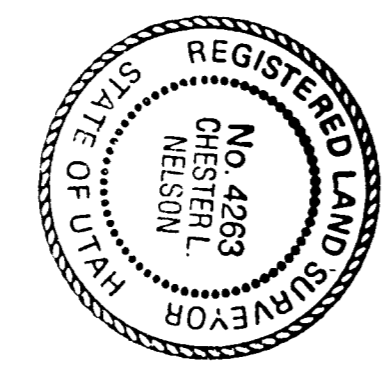

NARRATIVE



RECEIVED
JUL 17 1992
Webber County Surveyor

JOB NO. P-8392-04			