



5900 WEST STREET

BASIS OF BEARING N. 0° 42' 55" E. (NORTH) 2640.14'

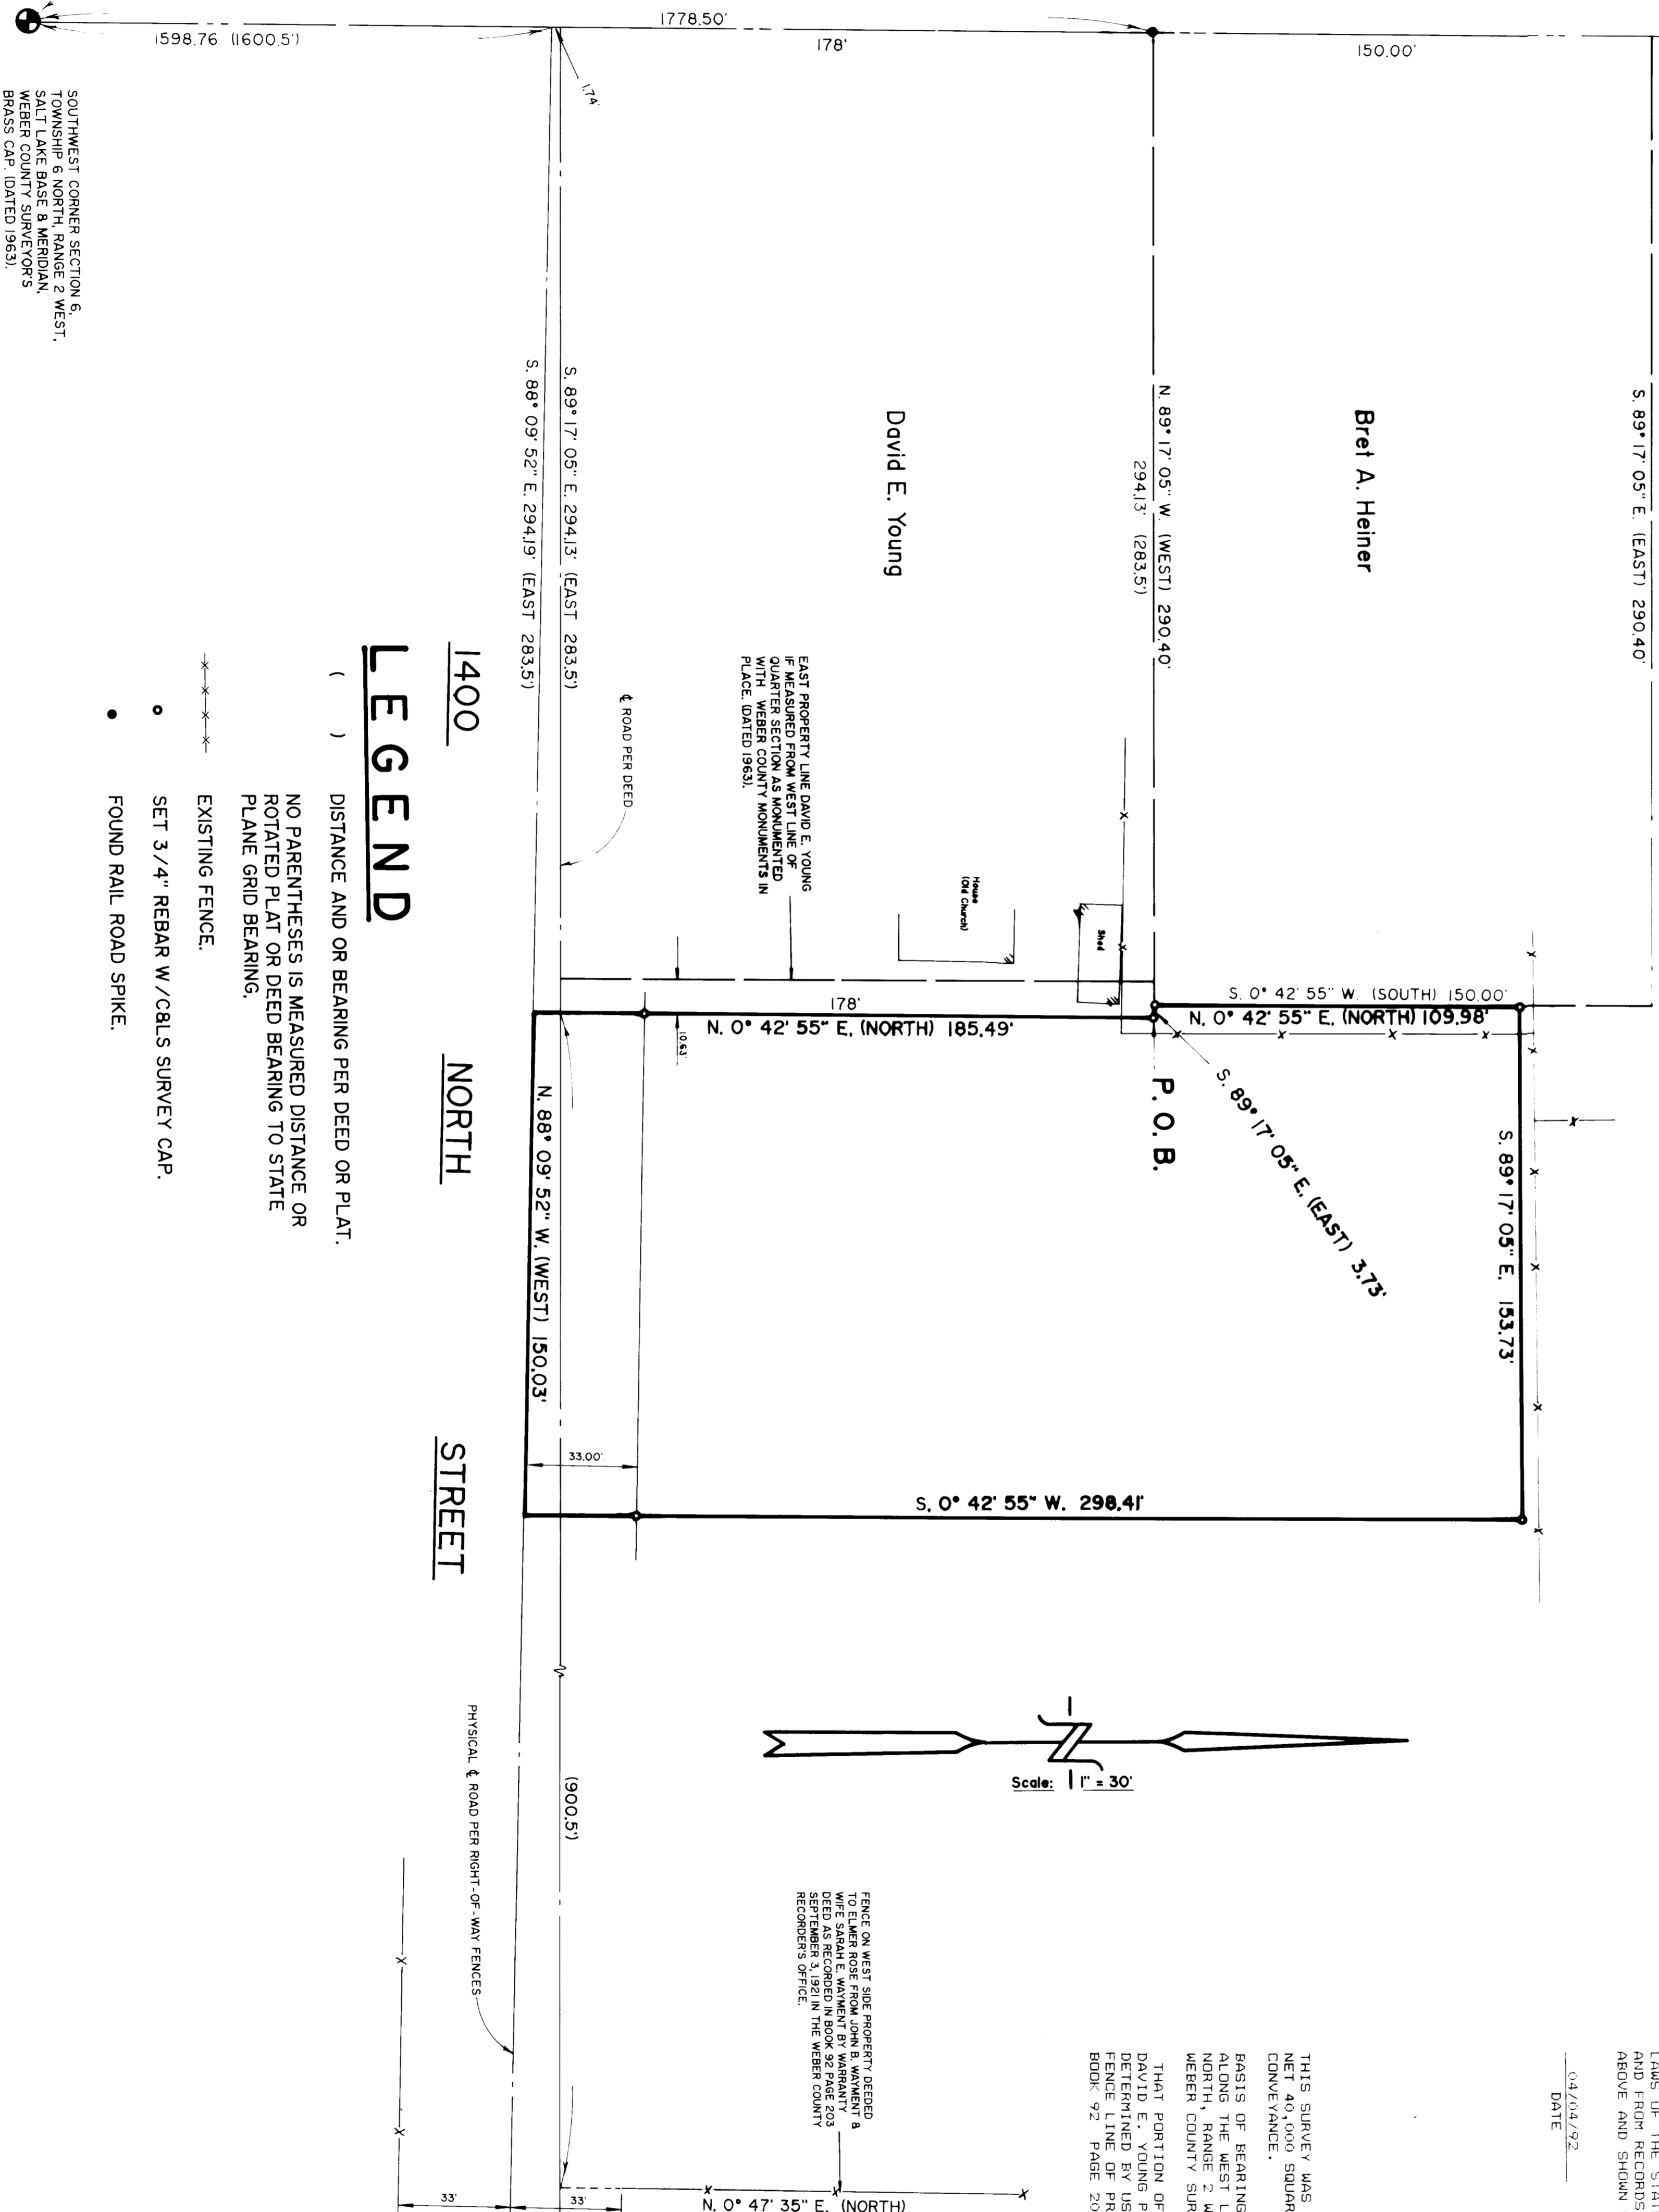

LEGEND

- () DISTANCE AND OR BEARING PER DEED OR PLAT.
- NO PARENTHESES IS MEASURED DISTANCE OR ROTATED PLAT OR DEED BEARING TO STATE PLANE GRID BEARING.
- EXISTING FENCE.
- SET 3/4" REBAR W/CALS SURVEY CAP.
- FOUND RAIL ROAD SPIKE.

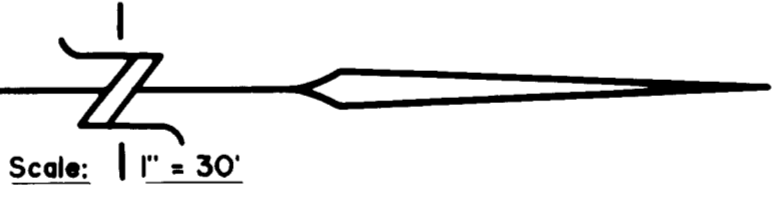

BOUNDARY DESCRIPTION

A PART OF THE SOUTHWEST QUARTER OF SECTION 6, TOWNSHIP 6 NORTH, RANGE 2 WEST, SALT LAKE BASE AND MERIDIAN BEGINNING ON A POINT THAT BEARS 2° WEST, 171.00 FEET FROM THE SOUTHWEST CORNER OF THE SOUTHWEST QUARTER SECTION AS MONUMENTED BY WEBER COUNTY SURVEYOR S. MONMETS AND 5.99° 17' 05" E. (EAST) 294.13 FEET FROM THE SOUTHWEST CORNER OF THE SAID QUARTER SECTION AND PROCEEDING THENCE N. 89° 17' 05" W. 272.99 FEET, 155.00 FEET, THENCE S. 0° 42' 55" W. 298.41 FEET (287.99 FEET) MORE OR LESS TO THE CENTER OF 1400 NORTH STREET, THENCE N. 89° 09' 52" W. 150.00 FEET (WEST 150.00 FEET) OF POINT OF BEGINNING, THENCE N. 0° 42' 55" E. 189.49 FEET (NORTH 178.00 FEET) MORE OR LESS TO POINT OF BEGINNING.

SURVEYOR'S CERTIFICATE

I, CHESTER L. NELSON DO HEREBY CERTIFY THAT I AM A REGISTERED LAND SURVEYOR IN THE STATE OF UTAH, AND THAT I HAVE MADE A SURVEY OF THE GROUND ABOVE AND SHOWN PER THIS PLAT.

04/04/92

CHESTER L. NELSON



NARRATIVE

THIS SURVEY WAS DONE FOR THE PURPOSE OF MARKING THE BOUNDARIES OF A NET 40,000 SQUARE FOOT PARCEL FOR EDWARD J. WARMENT FOR THE PURPOSE OF CONVEYANCE.

BASIS OF BEARING IS STATE PLANE GRID BEARING OF N. 0° 42' 55" E. ALONG THE WEST LINE OF THE SOUTHWEST QUARTER OF SECTION 6, TOWNSHIP 6 NORTH, RANGE 2 WEST, SALT LAKE BASE & MERIDIAN, AS MONUMENTED WITH WEBER COUNTY SURVEYOR S. BRASS CAPS.



RECEIVED
JUL 17 1992
Weber County Surveyor

CONSTRUCTION & LAND SURVEYORS, INC.
2781 WASHINGTON BLVD.
(801) 399-4400

CLIENT: EDWARD J. WARMENT

SURVEY LOCATION:
S.W. 1/4 SECTION 6,
TOWNSHIP 6 NORTH, RANGE 2 WEST,
SALT LAKE BASE & MERIDIAN.

SURVEY DATE: 03-23-92

JOB NO. P.S.92-11