

- LEGEND**
- Subject Property Line
 - Adjoining Property Line
 - Centerline
 - Fence Line
 - Existing Concrete
 - Existing Asphalt
 - Found Survey Marker Set by HAI
 - Set 5/8"x24" Rebar With Cap
 - Section Corner

RECEIVED
 MAY 18 2022
 BY: 7243


NARRATIVE

The purpose of this survey was to adjust, establish and set the property corners of the parcels as shown and described hereon. The survey was ordered by Megan Monk. The control used to establish the property corners was ROS# 5859 along with the existing Weber County Survey Monumentation surrounding Section 14, T5N, R2W, SLB&M.
 The basis of bearing is the East line of the Southeast Quarter of said Section which bears South 0°16'39" West, Utah North, State Plane, Calculated N.A.D.83 Bearing.

SURVEYOR'S CERTIFICATE

I, Roger C. Slade, do hereby certify that I am a Registered Professional Land Surveyor in the State of Utah in accordance with Title 58, Chapter 22, Professional Engineers and Professional Land Surveyors Act; and by the authority of the owners, I have completed a survey of the property described and shown hereon this plat in accordance with Section 17-23-17 and have verified all measurements, and that the same has been surveyed and monuments have been located and/or Placed on the ground as represented on the plat hereon.

Signed this 5th day of May, 2022.
 Roger C. Slade, PLS
 Utah Land Surveyor Licence No. 11386802

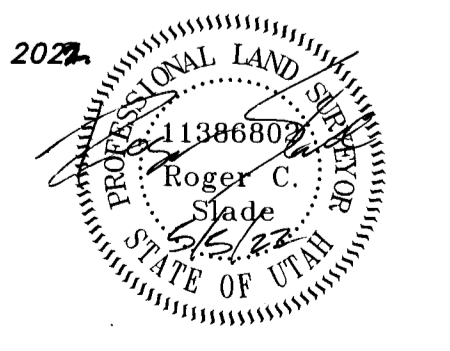

Southeast Corner of Sec. 14, T. 5 N., R. 2 W., SLB&M Found Weber Co. Brass Cap Monument.

BOUNDARY ADJUSTMENT SURVEY FOR
TCT HOLDINGS LLC
 5275 SOUTH 1900 WEST
 ROY, WEBER COUNTY, UTAH
 A PART OF THE SOUTHEAST QUARTER OF SECTION 14
 TOWNSHIP 5 NORTH, RANGE 2 WEST, S.L.B.&M.

Drawn By: RS Date: 10/22/2021
 Designed By: [Blank]
 Checked By: [Blank]
 Approved By: [Blank]
 Scale: 1" = 30'
 Drawing File: 21-3-356/19.dwg
 JOB NUMBER: 21-3-356

HANSEN & ASSOCIATES, INC.
 Consulting Engineers and Land Surveyors
 538 North Main Street, Brigham, Utah 84302
 Visit us at www.hais.net
 Logan Ogden
 (435) 753-3461 (801) 399-9905 (435) 752-8272
 Celebrating over 60 Years of Business

Sheet
1
 of
1
 Sheets