
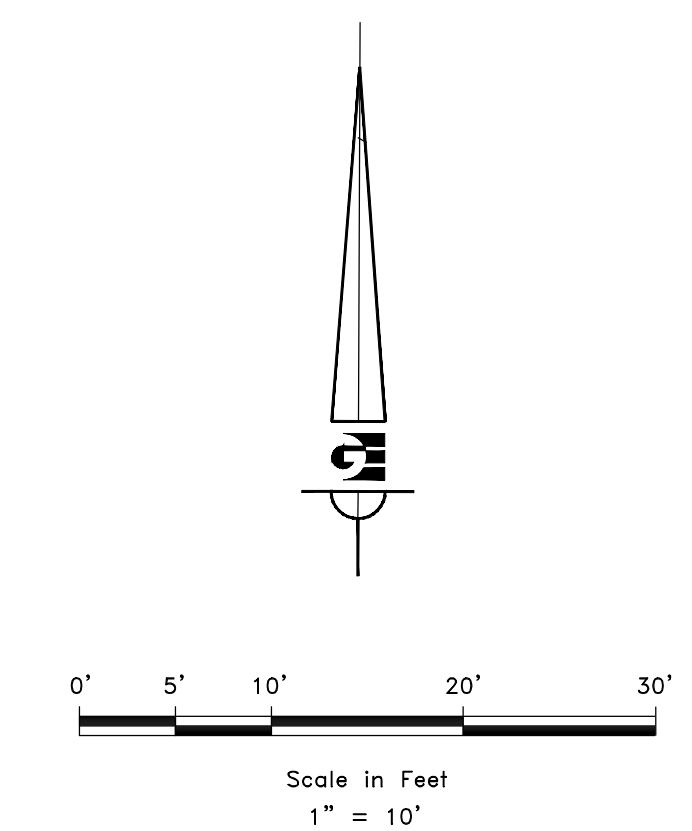


BOUNDARY DESCRIPTION

ALL OF LOT 3, BLOCK 4, ROMNEY ADDITION TO OGDEN CITY, WEBER COUNTY, UTAH.

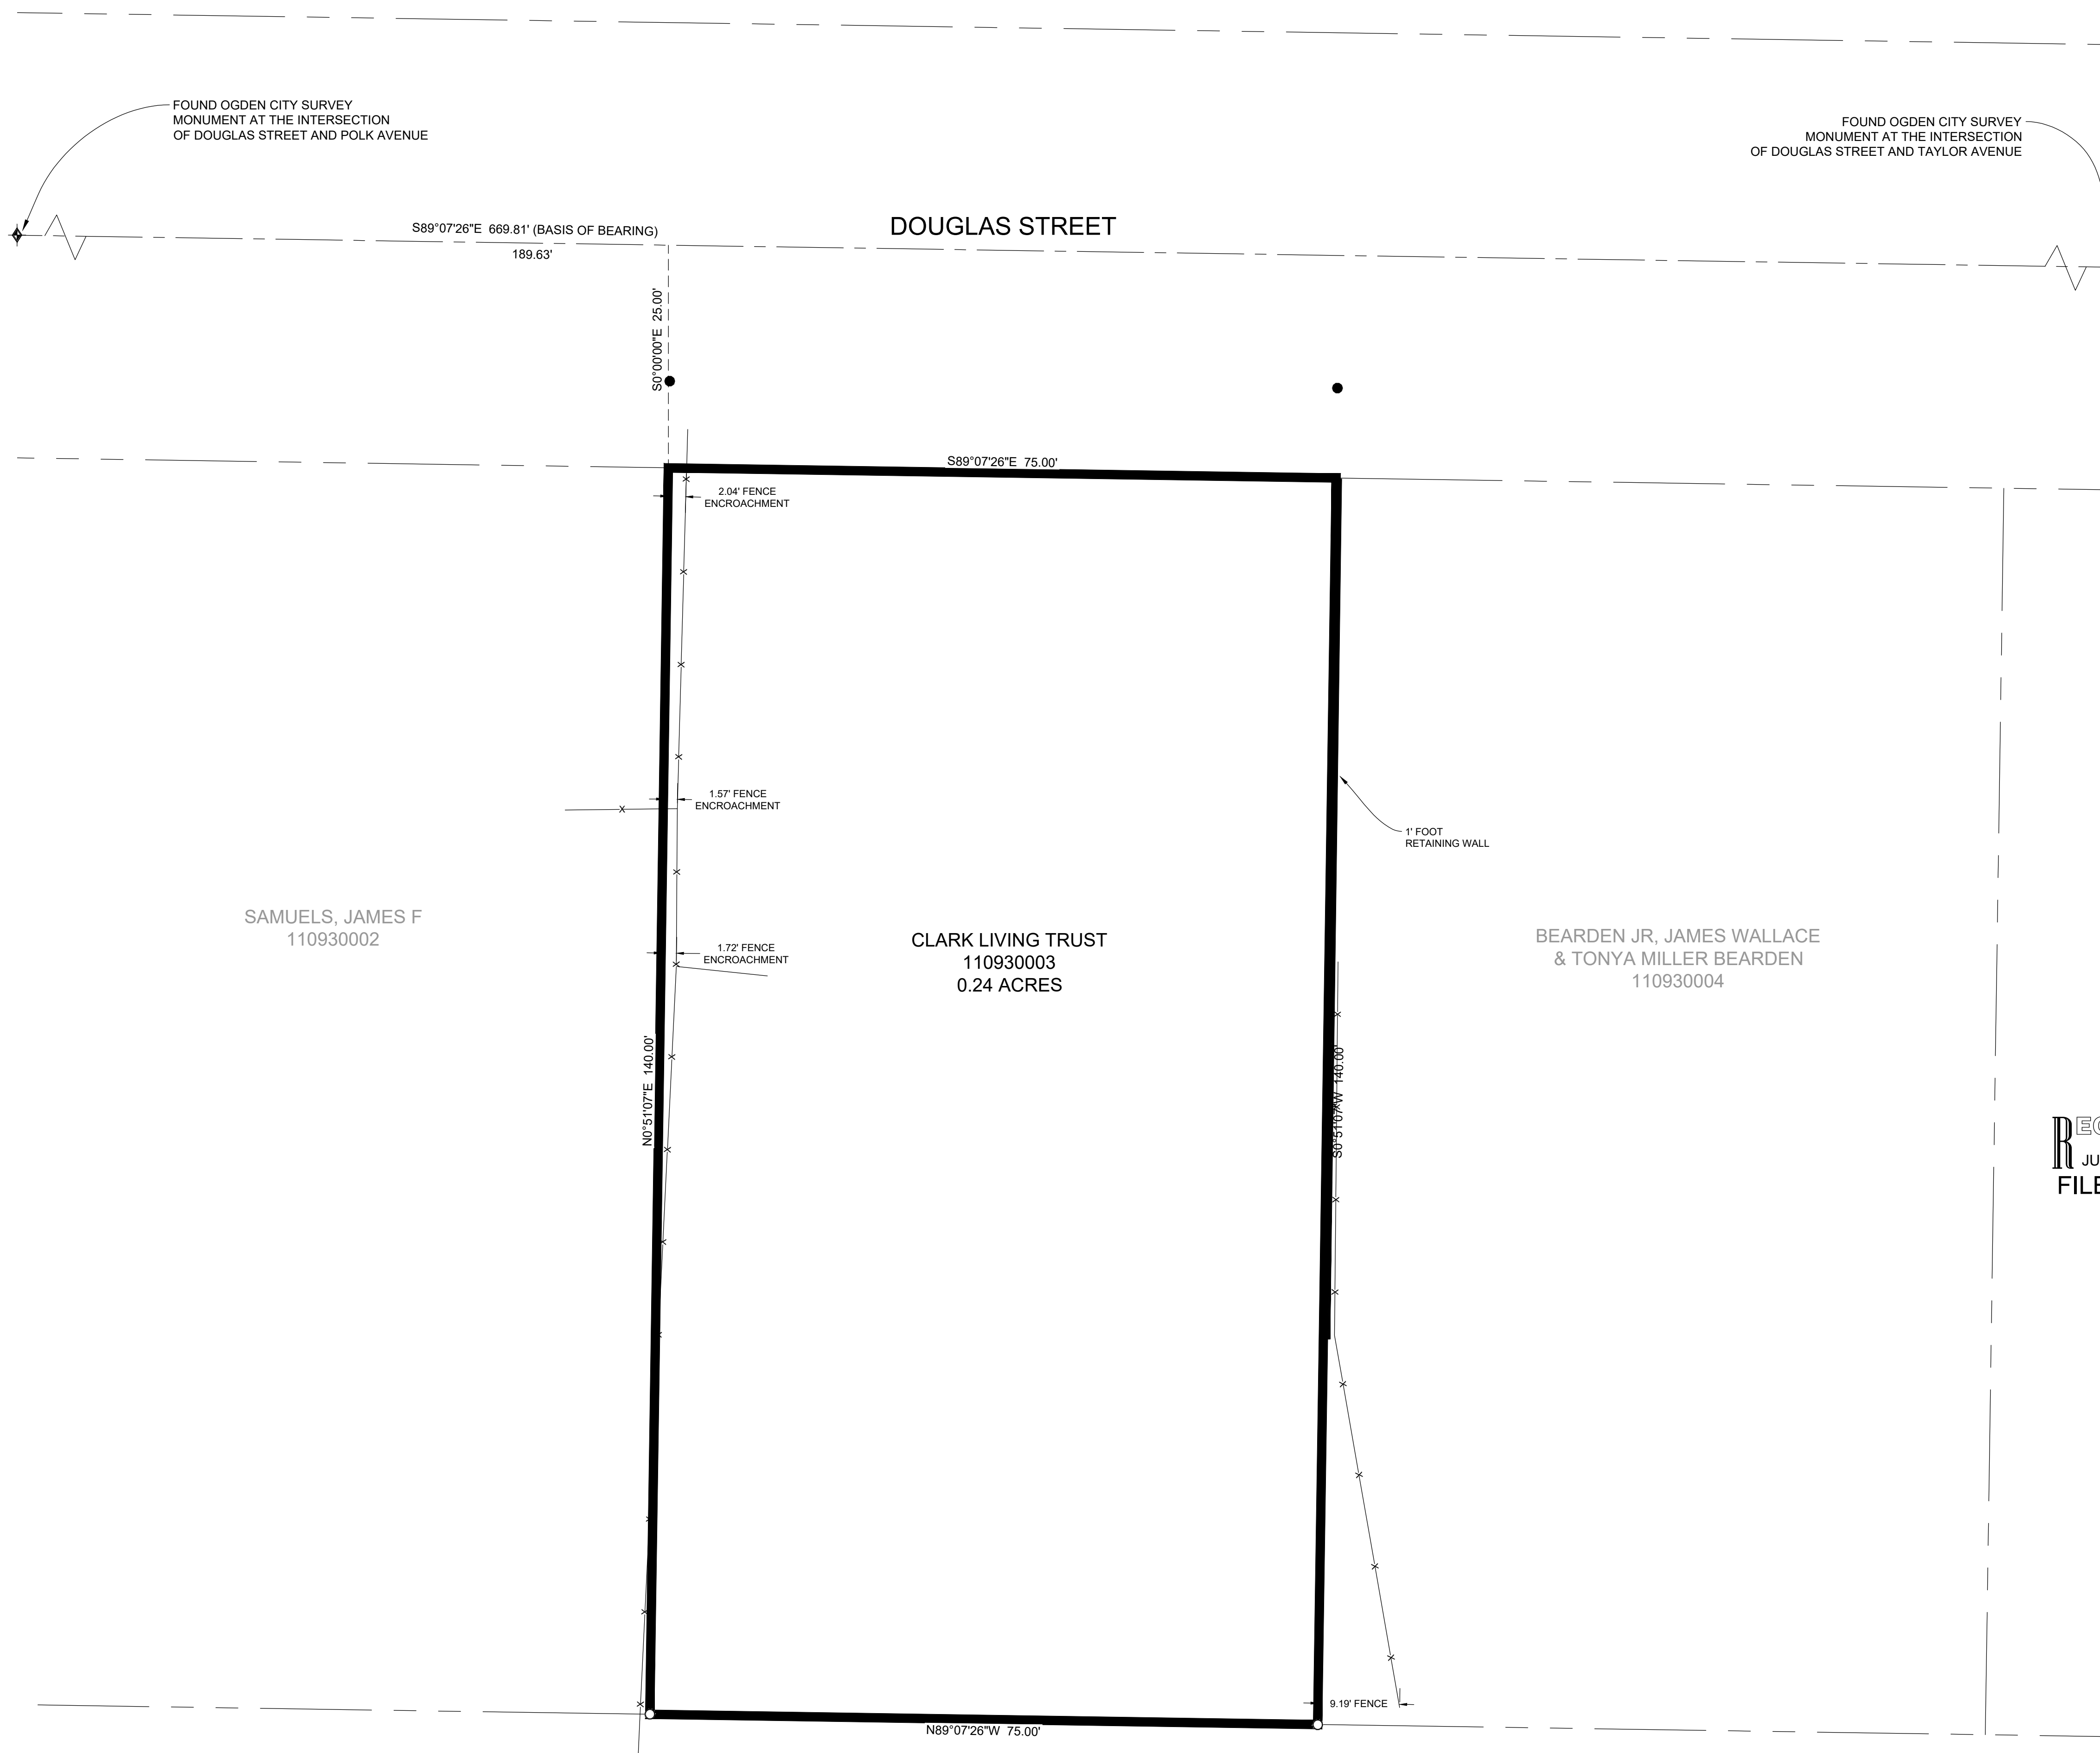

LEGEND

- ◆ OGDEN CITY SURVEY MONUMENT AS NOTED
- SET 24" REBAR AND CAP MARKED GARDNER ENGINEERING
- SET CURB NAIL
- SUBJECT PROPERTY BOUNDARY
- LOT LINE
- - - ADJACENT PARCEL
- - - SECTION LINE
- - - EASEMENT
- x - EXISTING FENCE LINE

RECEIVED
JUL 06 2022
FILE # 7279

NARRATIVE

THE PURPOSE OF THIS SURVEY WAS TO ESTABLISH AND SET THE PROPERTY CORNERS OF THE PARCEL AS SHOWN AND DESCRIBED HEREON. THE SURVEY WAS ORDERED BY ALEX CLARK. THE BASIS OF BEARING IS THE MONUMENTED STREET CENTERLINE OF DOUGLAS STREET BETWEEN POLK AVENUE AND TAYLOR AVENUE, WHICH BEARS SOUTH 89°07'26" EAST, WEBER COUNTY, UTAH NORTH, NAD 83 STATE PLANE GRID BEARING. THE BOUNDARY WAS DETERMINED BY WARRANTY DEED RECORDED AS ENTRY NUMBER 3231480, AND DEEDS OF ADJOINING PROPERTY OWNERS. THE DEDICATED PLAT OF ROMNEY ADDITION WAS ALSO USED TO DETERMINE BOUNDARY LOCATION ALONG WITH THE FOUND MONUMENTS AS SHOWN AND DESCRIBED HEREON.

SURVEYOR'S CERTIFICATE

I, KLINT H. WHITNEY, DO HEREBY CERTIFY THAT I AM A LICENSED PROFESSIONAL LAND SURVEYOR IN THE STATE OF UTAH AND THAT I HOLD CERTIFICATE NO. 8227228 IN ACCORDANCE WITH TITLE 58, CHAPTER 22, OF THE PROFESSIONAL ENGINEERS AND LAND SURVEYORS ACT; I FURTHER CERTIFY THAT BY AUTHORITY OF THE OWNERS I HAVE COMPLETED A SURVEY OF THE PROPERTY DESCRIBED ON THIS RECORD OF SURVEY PLAT IN ACCORDANCE WITH SECTION 17-23-20 AND HAVE VERIFIED ALL MEASUREMENTS; THAT THE REFERENCE MONUMENTS SHOWN ON THIS RECORD OF SURVEY PLAT ARE LOCATED AS INDICATED AND ARE SUFFICIENT TO RETRACE OR REESTABLISH THIS SURVEY; AND THAT THE INFORMATION SHOWN HEREIN IS SUFFICIENT TO ACCURATELY ESTABLISH THE LATERAL BOUNDARIES OF THE HEREIN DESCRIBED TRACT OF REAL PROPERTY.

SIGNED THIS 26TH DAY OF MAY, 2022.

PROFESSIONAL LAND SURVEYOR
5/28/2022
8227228
Klint H. Whitney
KLINT H. WHITNEY, PLS NO. 8227228

SCALE:	1:10_XREF
DATE:	5/26/2022
DESIGN:	
DRAWN:	KHW
CHECKED:	KHW
DWG.: R2001 - MISC SURVEY 02111 - ALEX CLARK SURVEY 02111 - ALEX CLARK SURVEY 02111 - ALEX CLARK SURVEY 02111	

REVISIONS	DESCRIPTION
DATE	

PROPERTY SURVEY FOR ALEX CLARK
1425 DOUGLAS DRIVE, OGDEN UTAH

GARDNER ENGINEERING
CIVIL - LAND PLANNING
MUNICIPAL - LAND SURVEYING

5150 SOUTH 375 EAST OGDEN, UT
OFFICE: 801.476.0202 FAX: 801.476.0066

S1
1