

DRAWING NUMBER
000738

PLAN HOLD CORPORATION - IRVINE, CALIFORNIA
RECORDER BY NUMBER 0754P

DRAWING NUMBER
000738



PLAN HOLD CORPORATION - IRVINE, CALIFORNIA
RECORDER BY NUMBER 0754P

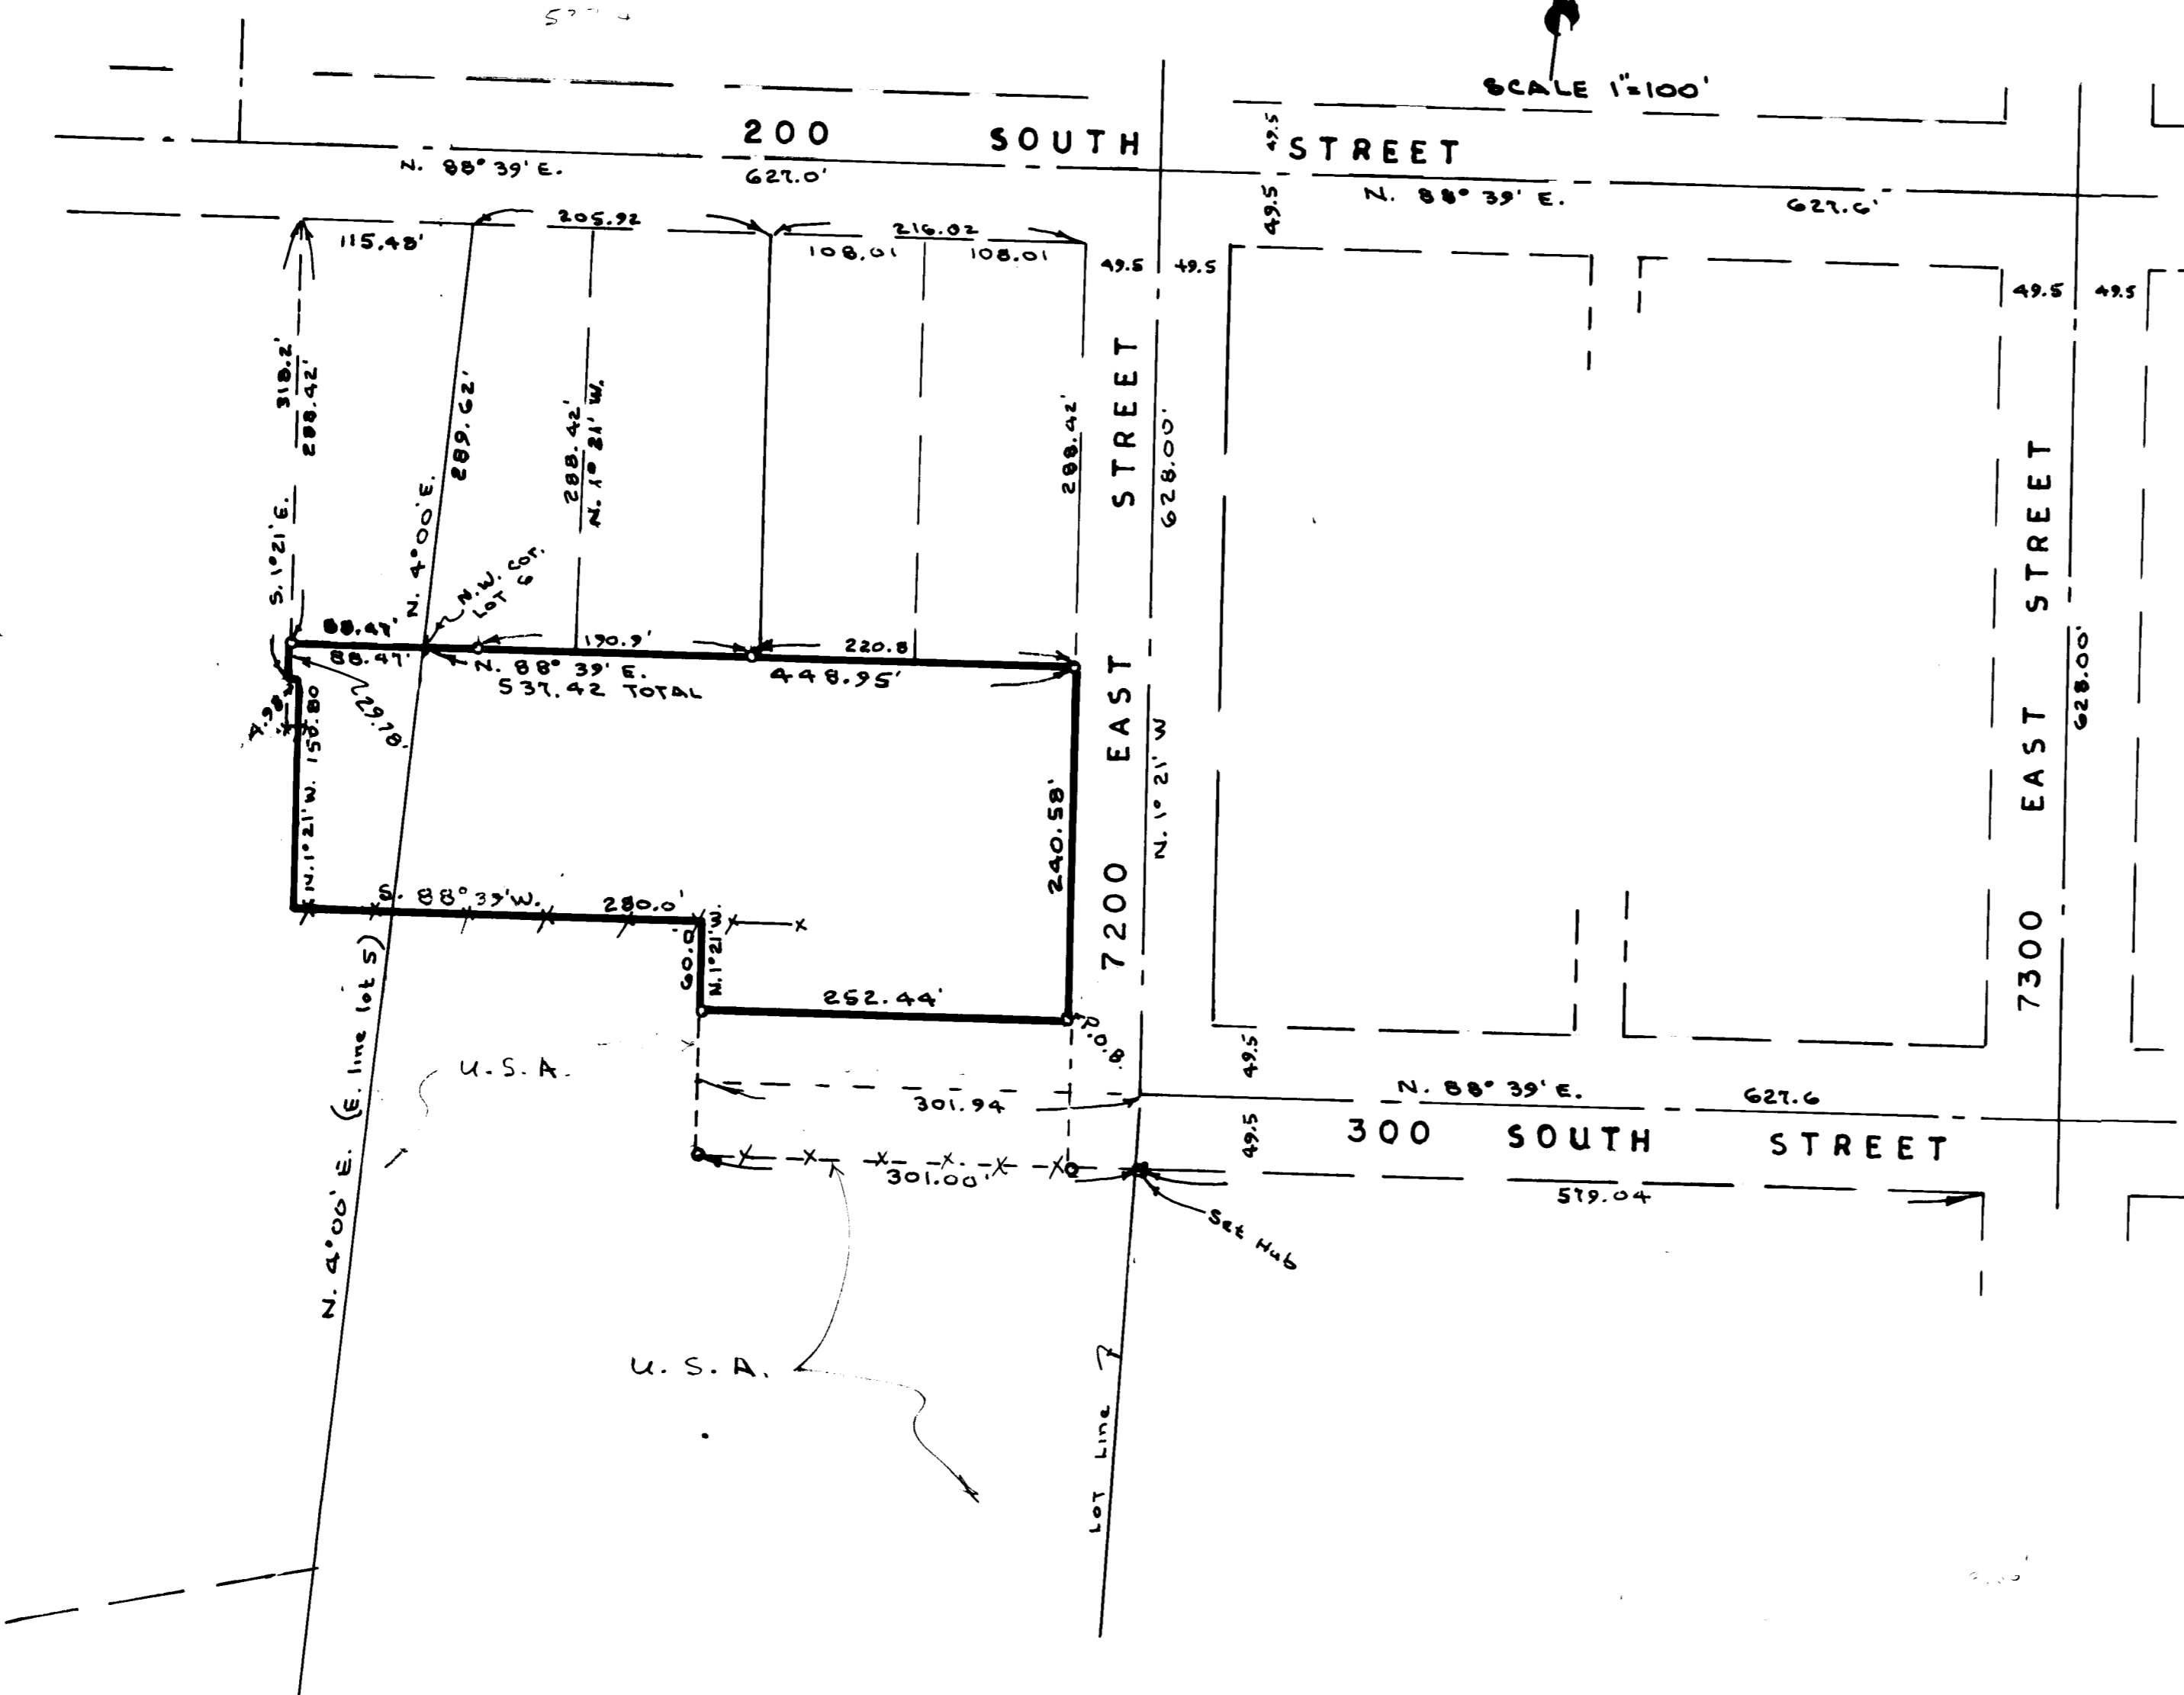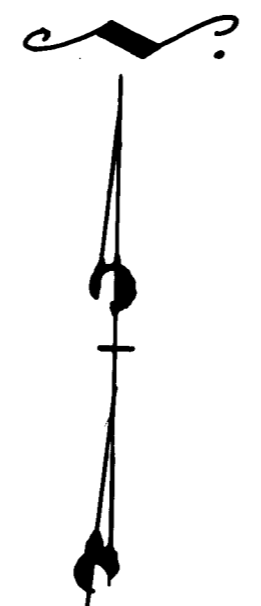

SURVEYORS CERTIFICATE

I, Larry M. Buttars, a registered Land Surveyor as prescribed by the laws of the State of Utah, and holding licence No. 2596, do hereby certify that I made a survey of the herein described property and the Plat hereon is a true and correct representation of said survey.

Date: 5-26-92 Sign: *Larry M. Buttars*

DESCRIPTION

A part of lots 5 and G, Block 1, Plat "C" Huntsville Survey: Beginning at the S. E. corner of said lot G, and running thence S. 88° 39' W. 282.44 ft. thence N. 1° 21' W. 60.0 ft. along Pineview reservoir line, thence S. 88° 39' W. 260.0 ft. along said line, thence N. 1° 21' W. 150.80 ft., thence S. 88° 39' W. 4.98 ft. to a point 115.48 ft. S. 88° 39' W. and 318.2 ft. S. 1° 21' E. of the N.E. corner of lot 5, thence N. 1° 21' W. 29.18 ft., thence N. 88° 39' E. along the North line of lot G, and the North line of lot G extended 537.42 ft. to the North east corner of Lot G, thence S. 1° 21' E. 240.58 ft. to the point of beginning.

NARRATIVE

The purpose of this Survey was to establish the North line of property for fencing. Huntsville Townsite Survey of record was used to establish bearing base. Ownership of the abandoned 300 South St., South of this property, was not established.

LEGEND

- Set 3/4" x 24" re-bar with plastic cap stamped L. Buttars R.L.S. 2596
- Set P.K. nail with ribbon

BUTTARS SURVEYING
1815 26TH STREET OGDEN, UT. 84401
PHONE 392-5291

CLIENT: D. W. BELL

SURVEY LOCATION:
N.W. 1/4 SEC. 18, T. 6N., R. 2E., S. 18B#M.
HUNTSVILLE SURVEY, WEBER COUNTY

SURVEY DATE: 5-23-92

RECEIVED
AUG 11 1992
Weber County Surveyor

000738