


BOUNDARY DESCRIPTION

ALL OF LOT 4, JUMPOFF CANYON SUBDIVISION NO. 1, OGDENCITY WEBER COUNTY, UTAH

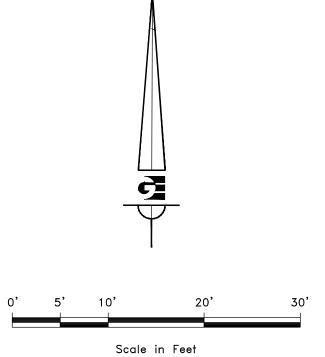

1" = 10'

LEGEND

OGDEN CITY SURVEY MONUMENT AS NOTED

O SET 24" REBAR AND CAP MARKED GARDNER ENGINEERING

SUBJECT PROPERTY BOUNDARY

LOT LINE

— — ADJACENT PARCEL

——— SECTION LINE

---- EASEMENT

NARRATIVE

THE PURPOSE OF THIS SURVEY WAS TO ESTABLISH AND SET THE PROPERTY CORNERS OF THE PARCEL AS SHOWN AND DESCRIBED HEREON. THE SURVEY WAS ORDERED BY MARLENE LEWELLYN. THE BASIS OF BEARING IS THE MONUMENTED LINE FROM THE OGDEN CITY SURVEY MONUMENT FOUND AT THE INTERSECTION OF SHARRON COURT AND ECCLES AVENUE TO THE FOUND OGDEN CITY SURVEY MONUMENT AT THE INTERSECTION OF SHARRON COURT AND VAN BUREN AVENUE, WHICH BEARS SOUTH 84°11'52" WEST, WEBER COUNTY, UTAH NORTH, NAD 83 STATE PLANE GRID BEARING. THE BOUNDARY WAS DETERMINED BY WARRANTY DEED RECORDED AS ENTRY NUMBER 2072928, AND DEEDS OF ADJOINING PROPERTY OWNERS. THE DEDICATED PLAT OF JUMPOFF CANYON SUBDIVISION NO. 1 WAS ALSO USED TO DETERMINE BOUNDARY LOCATION ALONG WITH THE FOUND MONUMENTS AS SHOWN AND DESCRIBED HEREON.

SURVEYOR'S CERTIFICATE

I, KLINT H. WHITNEY, DO HEREBY CERTIFY THAT I AM A LICENSED PROFESSIONAL LAND SURVEYOR IN THE STATE OF UTAH AND THAT I HOLD CERTIFICATE NO. 8227228 IN ACCORDANCE WITH TITLE 58, CHAPTER 22, OF THE PROFESSIONAL ENGINEERS AND LAND SURVEYORS ACT; I FURTHER CERTIFY THAT BY AUTHORITY OF THE OWNERS I HAVE COMPLETED A SURVEY OF THE PROPERTY DESCRIBED ON THIS RECORD OF SURVEY PLAT IN ACCORDANCE WITH SECTION 17-23-20 AND HAVE VERIFIED ALL MEASUREMENTS; THAT THE REFERENCE MONUMENTS SHOWN ON THIS RECORD OF SURVEY PLAT ARE LOCATED AS INDICATED AND ARE SUFFICIENT TO RETRACE OR REESTABLISH THIS SURVEY; AND THAT THE INFORMATION SHOWN HEREIN IS SUFFICIENT TO ACCURATELY ESTABLISH THE LATERAL BOUNDARIES OF THE HEREIN DESCRIBED TRACT OF REAL PROPERT

SIGNED THIS 28TH DAY OF OCTO

	T H. WHITNEY, PLS NO. 8227228
	/ /