



DETAIL SUBJECT PARCEL 1

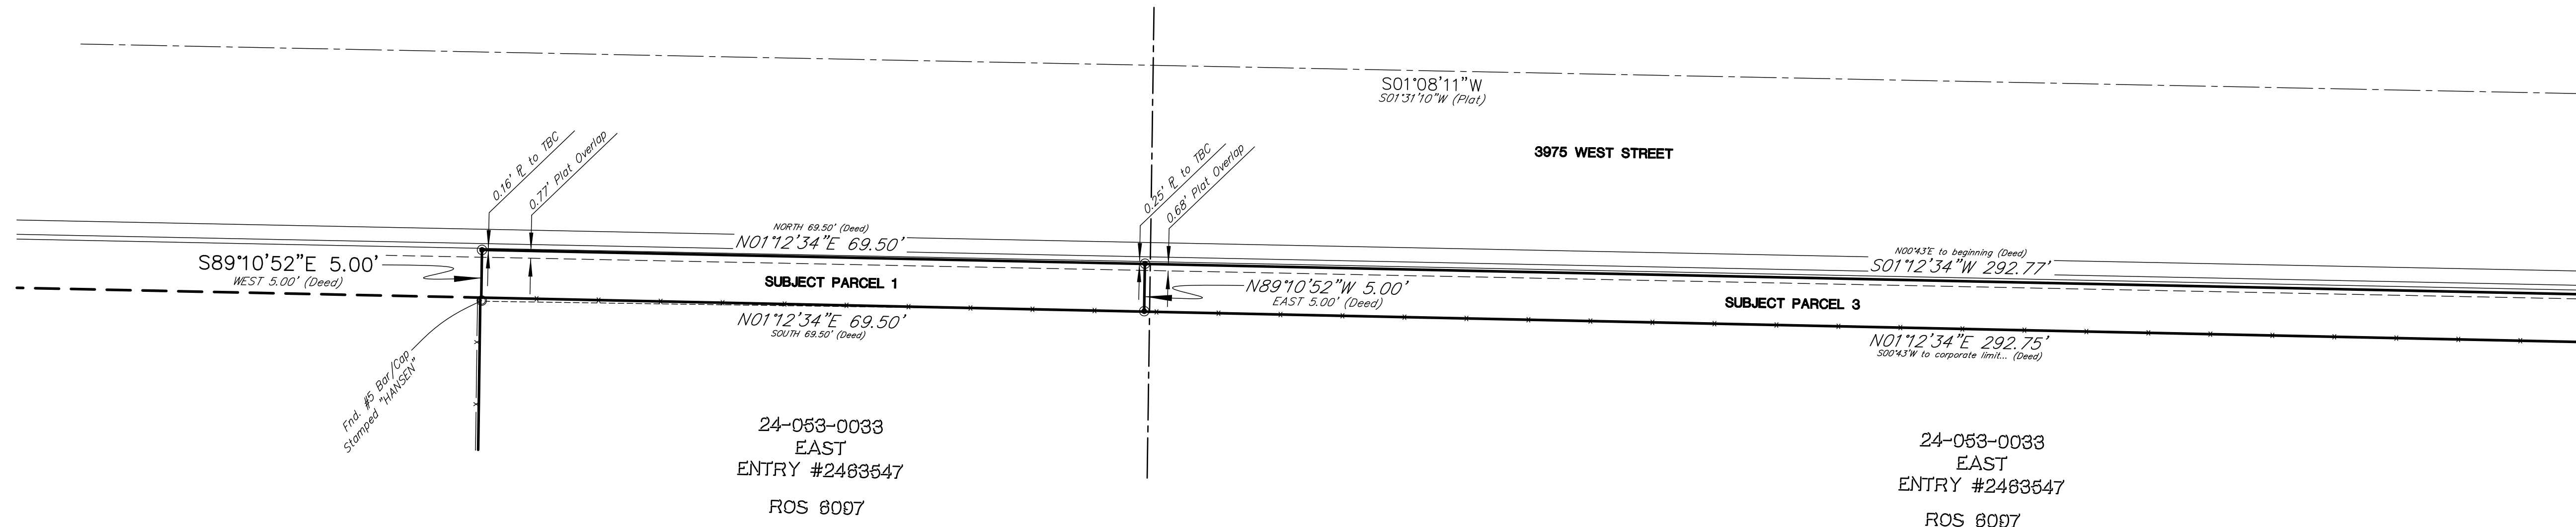

SCALE OF FEET
10 0 10 20

LEGEND


- REFERENCE MONUMENT & MEASURED MONUMENT LINE
- 28 28 = CALCULATED SECTION CORNER & SECTION LINE
- 32 33 = BOUNDARY LINE
- RIGHT OF WAY LINES
- RECORD OF SURVEY 5001 ("CONGERS SURVEY")
- ADJOINING PARCELS DEED LINES
- DIMENSION LINES
- 28 27 = FOUND SECTION MONUMENT
- 33 34

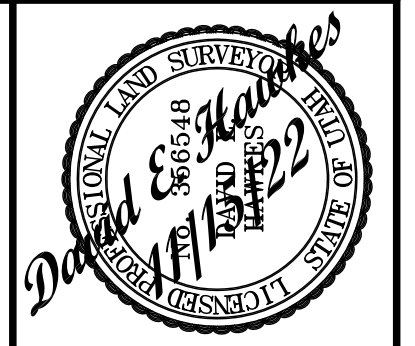


DATE: 10-27-21
 UPDATED: 11-15-22
 SCALE: 1"=40'
 PROJECT NUMBER: 2155001

RECORD OF SURVEY OF WEBER COUNTY
 TAX PARCELS 19-025-0021, 24-053-0012, -0032
 LYING AND SITUATE IN THE SOUTHWEST QUARTER OF SECTION 28,
 THE NORTHWEST QUARTER OF SECTION 33
 TOWNSHIP 7 NORTH, RANGE 2 WEST, SALT LAKE BASE AND MERIDIAN

DETAIL SUBJECT PARCEL 3

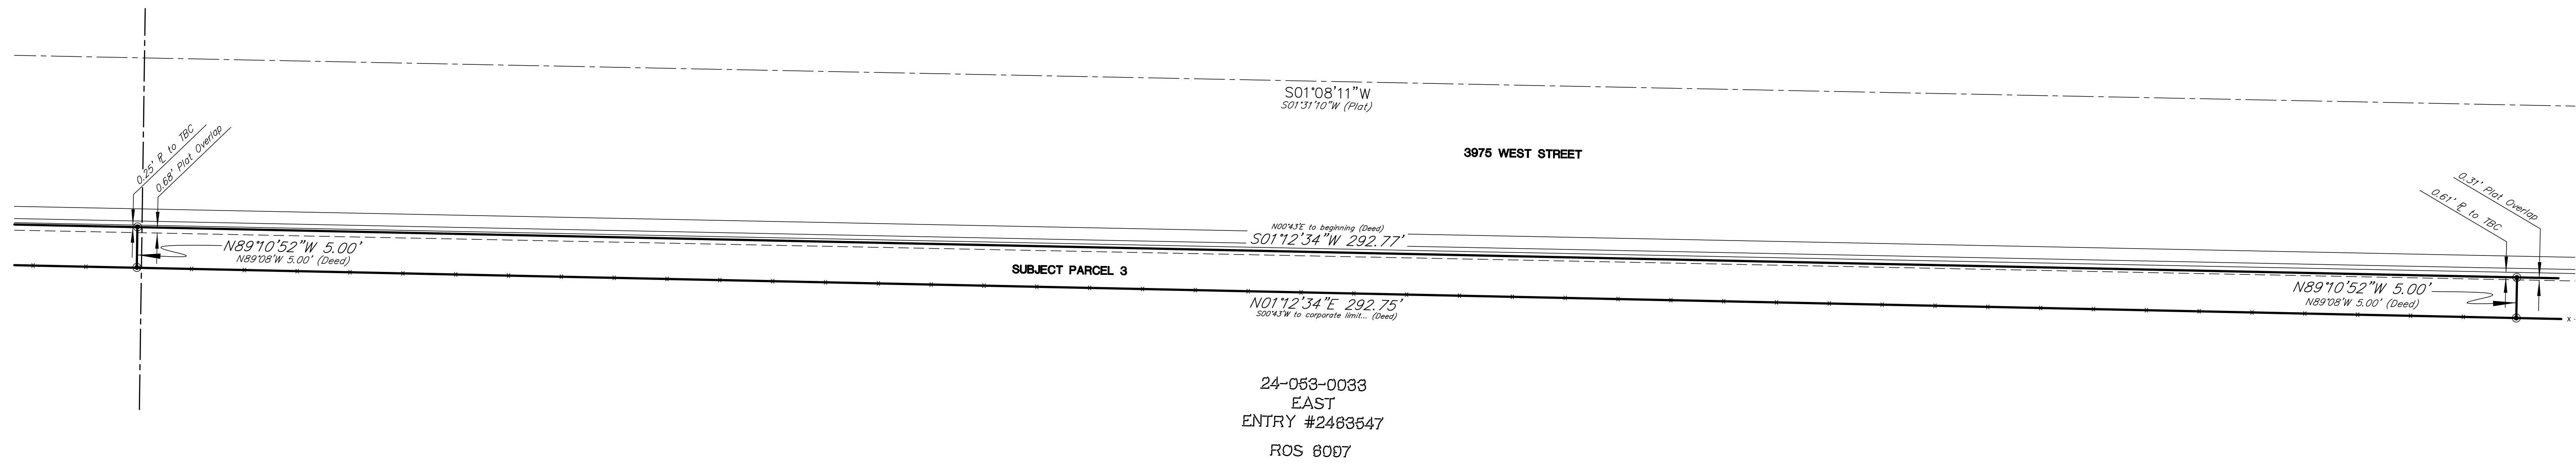

DETAIL SUBJECT PARCEL 2

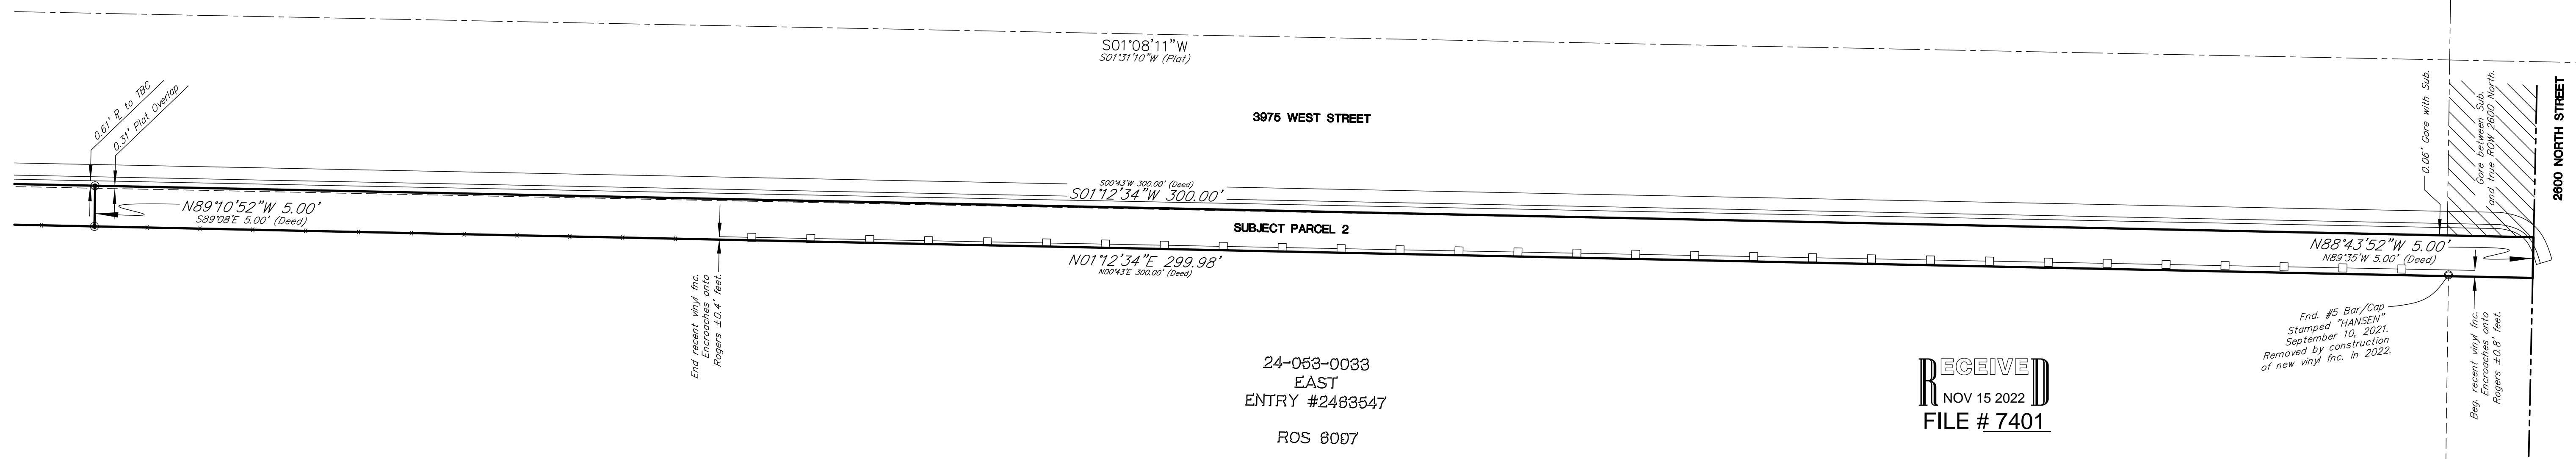

RECEIVED
 NOV 15 2022
 FILE # 7401

Boundary Consultants
 Professional Land Surveyors
 5554 West 2425 North, Hooper, Utah
 801-792-1569
 dave@boundaryconsultants.biz

DESIGNED	DEH
DRAWN	DEH
CHECKED	DEH
SHEET	2
OF	2