

NARRATIVE

THIS SURVEY WAS REQUESTED BY MRS. COLLEEN BOTT FOR THE PURPOSE OR RE-ESTABLISHING THE BOUNDARY OF THE HEREON DESCRIBED PARCELS OF GROUND


BRASS CAP STREET MONUMENTS WERE FOUND IN THE INTERSECTIONS OF WASHINGTON BOULEVARD AND KIESEL AVENUE AT 15TH STREET AND 17TH STREET.

A LINE BEARING NORTH 0°58'00" EAST BETWEEN SAID BRASS CAP MONUMENTS AT THE INTERSECTION OF WASHINGTON BOULEVARD AND 15TH STREET AND WASHINGTON BOULEVARD AND 17TH STREET AS SHOWN HEREON.


A PROPERTY AND TOPOGRAPHICAL SURVEY PREPARED BY GREAT BASIN ENGINEERING FOR THE L.D.S. CHURCH, DATED OCTOBER 29, 1999AND FILED NOVEMBER 16, 1999; AND THE OGDEN CITY SURVEY PLAT 6484 WERE USED AS REFERENCE FOR THIS SURVEY.

BOUNDARIES OF THE PARCELS WERE ESTABLISHED BY INFORMATION OF RECORD AND FOUND EVIDENCE OF OCCUPATION ON THE GROUND.

PROPERTY CORNERS ARE SET WITH A %" REBAR AND PLASTIC CAP STAMPED "REEVE & ASSOCIATES". ALL FRONT LOT CORNERS WERE SET WITH A LEAD PLUG IN THE TOP BACK OF CURB AT THE EXTENSION OF THE SIDE LOT LINES.

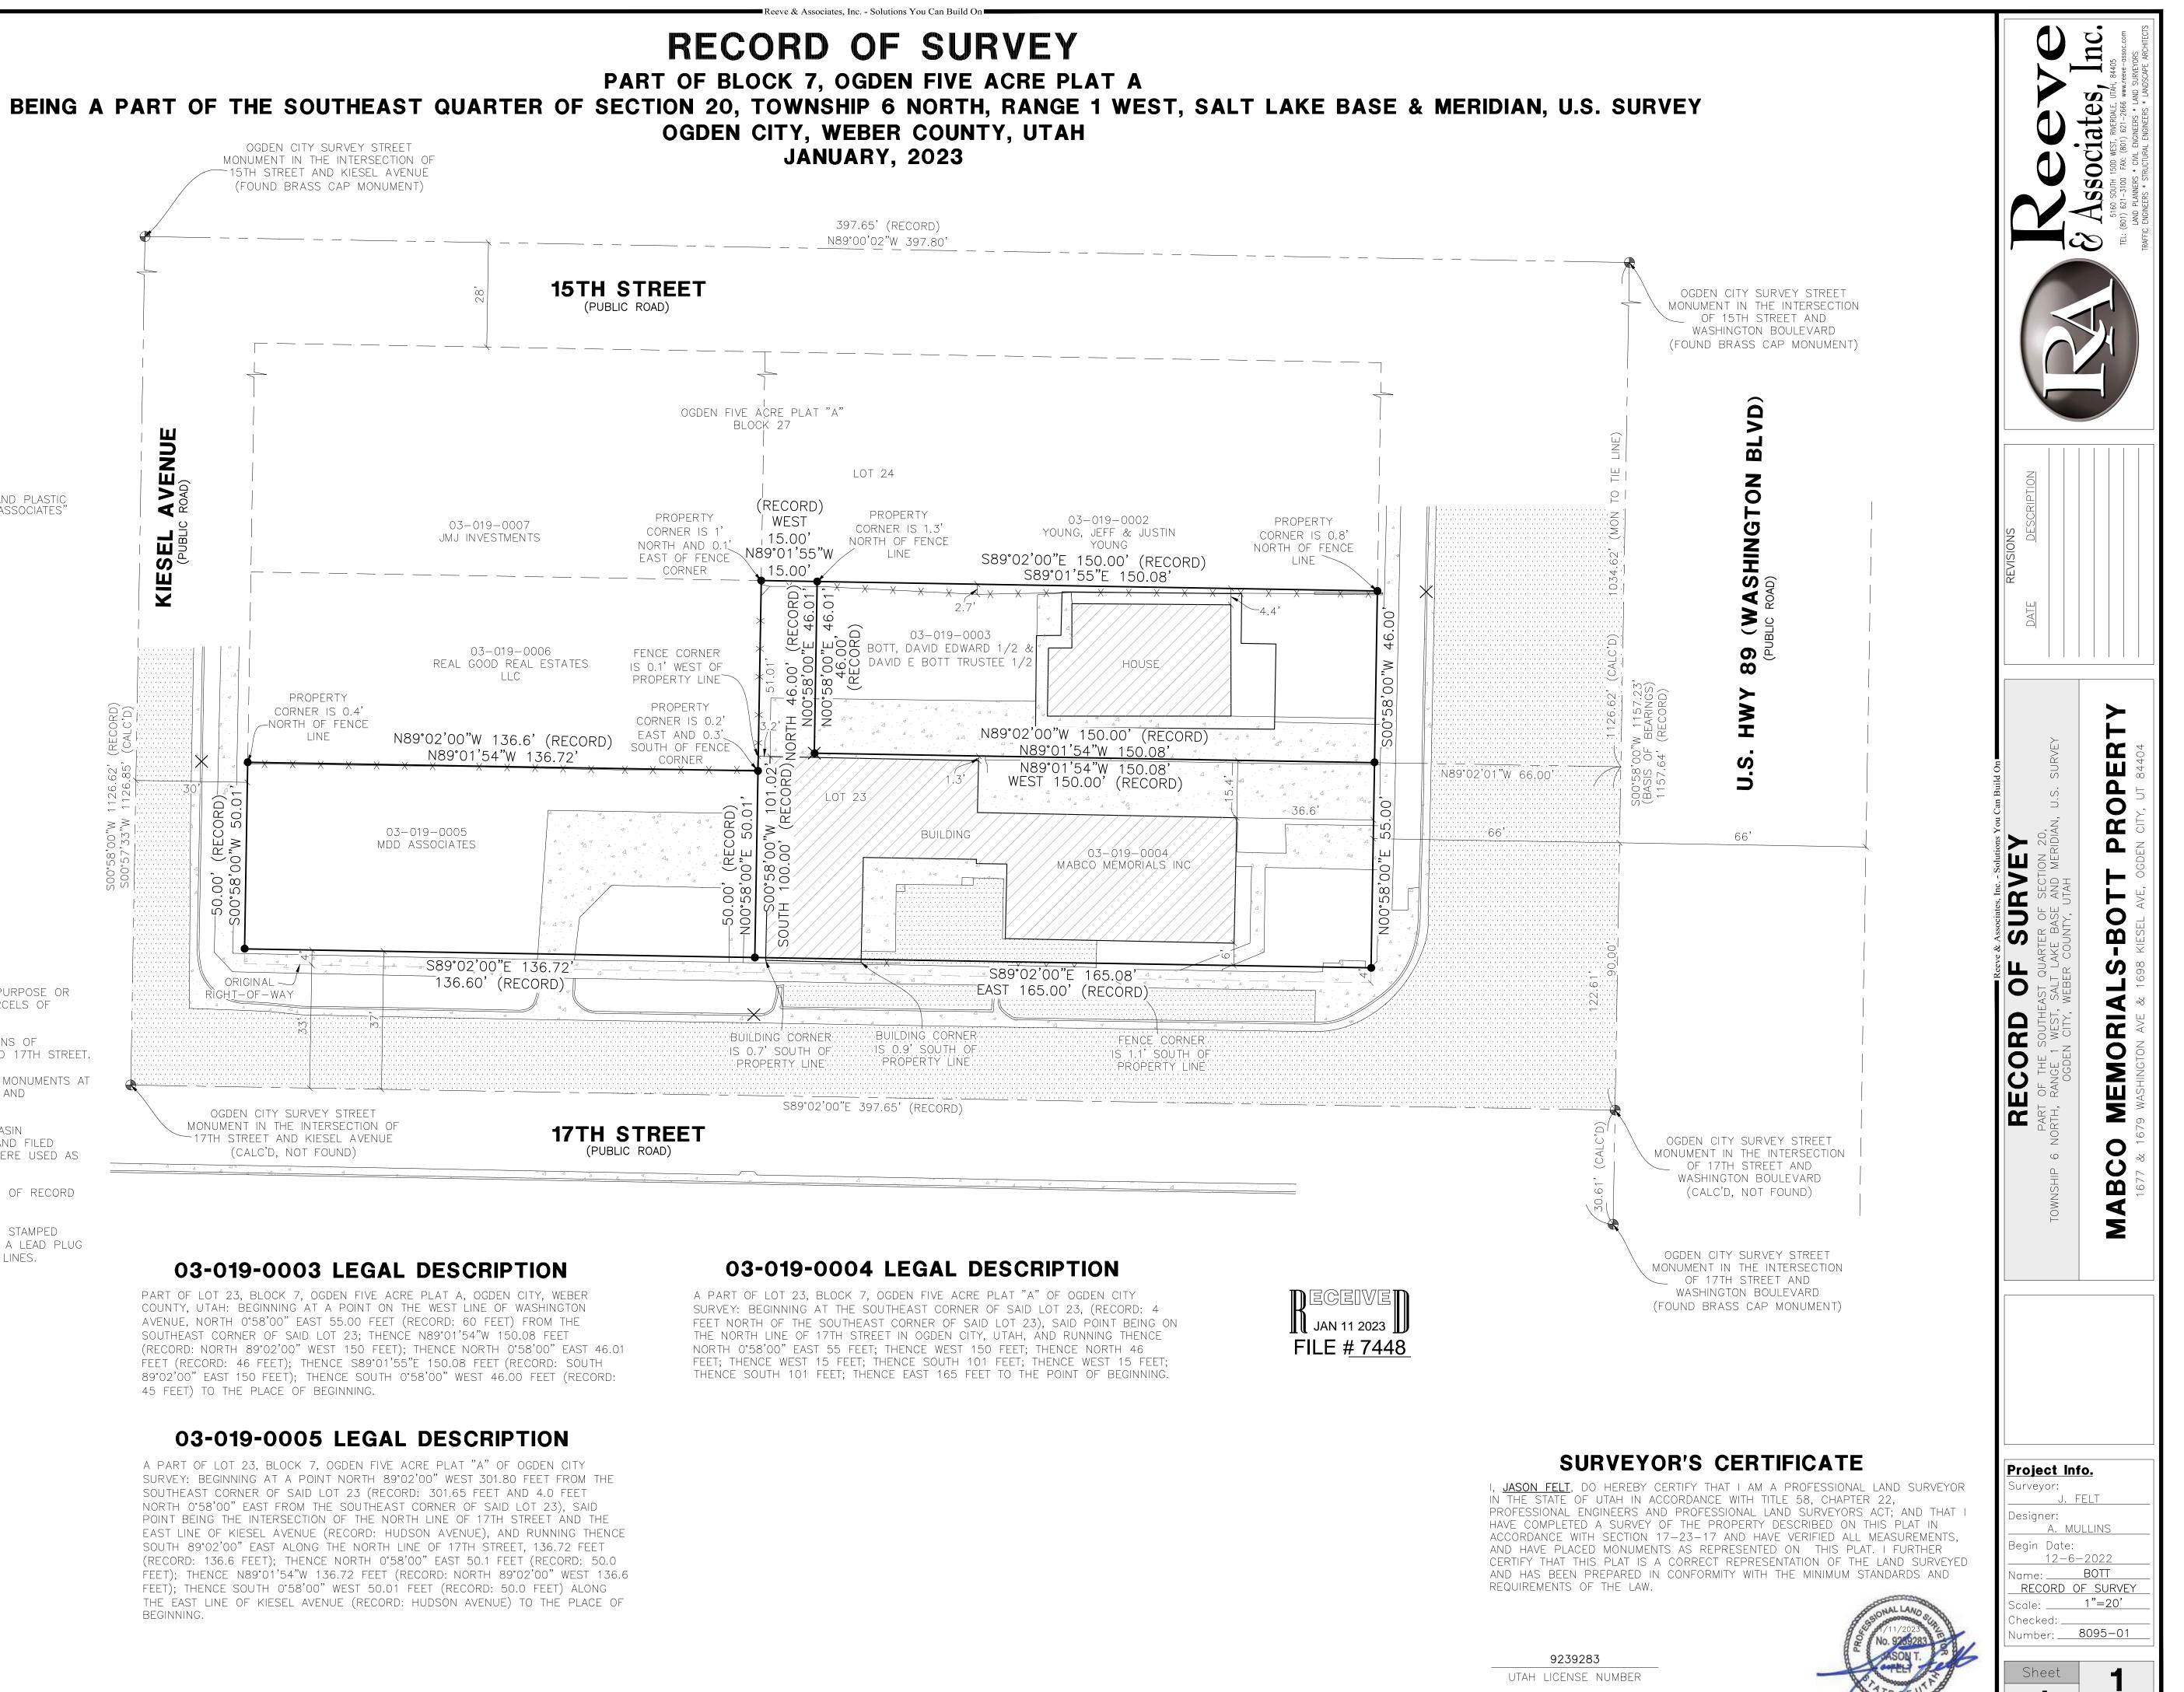

Reeve & Associates, Inc. - Solutions You Can Build On

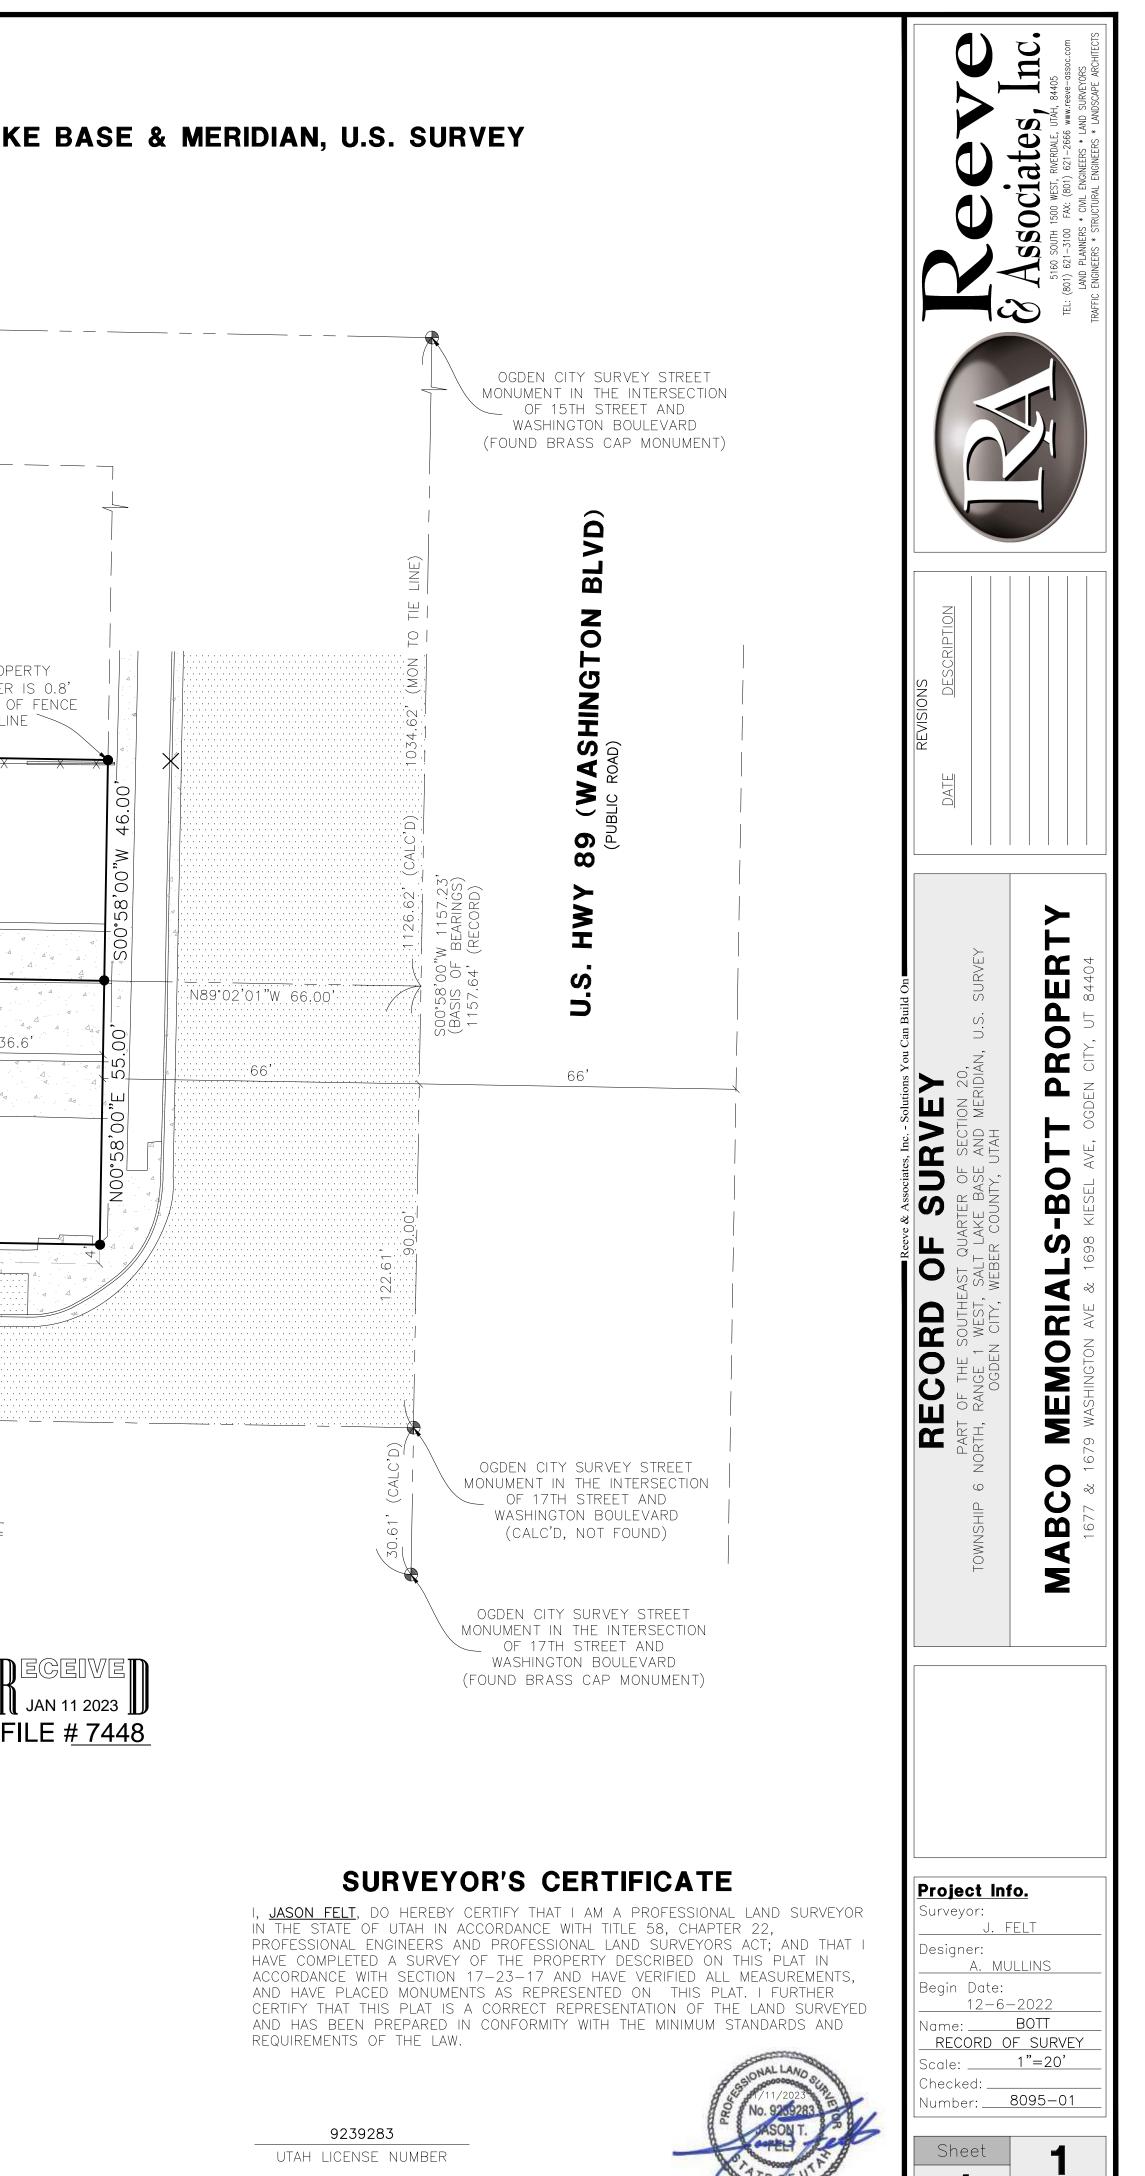

Sheets