


SOUTH 17 FEET OF LOT 24 & ALL OF LOT 25 BLOCK 1 ROSEDALE ADDITION ACCORDING TO THE OFFICIAL PLAT THEREOF ON FILE AND OF RECORD IN THE SALT LAKE COUNTY RECORDERS OFFICE.

RUNNING THENCE EAST 8 FEET; THENCE SOUTH 38 FEET; THENCE WEST 8 FEET; THENCE NORTH 38

PARCELS AS SHOWN AND DESCRIBED HEREON. THE SURVEY WAS ORDERED BY WAYNE BOYDSTUN. THE BASIS OF BEARING IS THE LINE BETWEEN TO CENTERLINE MONUMENT LOCATED AT THE INTERSECTIONS OF HOLLYWOOD AVE. AND 600 EAST, AND HOLLYWOOD AVE AND 600 EAST, WHICH BEARS SOUTH 00°12'43" WEST, SALT LAKE COUNTY, UTAH NORTH, NAD 83 STATE PLANE GRID BEARING. THE BOUNDARY WAS DETERMINED BUY SPECIAL WARRANTY DEED RECORDED AS ENTRY NUMBER 13994579, AND DEEDS OF ADJOINING PROPERTY OWNERS. THE DEDICATED PLAT OF ROSEDALE ADDITION WAS ALSO USED TO DETERMINE BOUNDARY LOCATION ALONG WITH THE

I, KLINT H. WHITNEY, DO HEREBY CERTIFY THAT I AM A LICENSED PROFESSIONAL LAND SURVEYOR IN THE STATE OF UTAH AND THAT I HOLD CERTIFICATE NO. 8227228 IN ACCORDANCE WITH TITLE 58, CHAPTER 22, OF THE PROFESSIONAL ENGINEERS AND LAND SURVEYORS ACT; I FURTHER CERTIFY THAT BY AUTHORITY OF THE OWNERS I HAVE COMPLETED A SURVEY OF THE PROPERTY DESCRIBED ON THIS RECORD OF SURVEY PLAT IN ACCORDANCE WITH SECTION 17-23-20 AND HAVE VERIFIED ALL MEASUREMENTS; THAT THE REFERENCE MONUMENTS SHOWN ON THIS RECORD OF SURVEY PLAT ARE LOCATED AS INDICATED AND ARE SUFFICIENT TO RETRACE OR REESTABLISH THIS SURVEY; AND THAT THE INFORMATION SHOWN HEREIN IS SUFFICIENT TO ACCURATELY ESTABLISH THE LATERAL BOUNDARIES OF THE HEREIN DESCRIBED TRACT OF REAL PROPERTY.

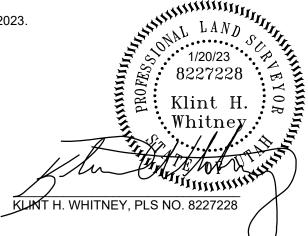



009