

ALL OF LOT 45 & THE SOUTH 15 FT. OF LOT 46, BLOCK 21, LAKEVIEW ADDITION, OGDEN CITY, WEBER COUNTY, UTAH.

NARRATIVE:

SURVEY WAS DONE IN PREPARATION FOR FENCING. THE CENTER LINE NAILS AND LEAD PLUG SHOWN WERE USED FOR SURVEY CONTROL. THEY WERE VERIFIED BY CURB SPLITS AT 36th STREET AND 37th STREET.


I, GLENN RAVENBERG, DO HEREBY CERTIFY THAT I AM A REGISTERED LAND SURVEYOR, AND THAT I HOLD CERTIFICATE NO. 3835, AS PRESCRIBED BY THE LAWS OF THE STATE OF UTAH, AND THAT I HAVE MADE A SURVEY OF THE ABOVE DESCRIBED PROPERTY. I FURTHER CERTIFY THAT ABOVE PLAT CORRECTLY SHOWS THE TRUE DIMENSIONS OF THE PROPERTY SURVEYED.

JULY 23, 1992

*Glenn Ravenberg*  
GLENN RAVENBERG

RECEIVED  
SEP 25 1992

Weber County Surveyor

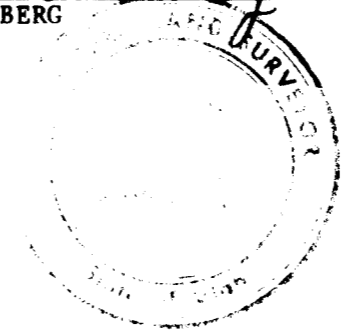

**INTERMOUNTAIN SURVEYING**  
Layton, Utah 84041 (801) 544-1170

PROPERTY SURVEY  
FOR  
VICKIE VERNIEUW  
PART OF LOTS 45 & 46, BLOCK 21, LAKEVIEW ADDITION

JULY 23, 1992 1" = 20' PS-92-83