

SCALE 1" = 40'

• SET FW MARK

A PART OF THE SOUTHWEST QUARTER OF SECTION 5, T9N, R14E, SLAMM, U.S. SURVEY, BEGINNING AT A POINT ON THE EAST LINE OF PACIFIC AVENUE, WHICH IS SOUTH 89°49' 52.11" EAST 314.41 FT. FROM THE S.W. CORNER OF THE SECTION 5, T9N, R14E, SLAMM, U.S. SURVEY, 3°11'14" EAST 218.20 FT. ALONG SAID EAST LINE OF PACIFIC AVENUE, THENCE NORTH 82°26'03" EAST (83°02'20" EAST) 533.54 FT., THENCE SOUTH 82°26'03" WEST (NORTH 82°26'03" WEST) 533.54 FT. (89°34'51" WEST) TO THE POINT OF BEGINNING. CONTAINS 2.398 ACRES.


NARRATIVE:


I, GLENN MAYNERS, DO HEREBY CERTIFY THAT I AM A REGISTERED LAND SURVEYOR AND THAT I HOLD CERTIFICATE NO. 3835 AS PRESCRIBED BY THE LAWS OF THE STATE OF UTAH, AND THAT I HAVE MADE A SURVEY OF THE ABOVE DESCRIBED PROPERTY. I CERTIFY THAT THE ABOVE PLAT CORRECTLY SHOWS THE TRUE DIMENSIONS OF THE PROPERTY SURVEYED.

JULY 29, 1992

Glenn Mayners
GLENN MAYNERS

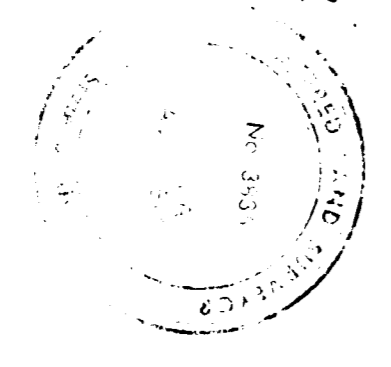

RECEIVED
SEP 25 1992
Weber County Survey

INTERMOUNTAIN SURVEYING
BLM 34430
PROPERTY SURVEY
FOR
ALL STATE INSURANCE
PART OF THE S.W. 1/4 OF SEC. 5, T9N, R14E, SLAMM
JULY 29 1992
1" = 40'
FS-32-30

00751